


E-1

28.10.2020

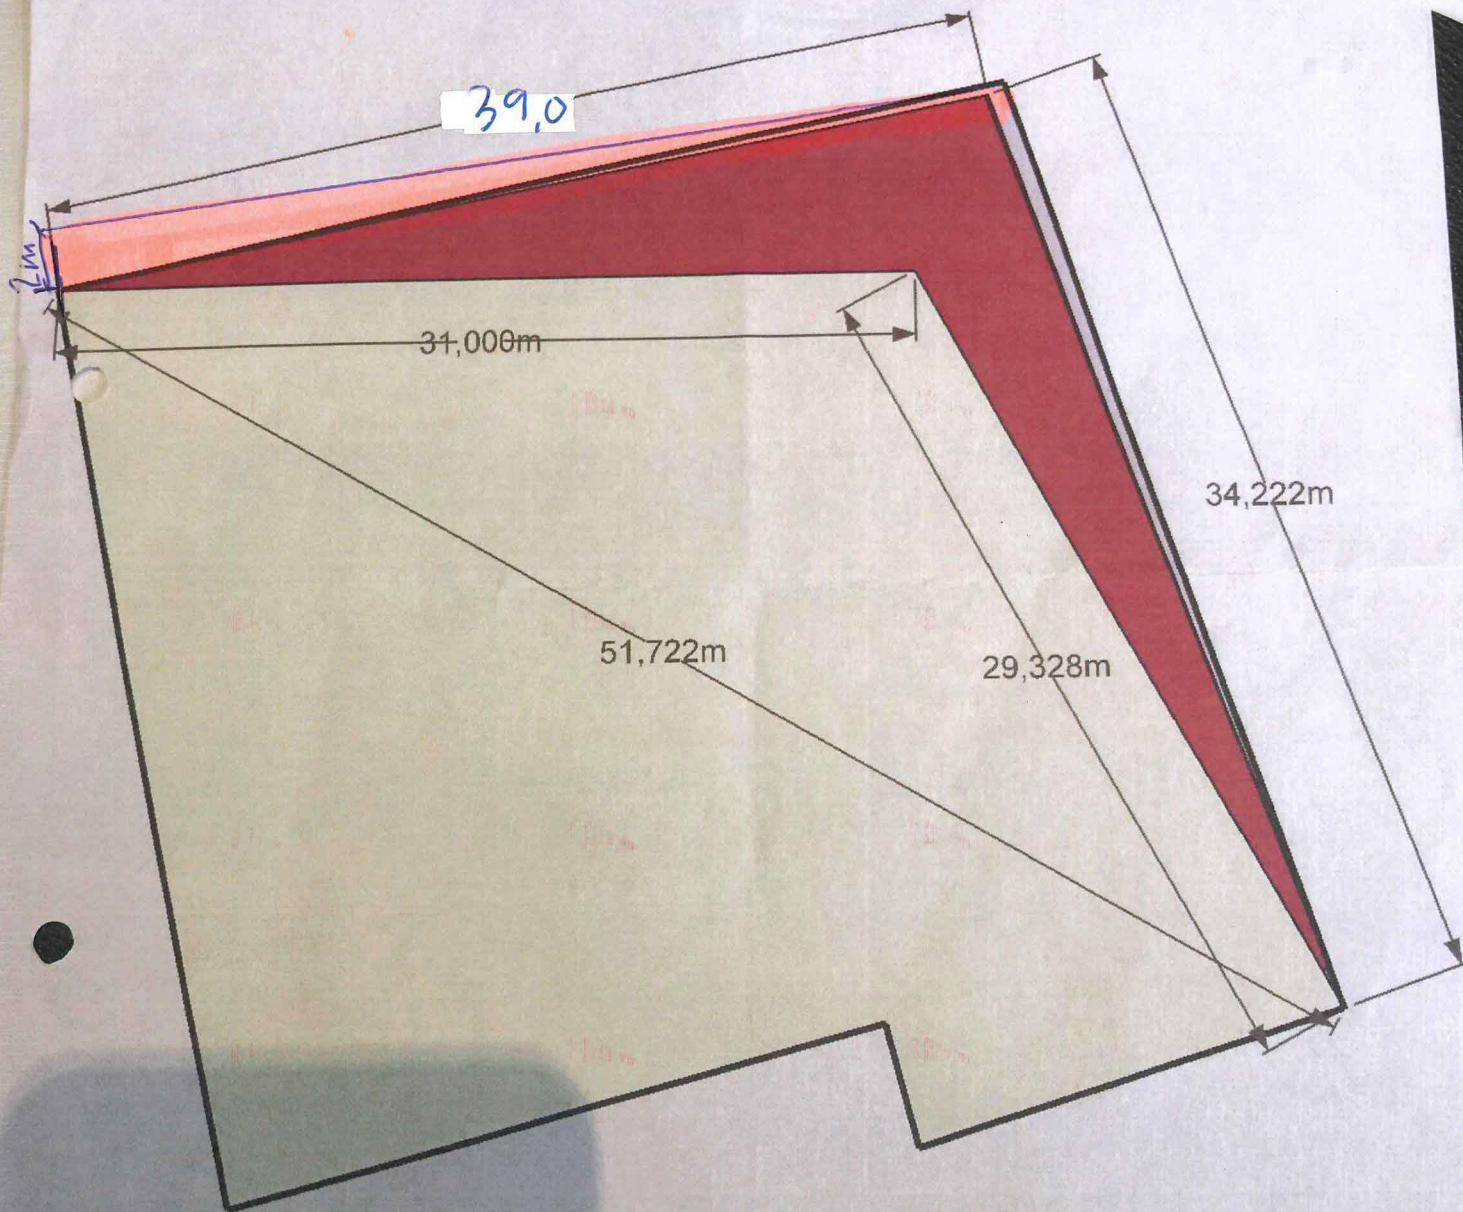

E-2



Søk

FINN ▼




Kart

Kart HD

Flyfoto

Hybrid

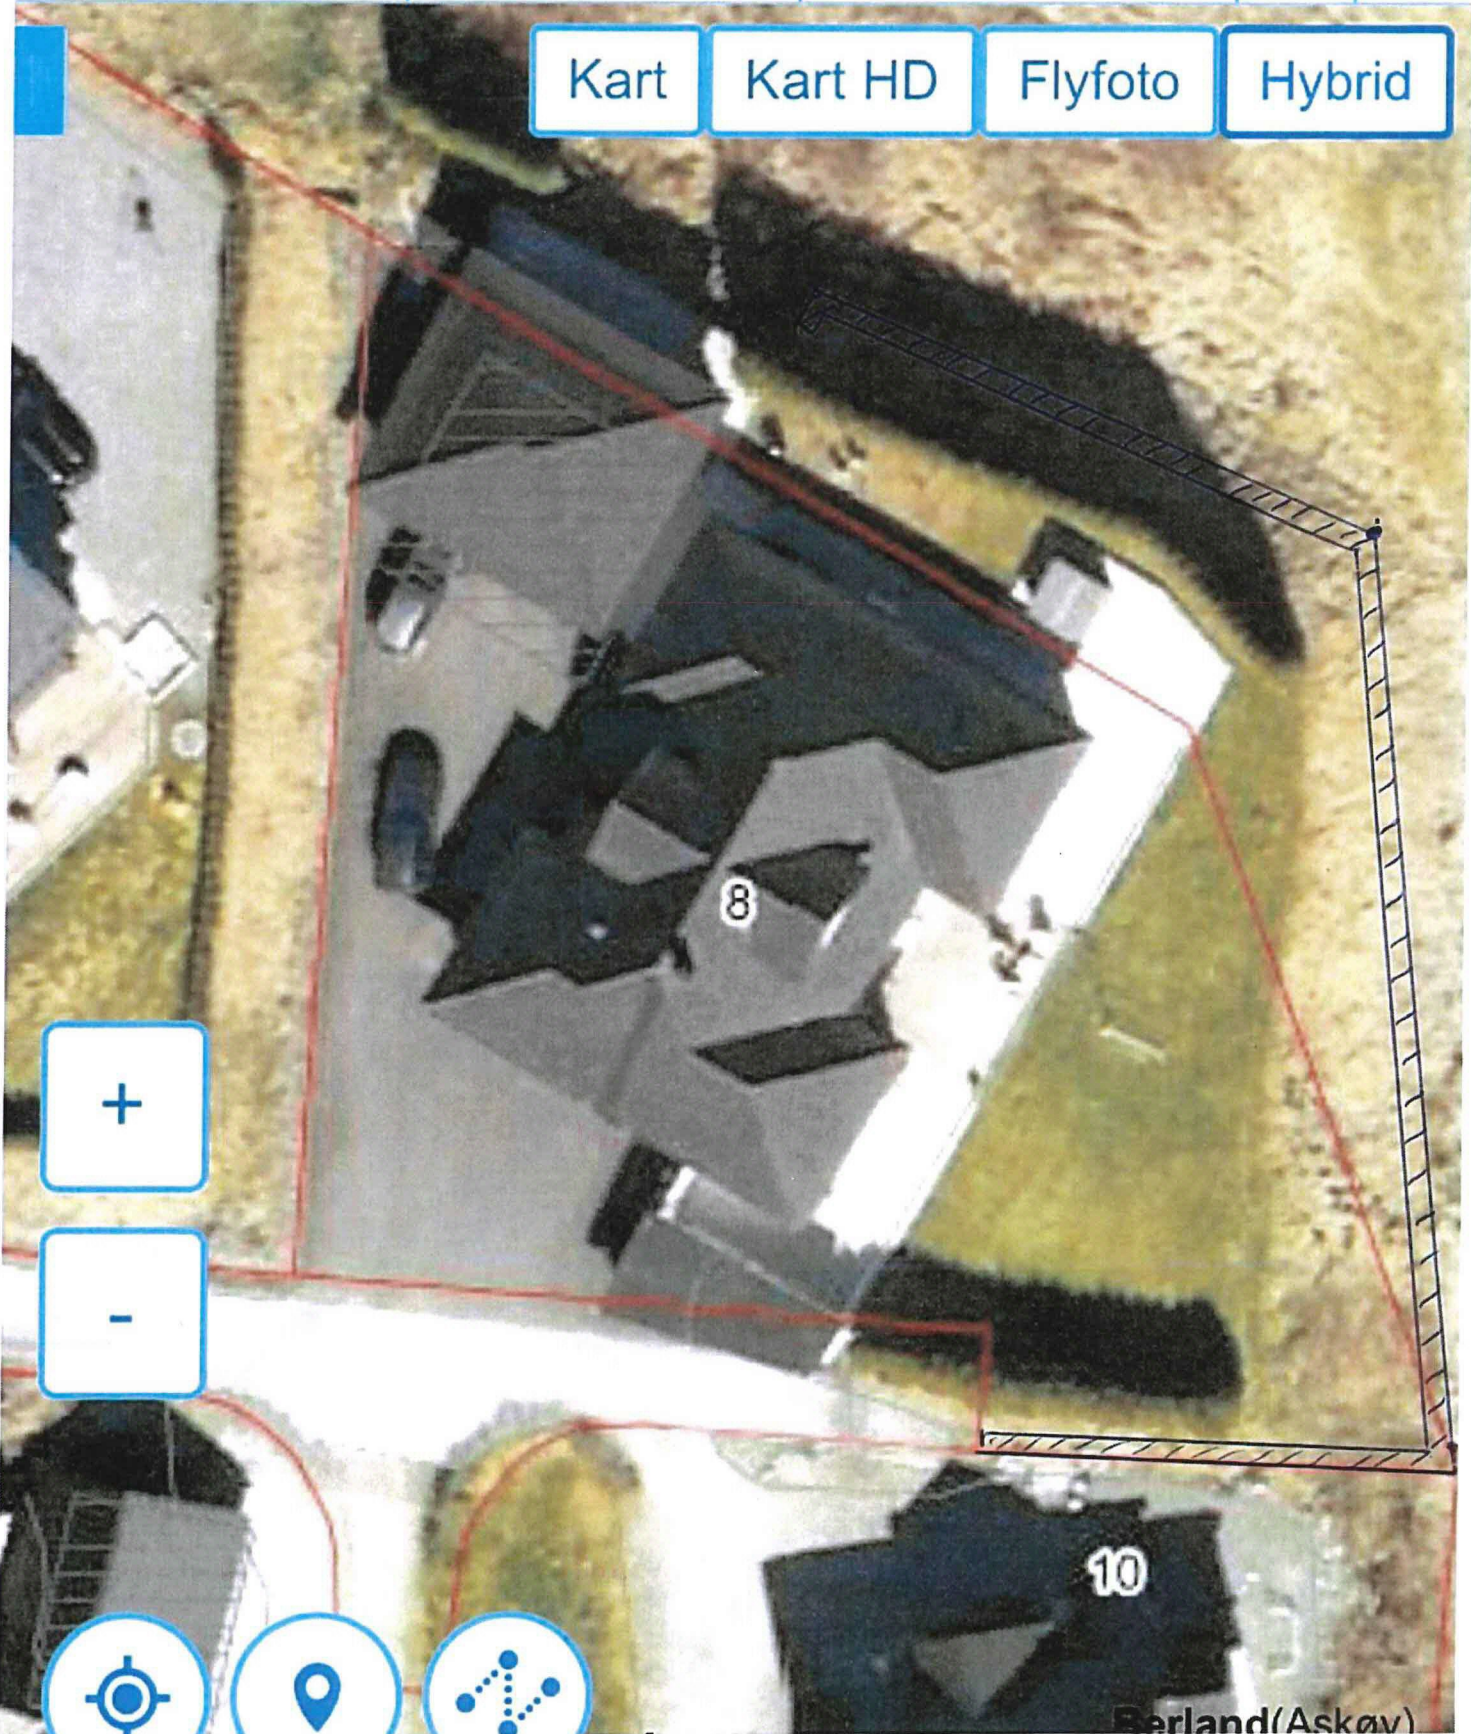

Berland(Askov)

E-3

