



1 Fasade mot Vest - Eksisterende
1 : 200

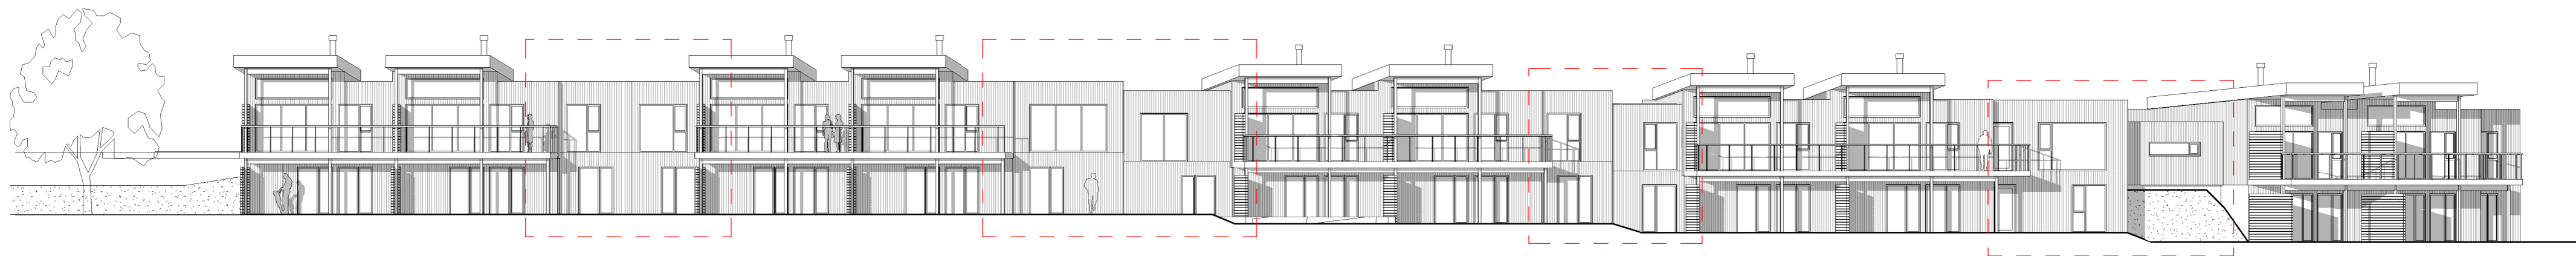


2 Fasade mot Vest - Ny
1 : 200

| REV. | DATE | BESKRIVELSE | TEGN. | KONTR. |
|------------------------|------------------------------------|--|-------|--------|
| PROSJEKTNR: 19004 | | ARKITEKTORET BØRTVEIT & CARLSEN AS HAGELLIA 6 · 5914 ISDALSTØ TELEFON 400 41 614 post@arkbc.no | | |
| TEGNET AV: MMC | | | | |
| KONTR. AV: PJC | | | | |
| ARKISTORRELSE: A2 | TILTAKSHAVER: Sameiget Orresteinen | GNR. / BNR: Gnr. 185/Bnr.319 Tomannsboliger - Orresteinen | | |
| MALESTOKK: 1 : 200 | DATO: 15.08.19 | | | |
| Reguleringsplan | | TEGNINGSNOMMER: A1-501 | | |
| TEGNINGSNOMMER: A1-501 | | TEGNINGSNAVN: Fasader | | |

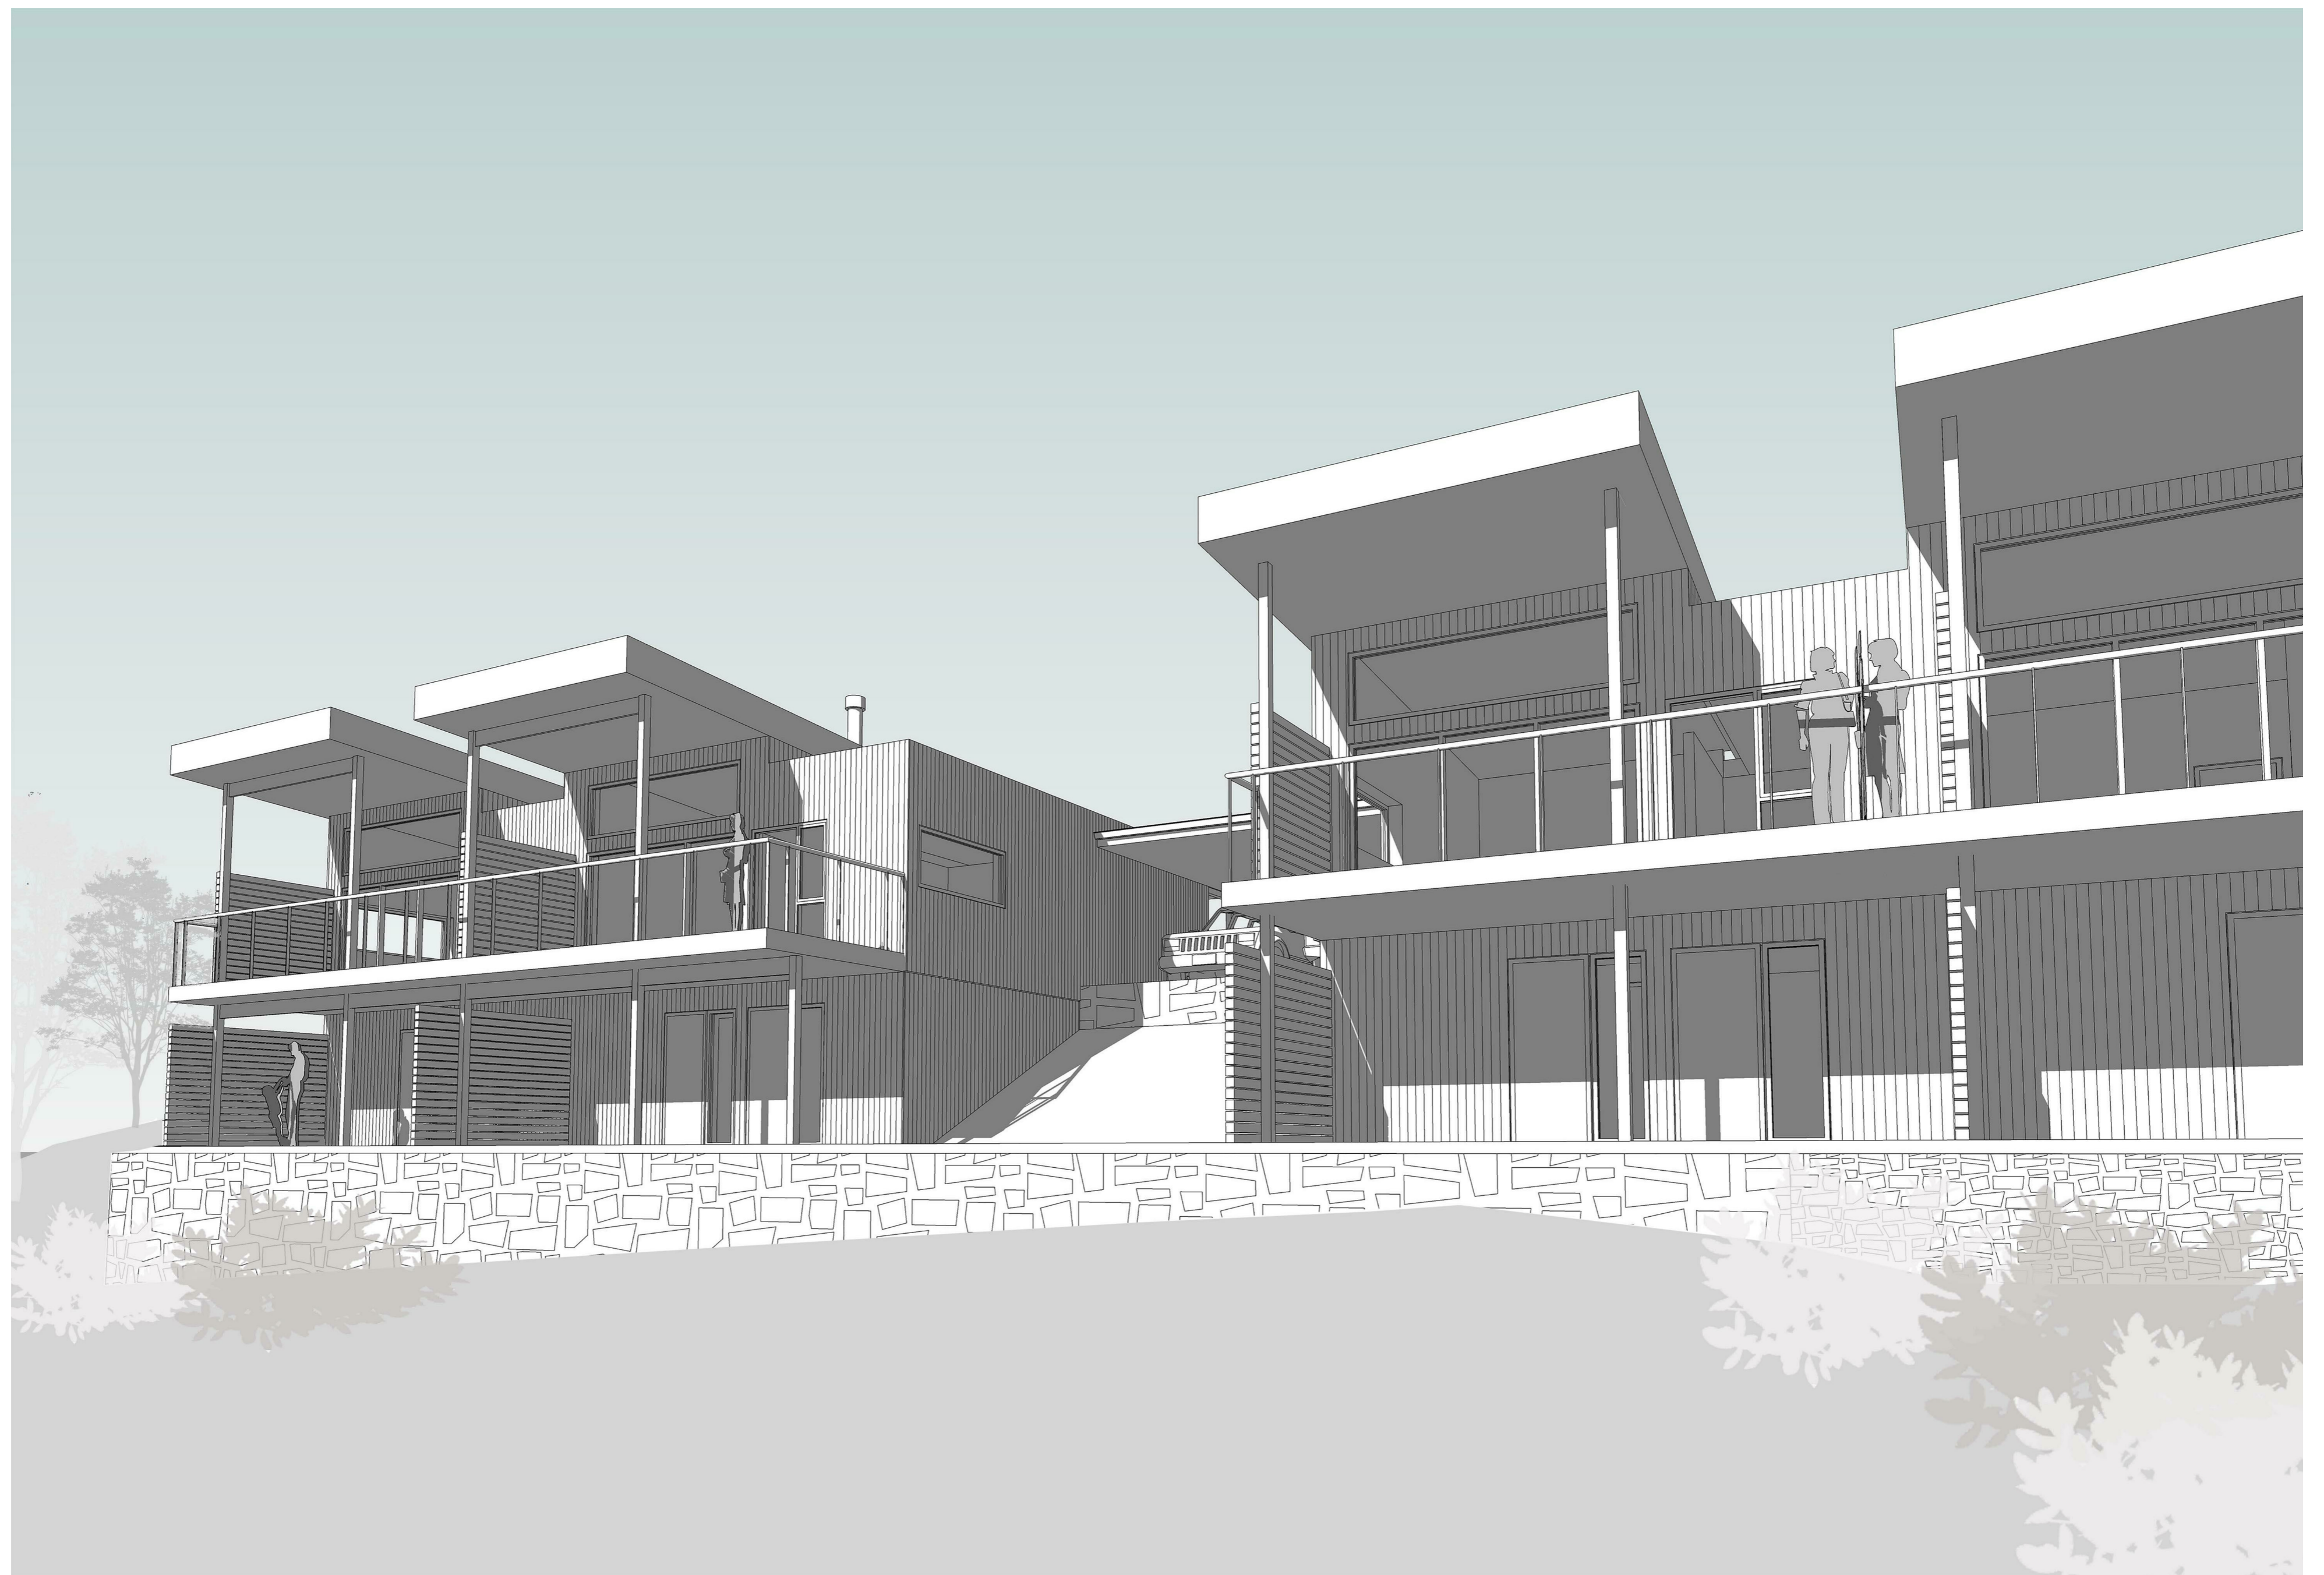


REV. | DATO | BESKRIVELSE | TEGN. | KONTR.

| | | | |
|--|---|---|--|
| ARKITEKTKONTORET BØRTVEIT & CARLSEN AS HAGELLIA 6 - 5914 ISDALSTØ TELEFON 400 41 614 post@arkbc.no | |  | TILTAKSHAVER: Sameiet Orresteinen GNR. / BNR.: Gnr. 185/Bnr. 319 PROSJEKTNAV: Tomannsboliger - Orresteinen |
| PROSJEKTNR.: 19004 TEISET AV: MMC KONTR. AV: PJC | ARKISTORRELSE: A2 MALESTOKK: DATO: 05.02.20 | | TEGNINGSNUMMER: A1-502 |



REV. | DATO | BESKRIVELSE | TEGN. | KONTR.

| | | | |
|--|---|---|---|
| ARKITEKTKONTORET BØRTVEIT & CARLSEN AS HAGELLIA 6 - 5914 ISDALSTØ TELEFON 400 41 614 post@arkbc.no | |  | TILTAKEHAVER: Sameiet Orresteinen GNR. / BNR.: Gnr. 185/Bnr.319 PROSJEKTNAV: Tomannsboliger - Orresteinen |
| PROSJEKTNR.: 19004 TEISET AV: MMC KONTR. AV: PJC | ARKSTORREELSE: A2 MALESTOKK: DATO: 05.02.20 | | TEGNINGSNUMMER: A1-503 |



| REV. | | DATO | | BESKRIVELSE | | TEGN. | | KONTR. | |
|--|------------------|-----------------|--|------------------------------|--|-----------|--|---|--|
| ARKITEKTKONTORET BØRTVEIT & CARLSEN AS HAGELLIA 6 - 5914 ISDALSTØ TELEFON 400 41 614 post@arkbc.no | | | | | | | | TILTAKSHAVER: Sameiget Orresteinen GNR. / BNR.: Gnr. 185/Bnr.319 PROSJEKTNAVN: Tomannsboliger - Orresteinen | |
| PROSJEKTNR.: 19004 | ARKSTORRELSE: A2 | TEGNINGSNUMMER: | | TEGNINGSNAVN: | | REVISJON: | | | |
| TEGNET AV: MMC | MALESTOKK: | A1-504 | | Perspektiv 02 - Eksisterende | | | | | |
| KONTR. AV: PJC | DATO: 05.02.20 | | | | | | | | |



| REV. | | DATO | | BESKRIVELSE | | TEGN. | | KONTR. | |
|--|-------------------|-----------------|--|--------------------|--|-----------|--|--|--|
| ARKITEKTKONTORET BØRTVEIT & CARLSEN AS HAGELLIA 6 - 5914 ISDALSTØ TELEFON 400 41 614 post@arkbc.no | | | | | | | | TILTAKEHAVER: Sameiet Orresteinen GNR. / BNR.: Gnr. 185/Bnr.319 PROSJEKTNAVN: Tomannsboliger - Orresteinen | |
| PROSJEKTNR.: 19004 | ARKISTORRELSE: A2 | TEGNINGSNUMMER: | | TEGNINGSNAVN: | | REVISJON: | | | |
| TEGNET AV: MMC | MALESTOKK: | A1-505 | | Perspektiv 02 - Ny | | | | | |
| KONTR. AV: PJC | DATO: 05.02.20 | | | | | | | | |