

TAUUE 92098918

Y 288450


Y 288400

X 6727900

X 6727850

471/5

471/5

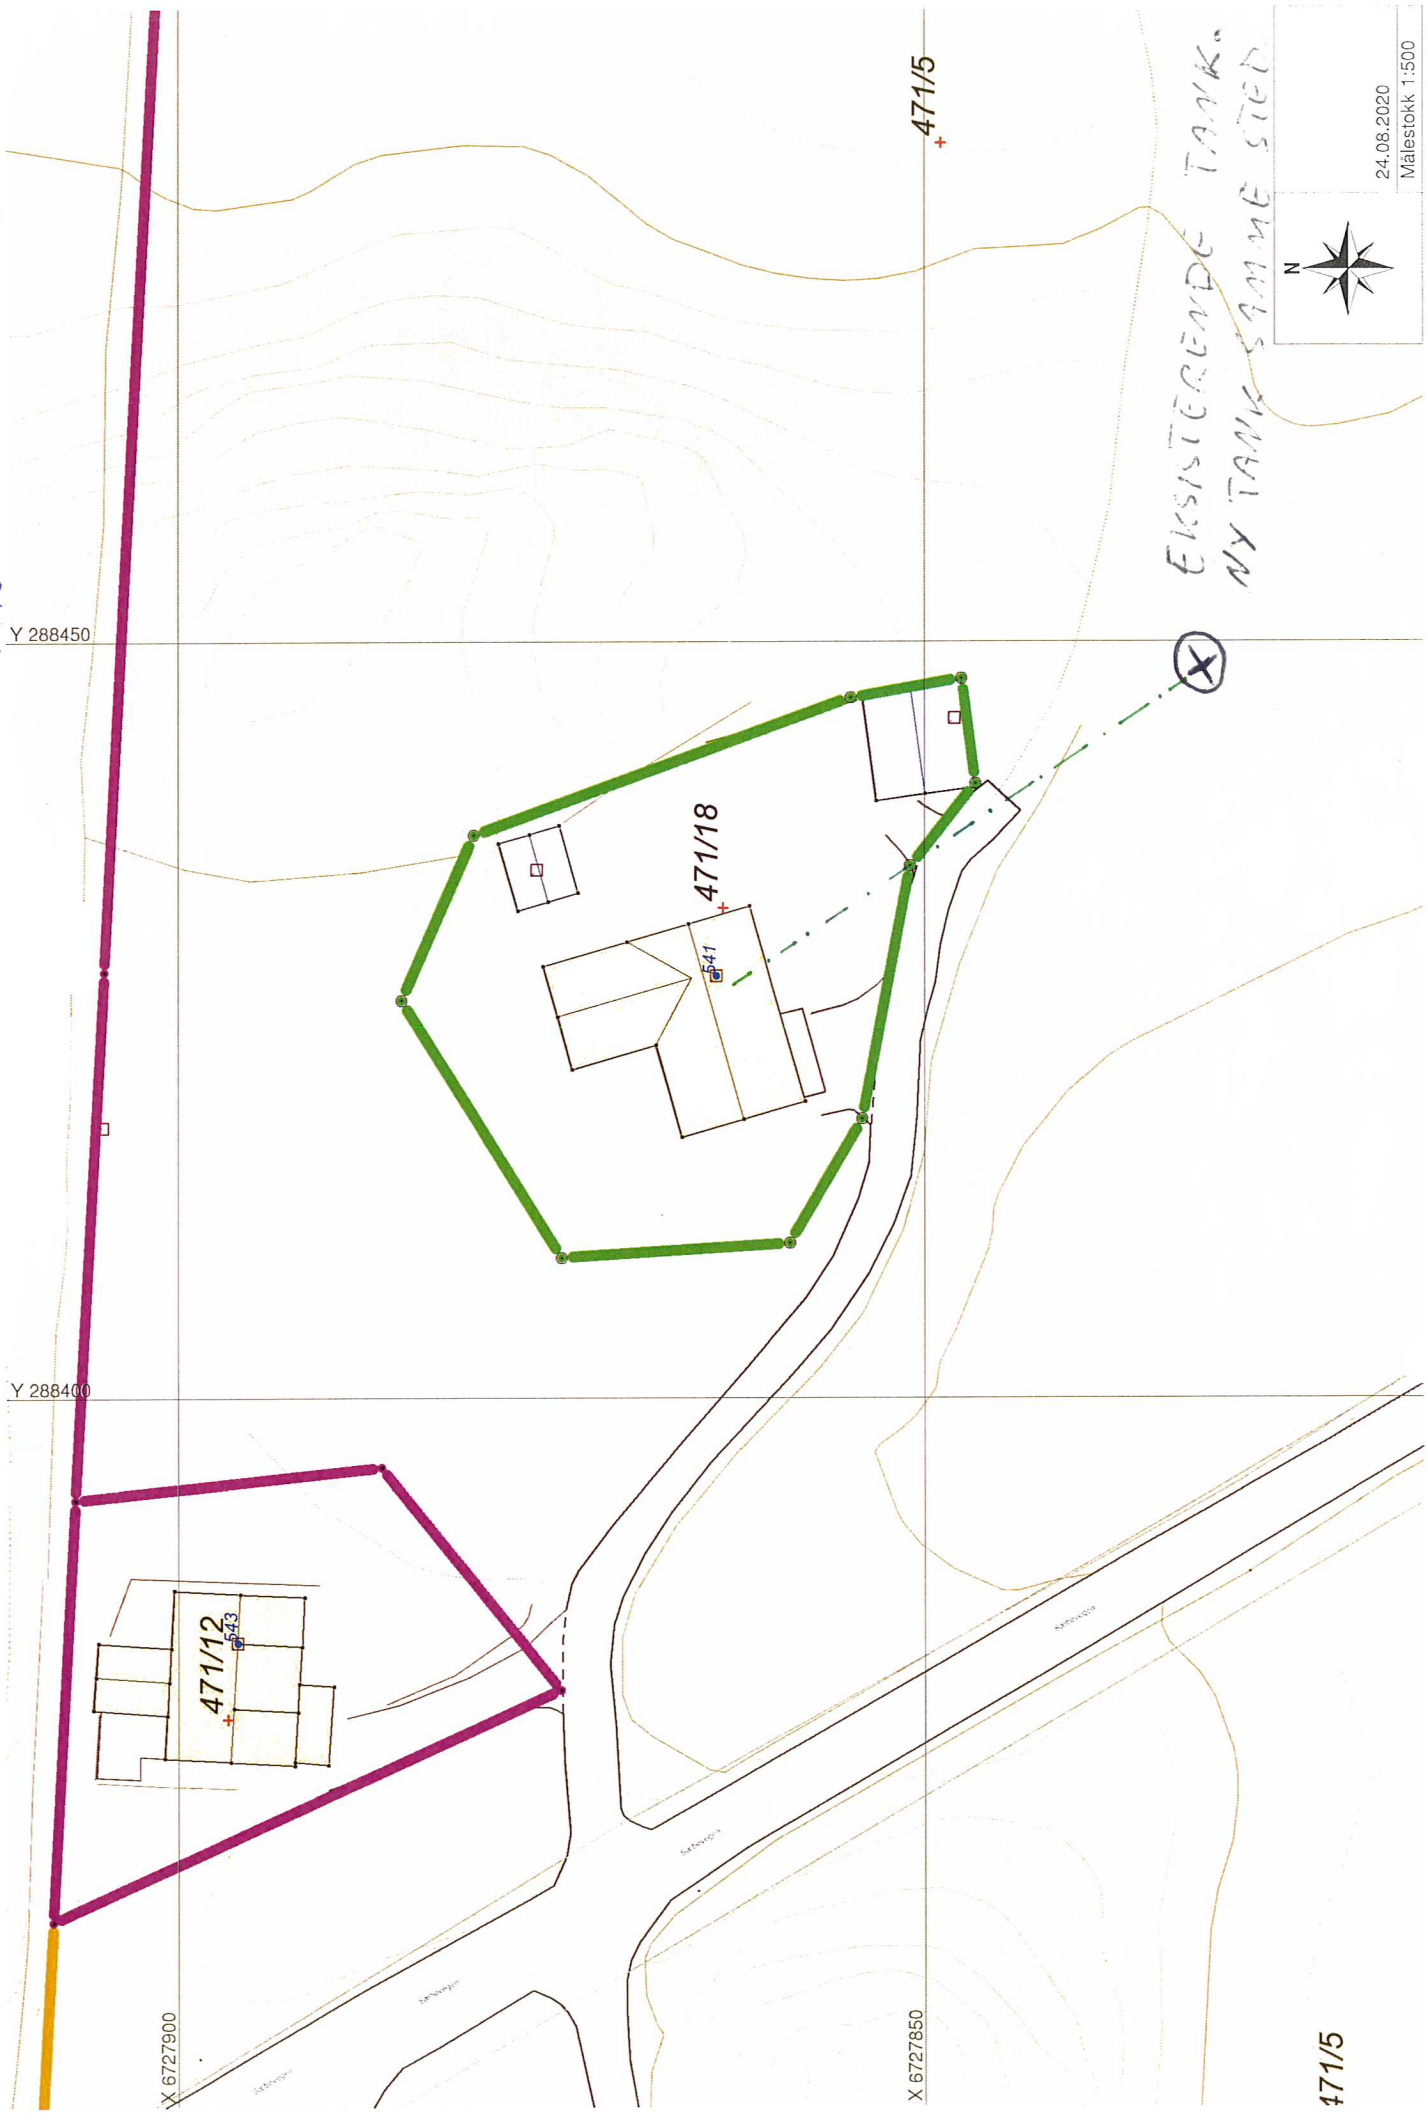

EKSISTERENDE TANK.  
NY TANK SAMME STED.



24.08.2020  
Målestokk 1:500

SÅKSBEHANDLER ALVØR KOMMUNE GRØNTEIEN MANGREY HELLAND