




FA
5.11.2020

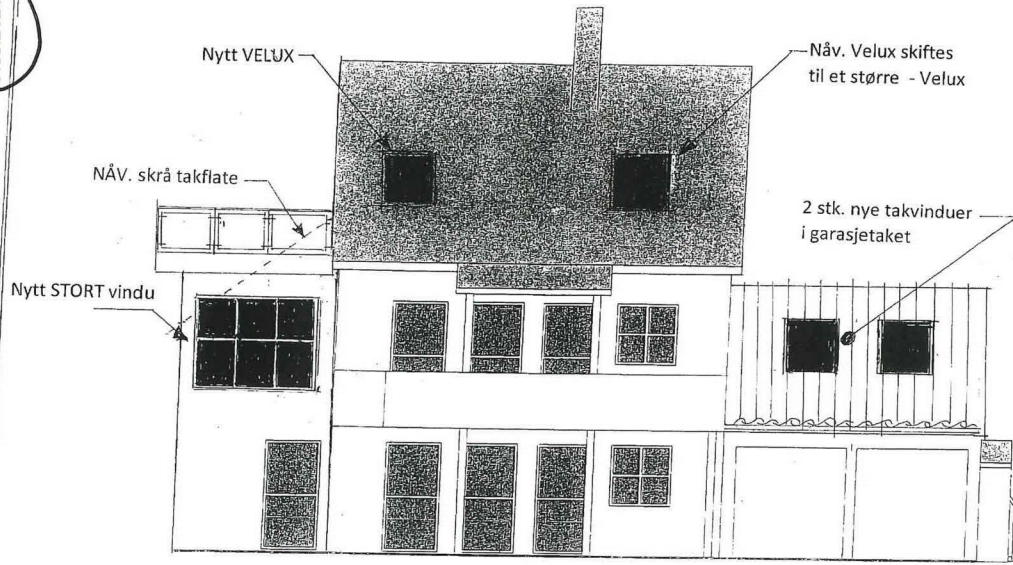

Fasade nord - øst

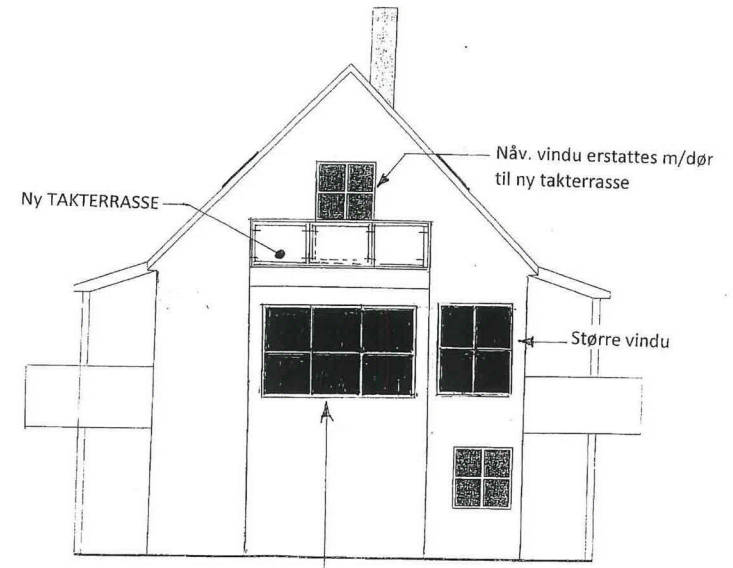


Fasade mot SYD-ØST

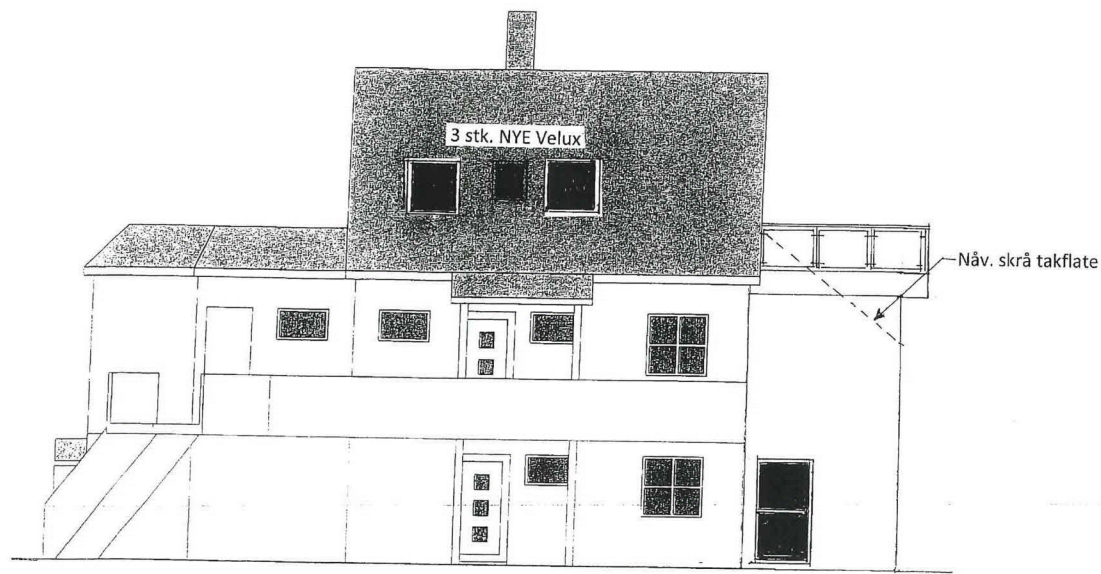

Fasade sør - vest


Prisj. ENDRETE fasader
Nordgardshaugen 19 b, Frekhaug
Gnr. 300 , 323, bnr. 412 i Alver kommune
Tiltakshaver : Thomas Svanevik
Frekhaug , 05. 10. 2020 Rettet : 09.10.2020
Thomas Svanevik

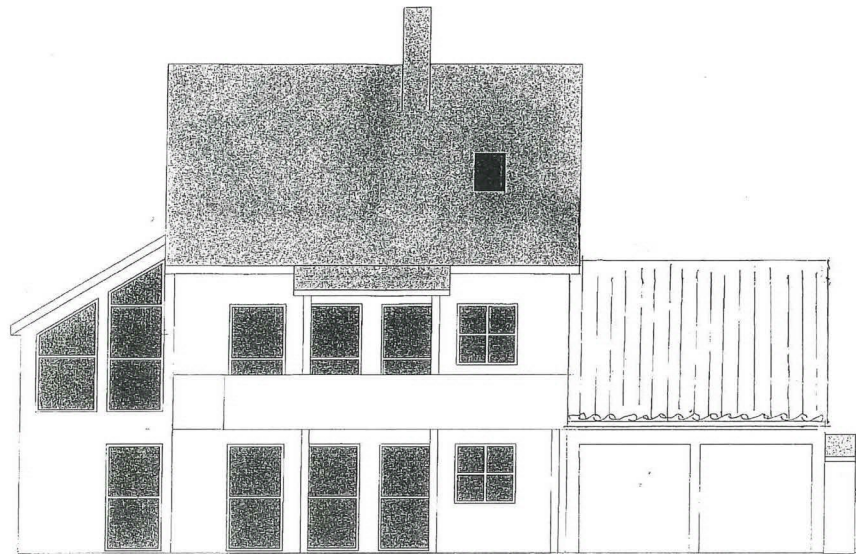

Fasade nord - øst



Fasade mot SYD-ØST

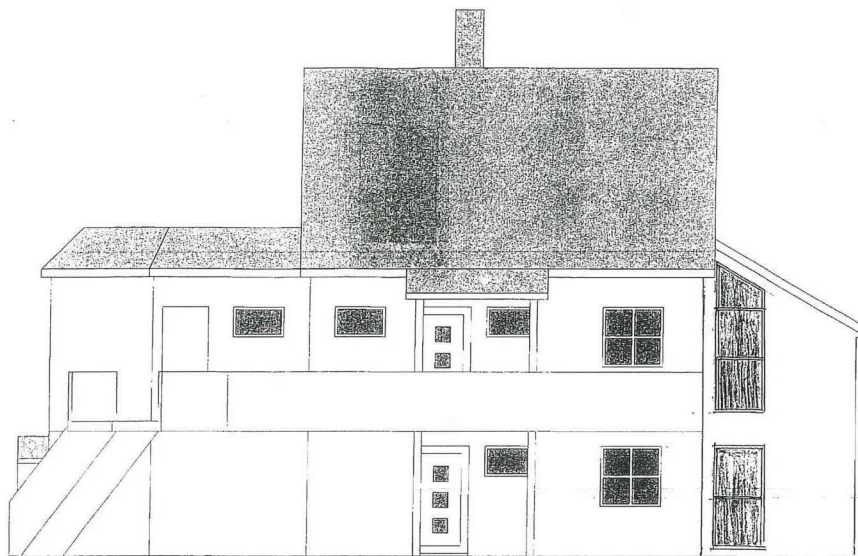

Fasade sør - vest

NÅVÆRENDE FASADER

Nordgardshaugen 19 b, Frekhaug

Gnr. 300 , 323, bnr. 412 i Alver kommune

Tiltakshaver : Thomas Svanevik

Frekhaug, 28. 09. 2020 · Rettet : 09.10.2020
Thomas Svanevik