


— Gamle grenser
— Nye grenser

355/7

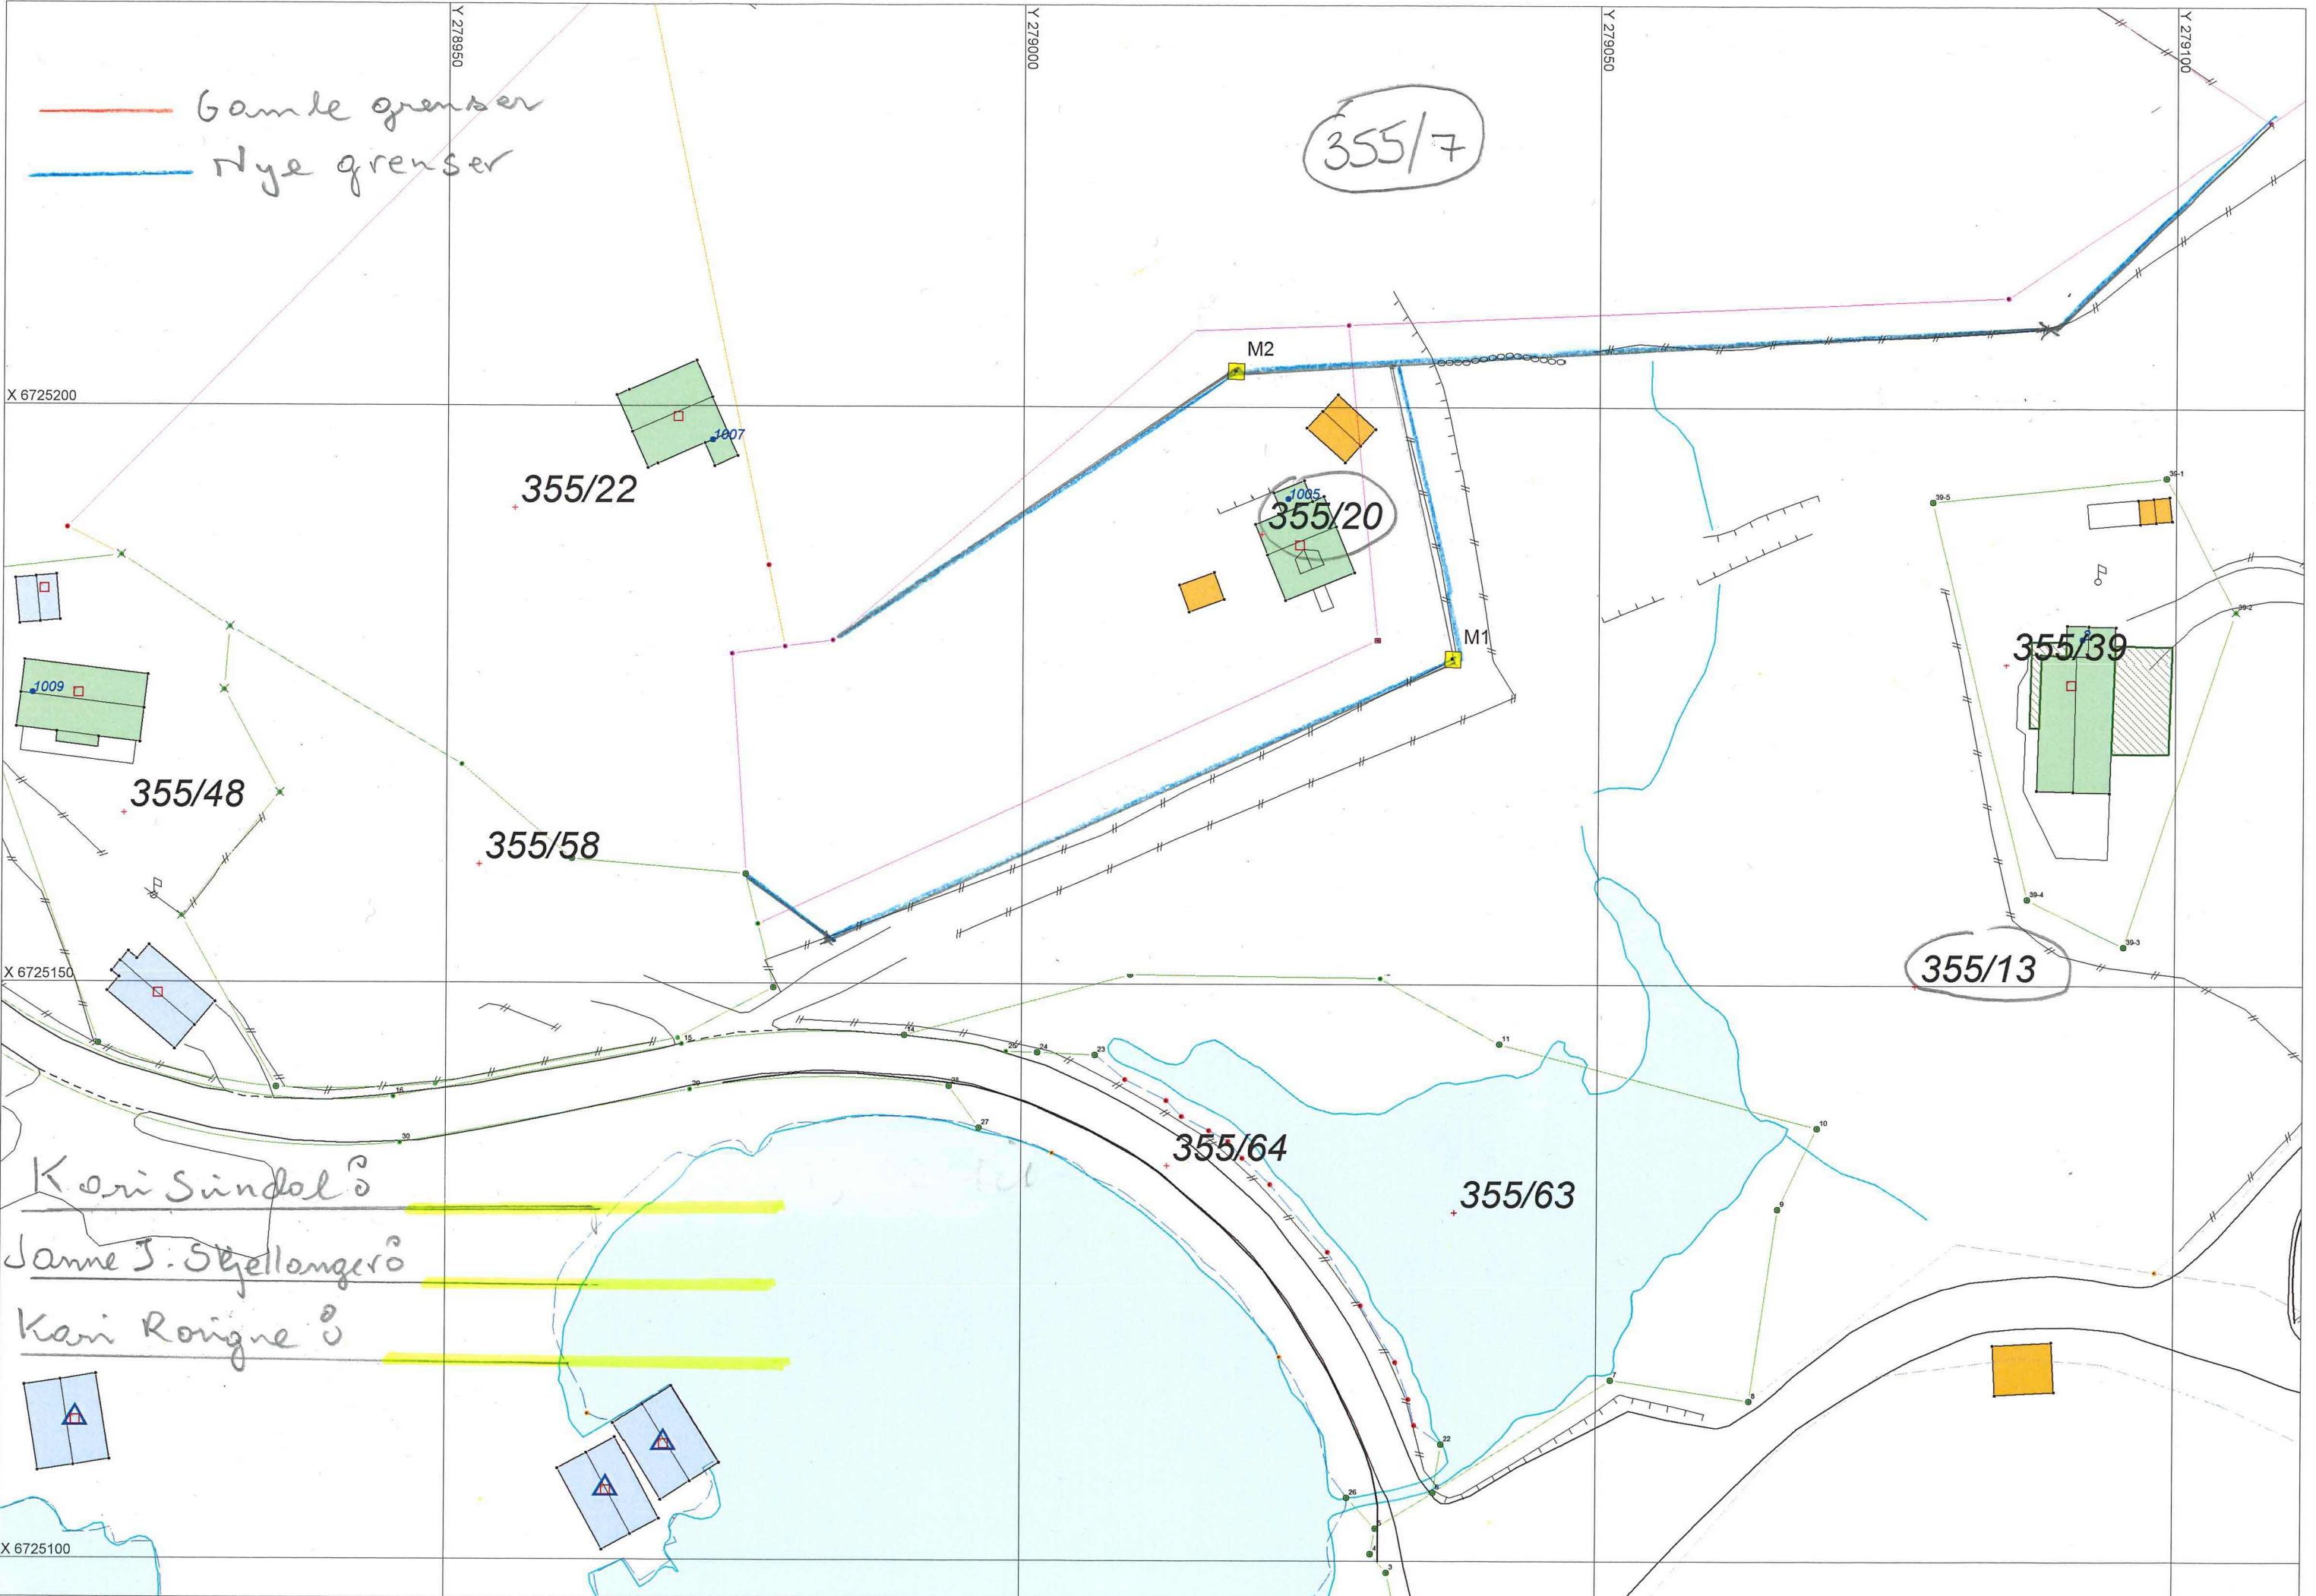

X 6725200

X 6725150

X 6725100

Y 278950

Y 279000

Y 279050

Y 279100

355/22

355/20

355/48

355/58

355/39

355/13

355/64

355/63

Kari Sindal

Janne J. Skjellanger

Kari Røigne

M2

M1