


— Gamble grensen
— Nye grenser

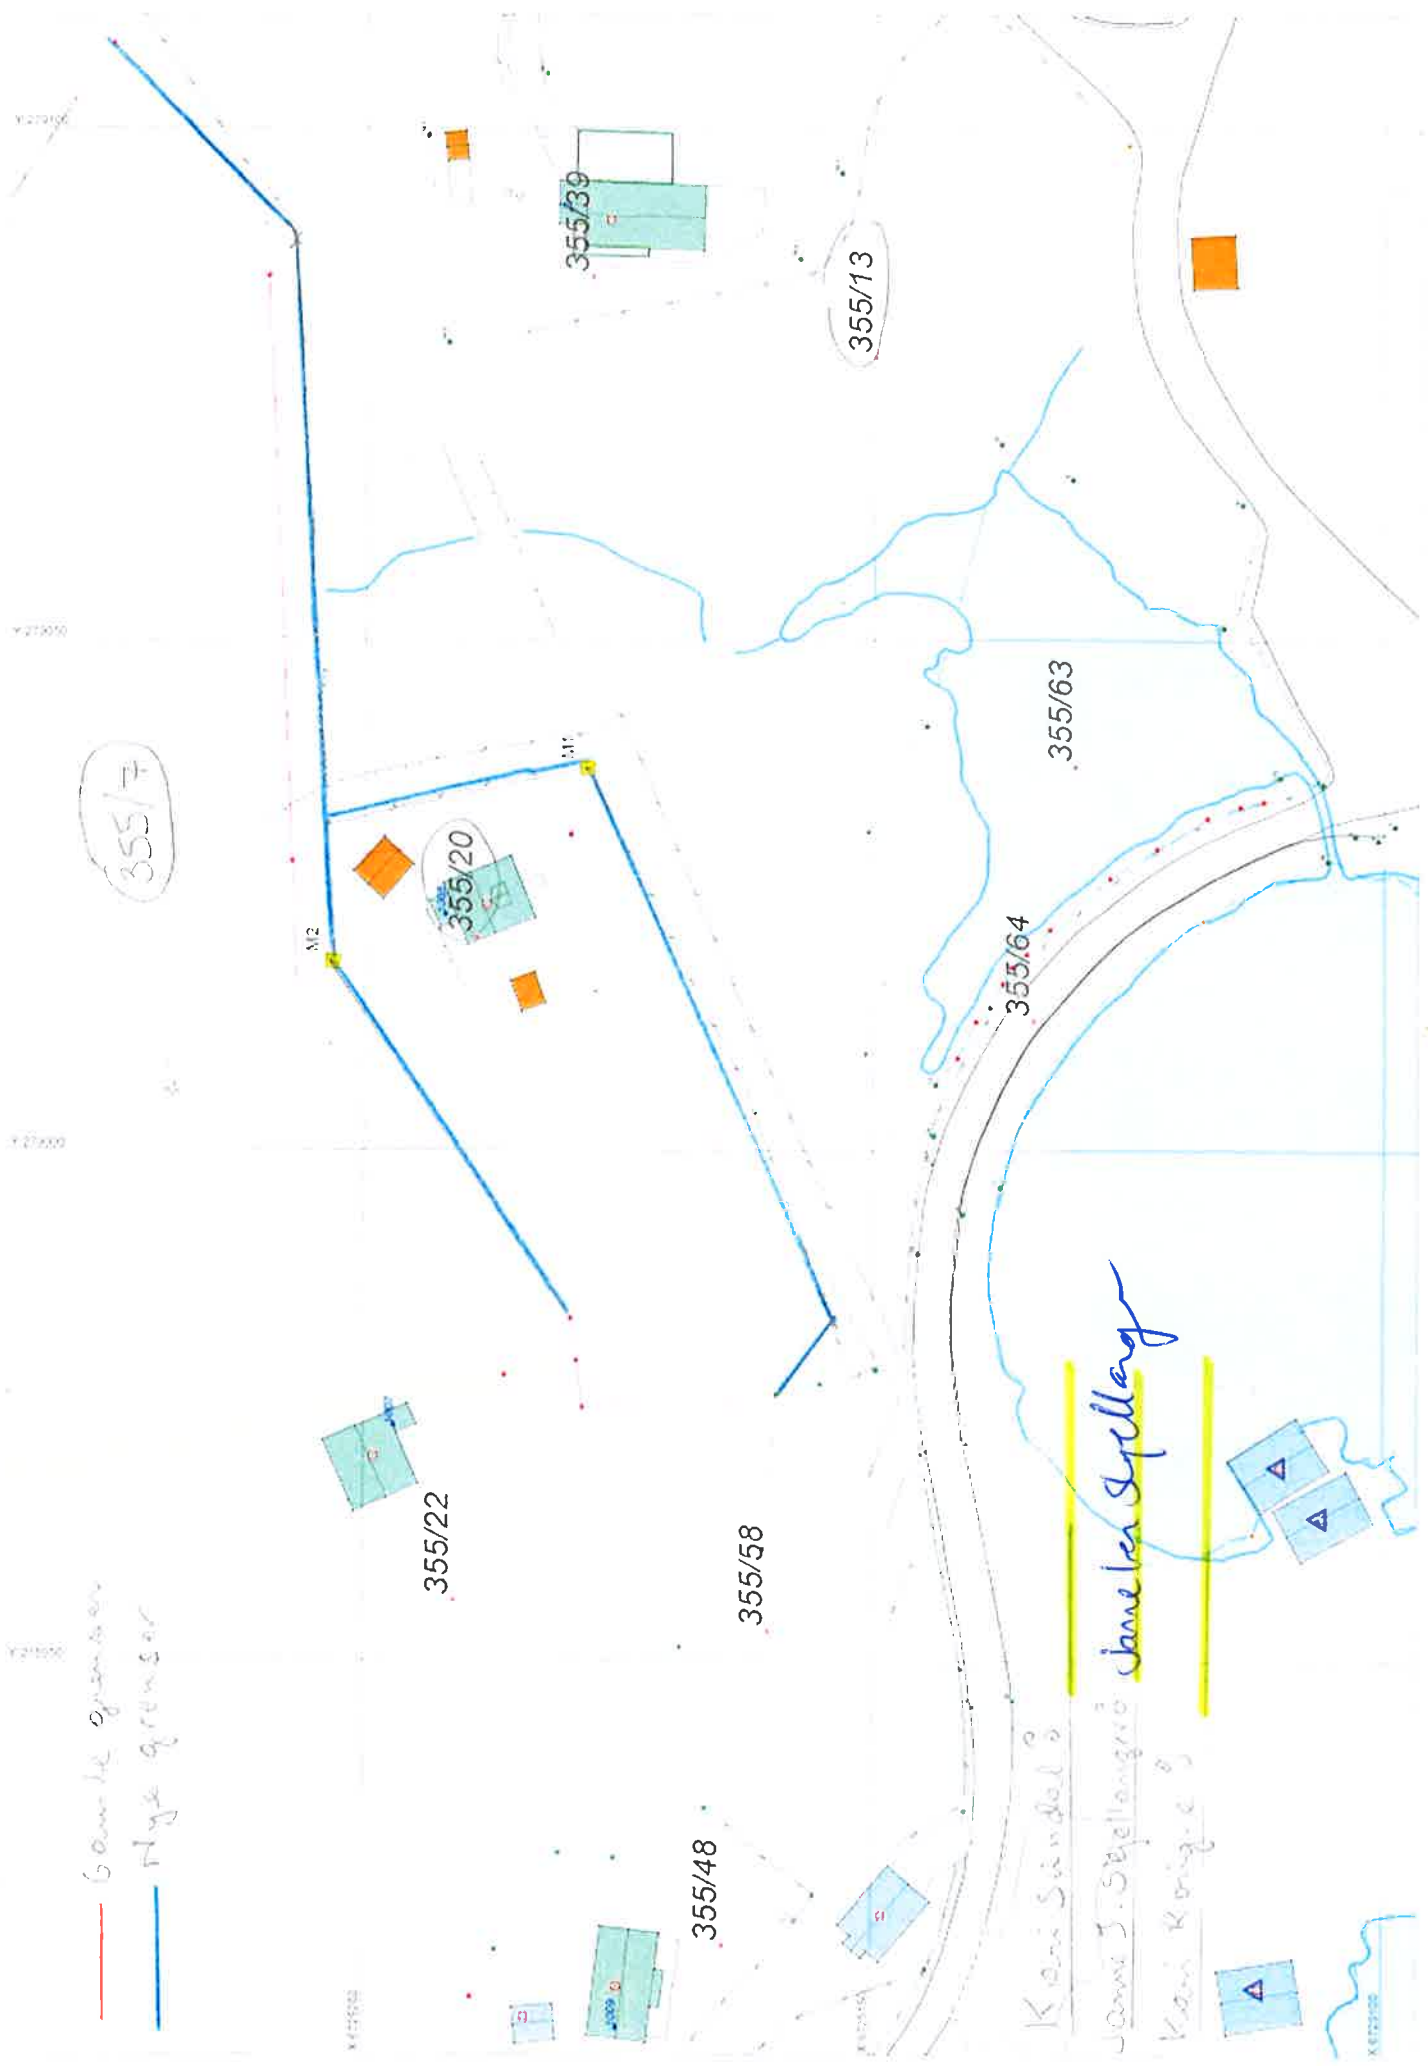

Kari Sævdal
Janni Steffangrø
Kari Røingrø

Jannelen Spylleg