


— Gamle grenser
— Nye grenser

355/7

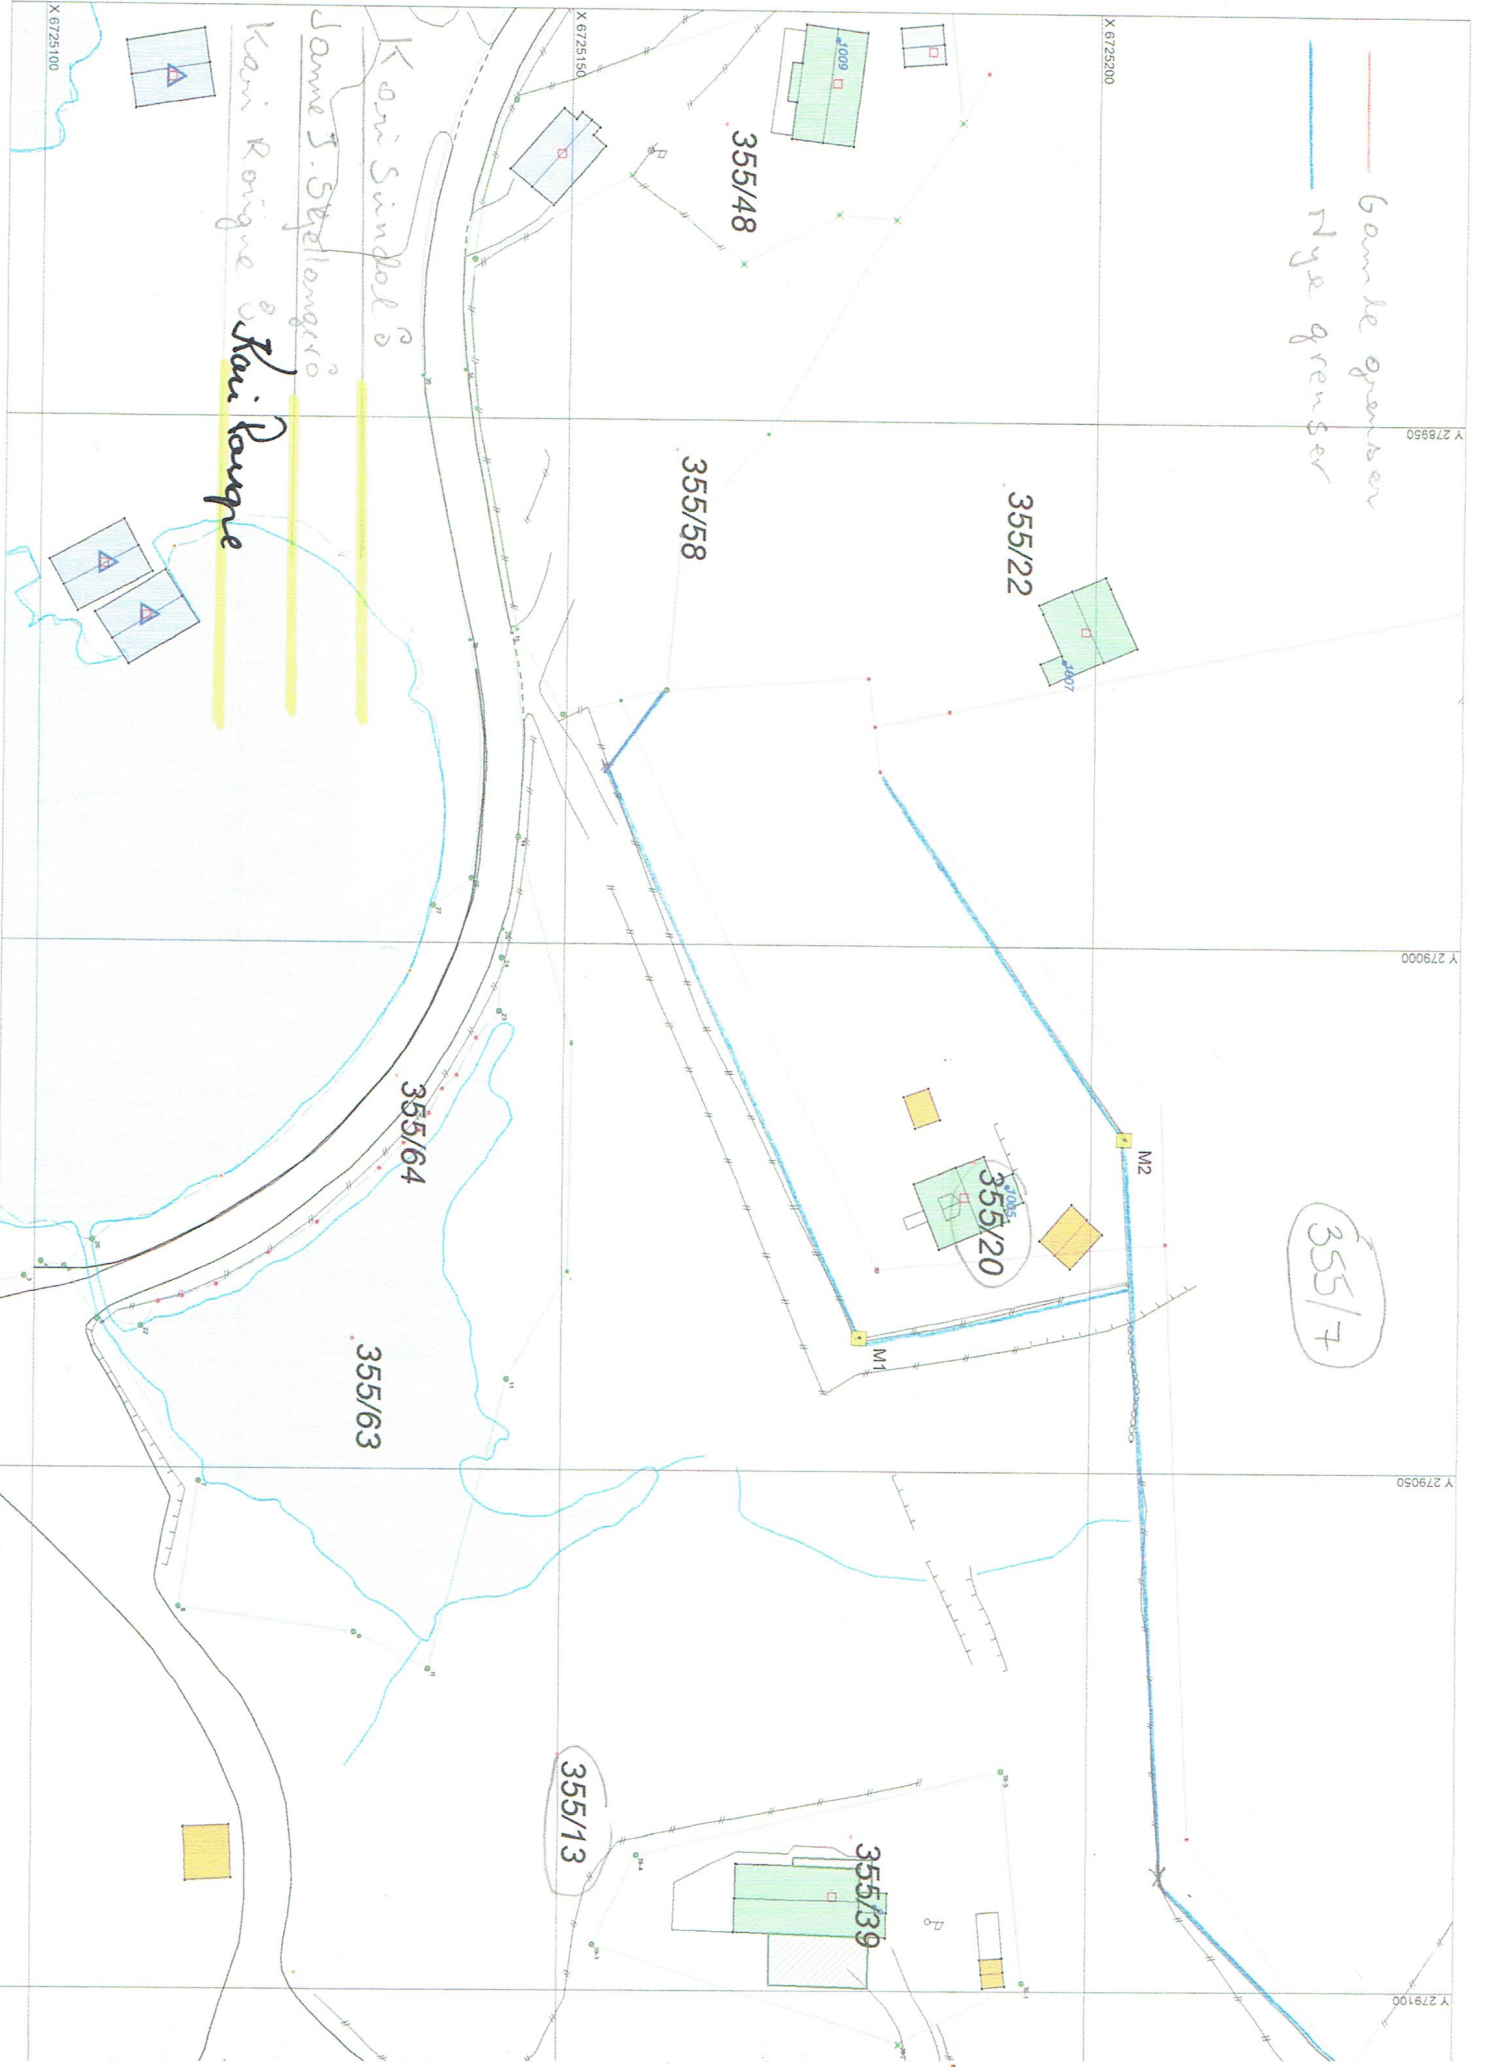

Kari Singhol
Dome J. Stjellanger
Kari Røinge & Kari Røinge

355/48

355/58

355/22

355/20

355/64

355/63

355/13

355/39

X 6725100

X 6725200

Y 278950

Y 279000

Y 279050

Y 279100