


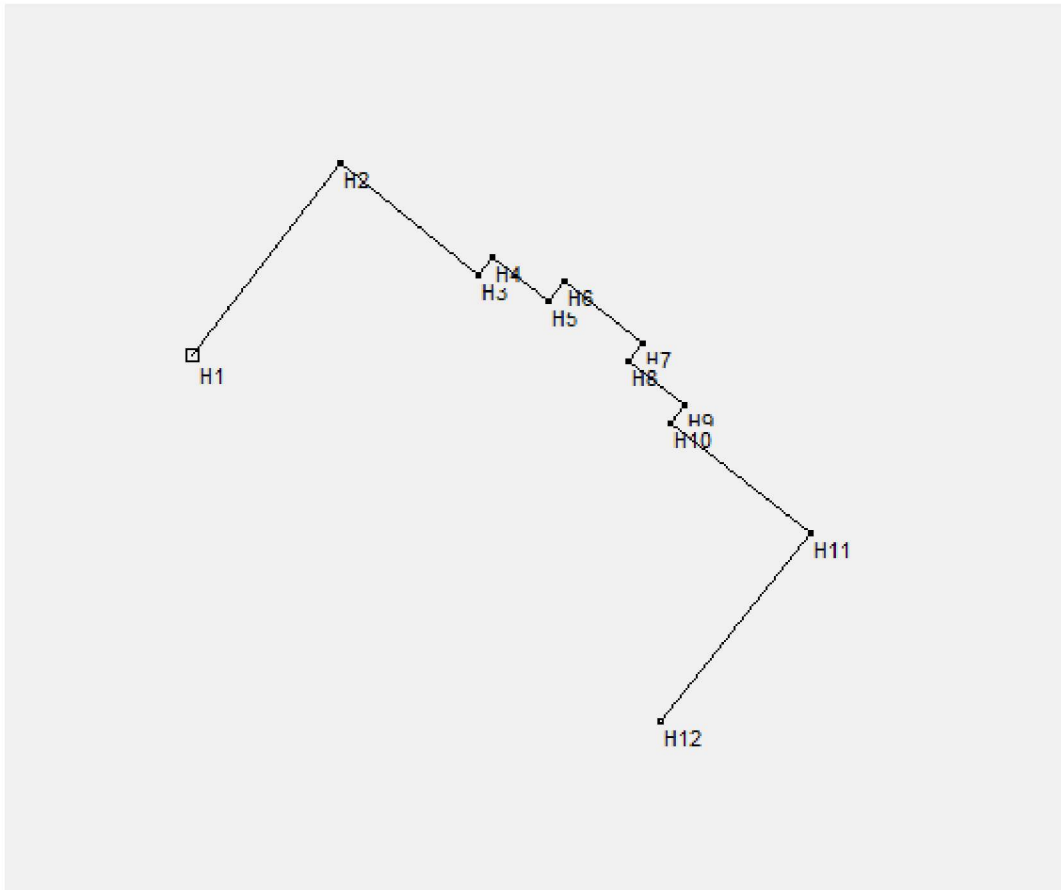

Medaas Oppmåling

137/168 Innmålt topp grunnmur

14.06.2019



```

-00 Leica Geosystems AG
-00 Instrument:      GX1230 GG      Måledato: 14.06.2019
-00 Målejobb:      ALVERNESET      Operatør: km
-00 Jobbeskrivelse:
09_91
05 H1              5006          6718983.460  295195.549   14.107   0.014
05 H2              5006          6718988.437  295199.401   14.319   0.016
05 H3              5006          6718985.537  295203.045   14.350   0.014
05 H4              5006          6718986.022  295203.405   14.323   0.014
05 H5              5006          6718984.871  295204.866   14.363   0.016
05 H6              5006          6718985.357  295205.237   14.310   0.016
05 H7              5006          6718983.740  295207.298   14.319   0.017
05 H8              5006          6718983.272  295206.927   14.358   0.014
05 H9              5006          6718982.134  295208.370   14.330   0.017
05 H10             5006          6718981.655  295208.009   14.360   0.014
05 H11             5006          6718978.804  295211.665   14.336   0.013
05 H12             5006          6718973.883  295207.754   14.302   0.016
09_99

```

Medaas Oppmåling

Litlevika 47
5914 Isdalstø
kjameda@online.no

Tlf: 56352227 – 48287186
Org.nr.: 986 448 551 MVA
Bank: 3632 10 19190