


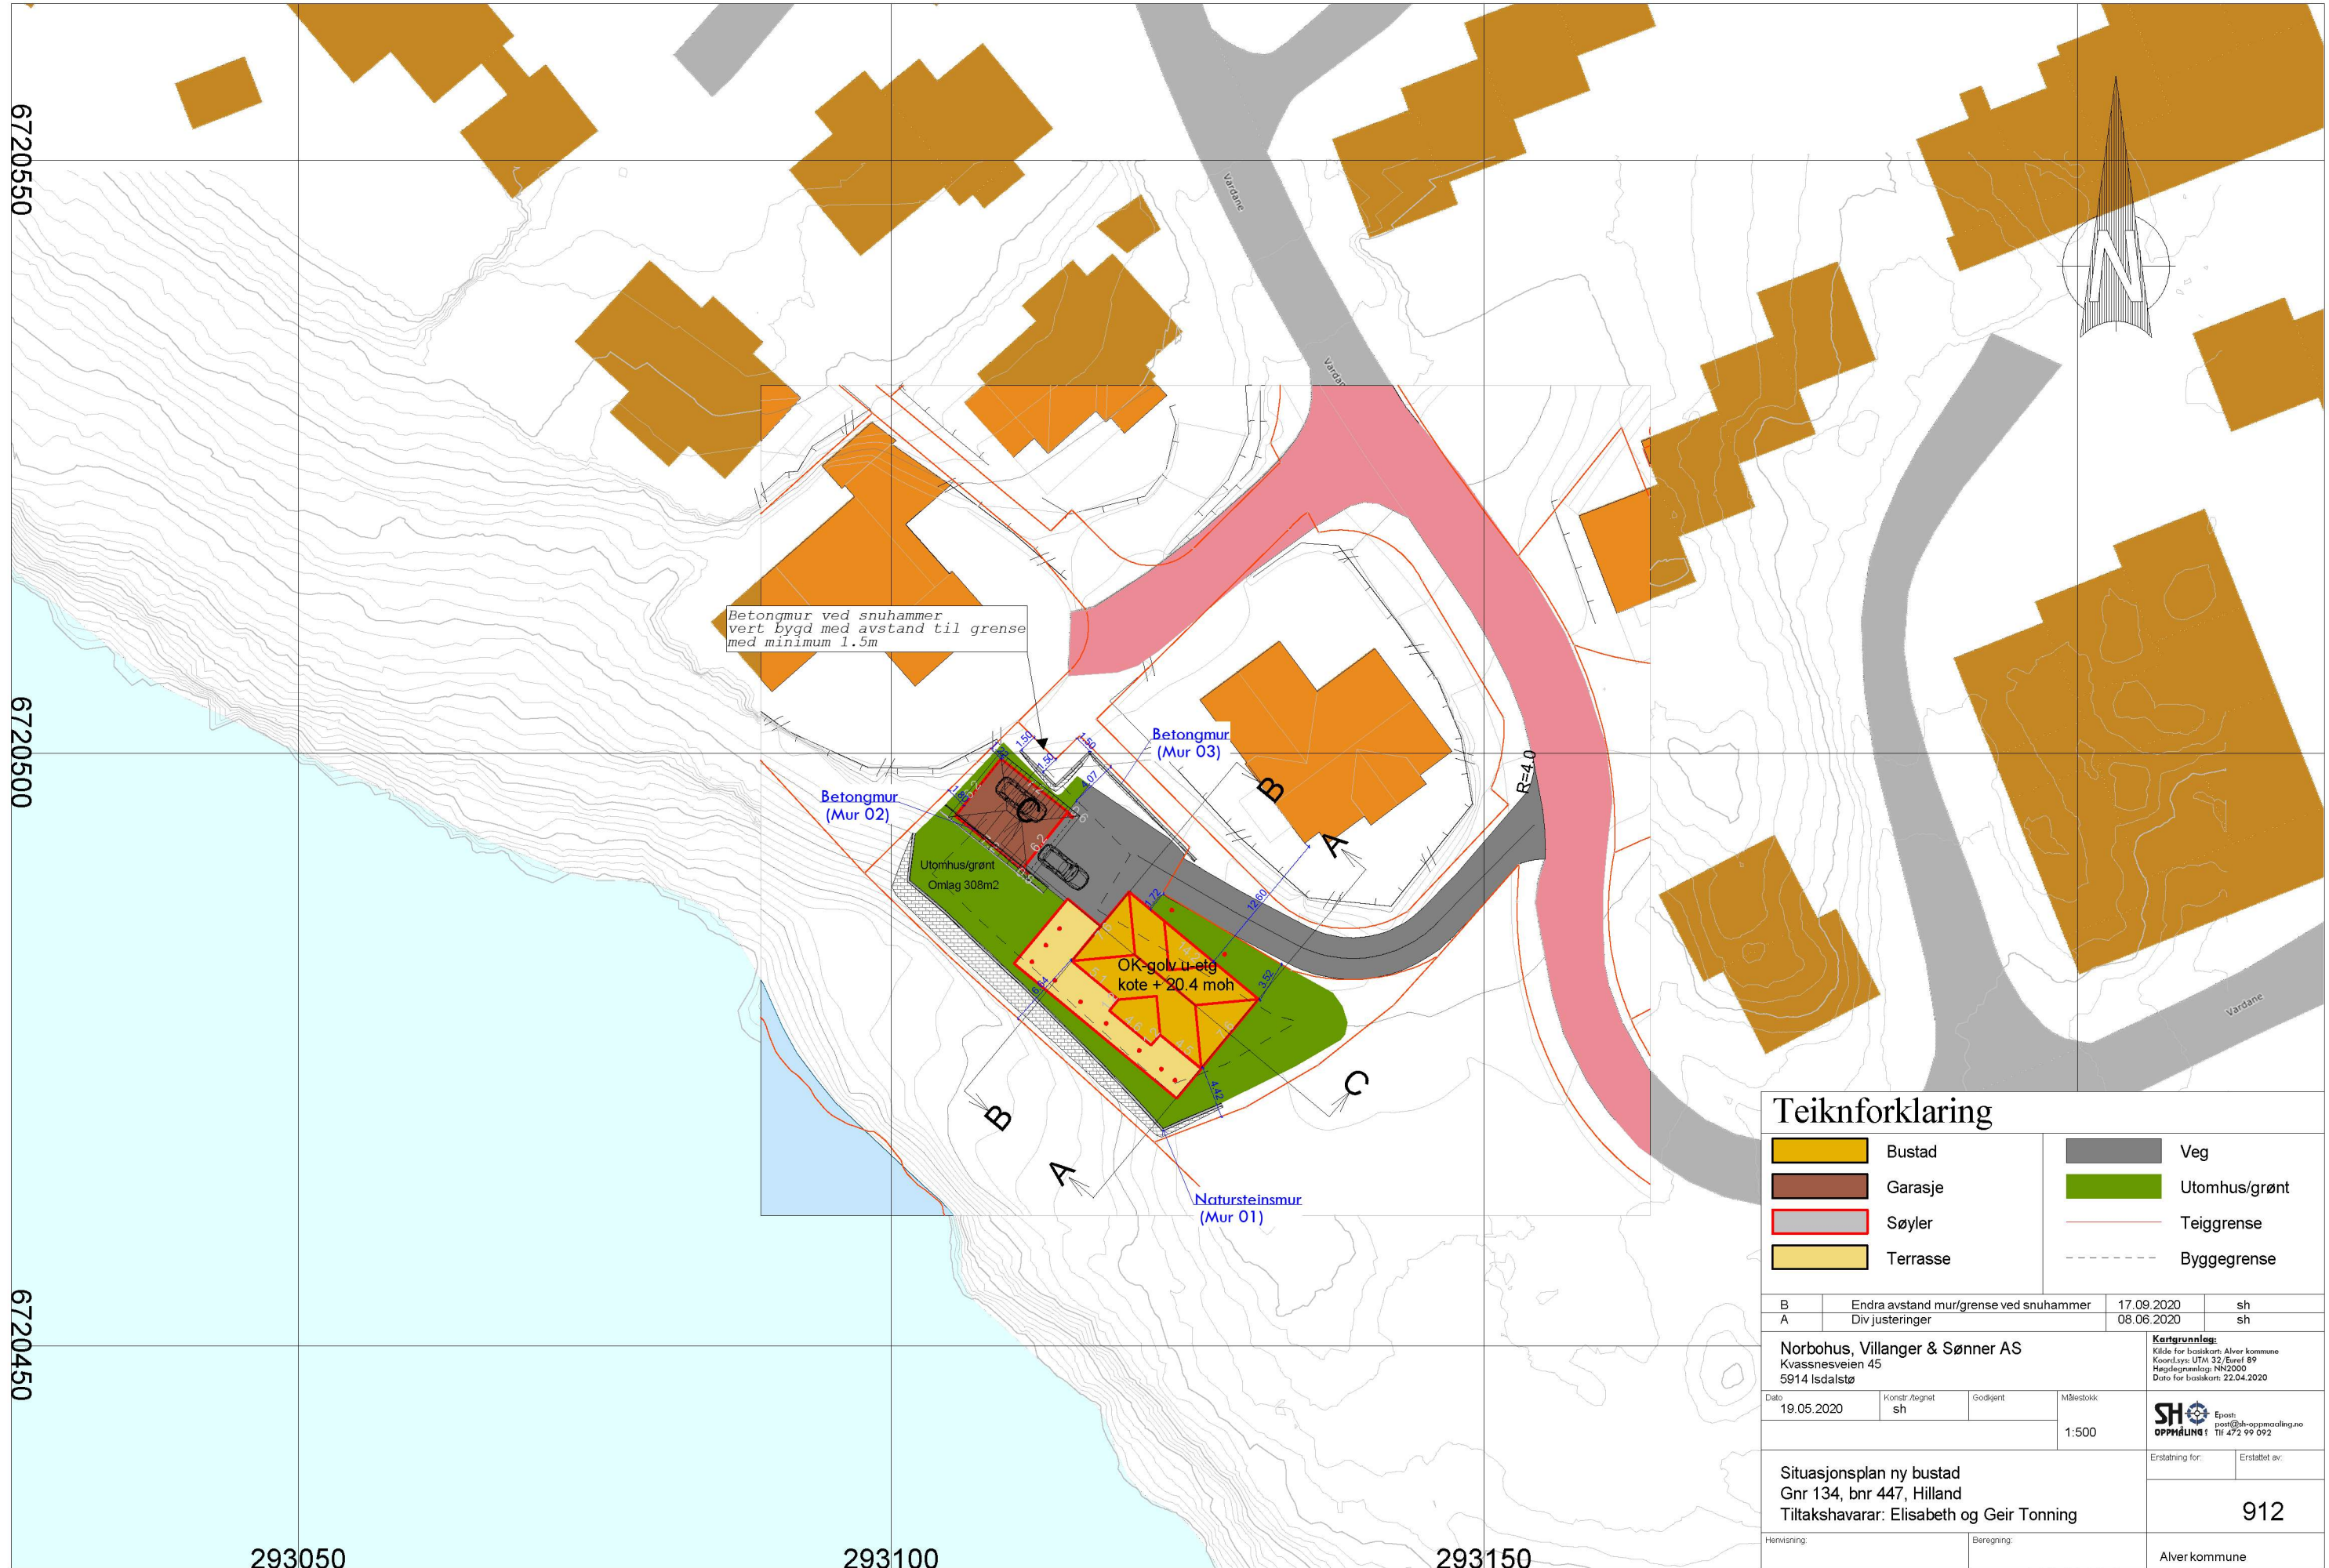

Teiknforklaring

	Bustad		Veg
	Garasje		Utomhus/grønt
	Søyer		Teiggrense
	Terrasse		Byggegrense

B	Endra avstand mull/grense ved snuhammer	17.09.2020	sh
A	Div justeringer	08.06.2020	sh
Norbohus, Villanger & Sønner AS Kvassnesveien 45 5914 Isdalstø		Kartgrunnlag: Kilde for basiskart: Alver kommune Koordinat: UTM 32/Euref 89 Høgdegrunnlag: NN2000 Data for basiskart: 22.04.2020	
Dato 19.05.2020	Konstr./regnet sh	Godkjent	Målestokk 1:500
Situasjonsplan ny bustad Gnr 134, bnr 447, Hilland Tiltakshavarar: Elisabeth og Geir Tonning			Erstatning for: Erstatlet av: 912
Henvisning:		Beregning:	Alver kommune