

ambita

Kommune: 4256 Meland ALVER
Eiendom: 4256/38/23—338/23


D1



Målestokk 1:1000

Dato: 22.4.2016

DATØ: 30.11.2020

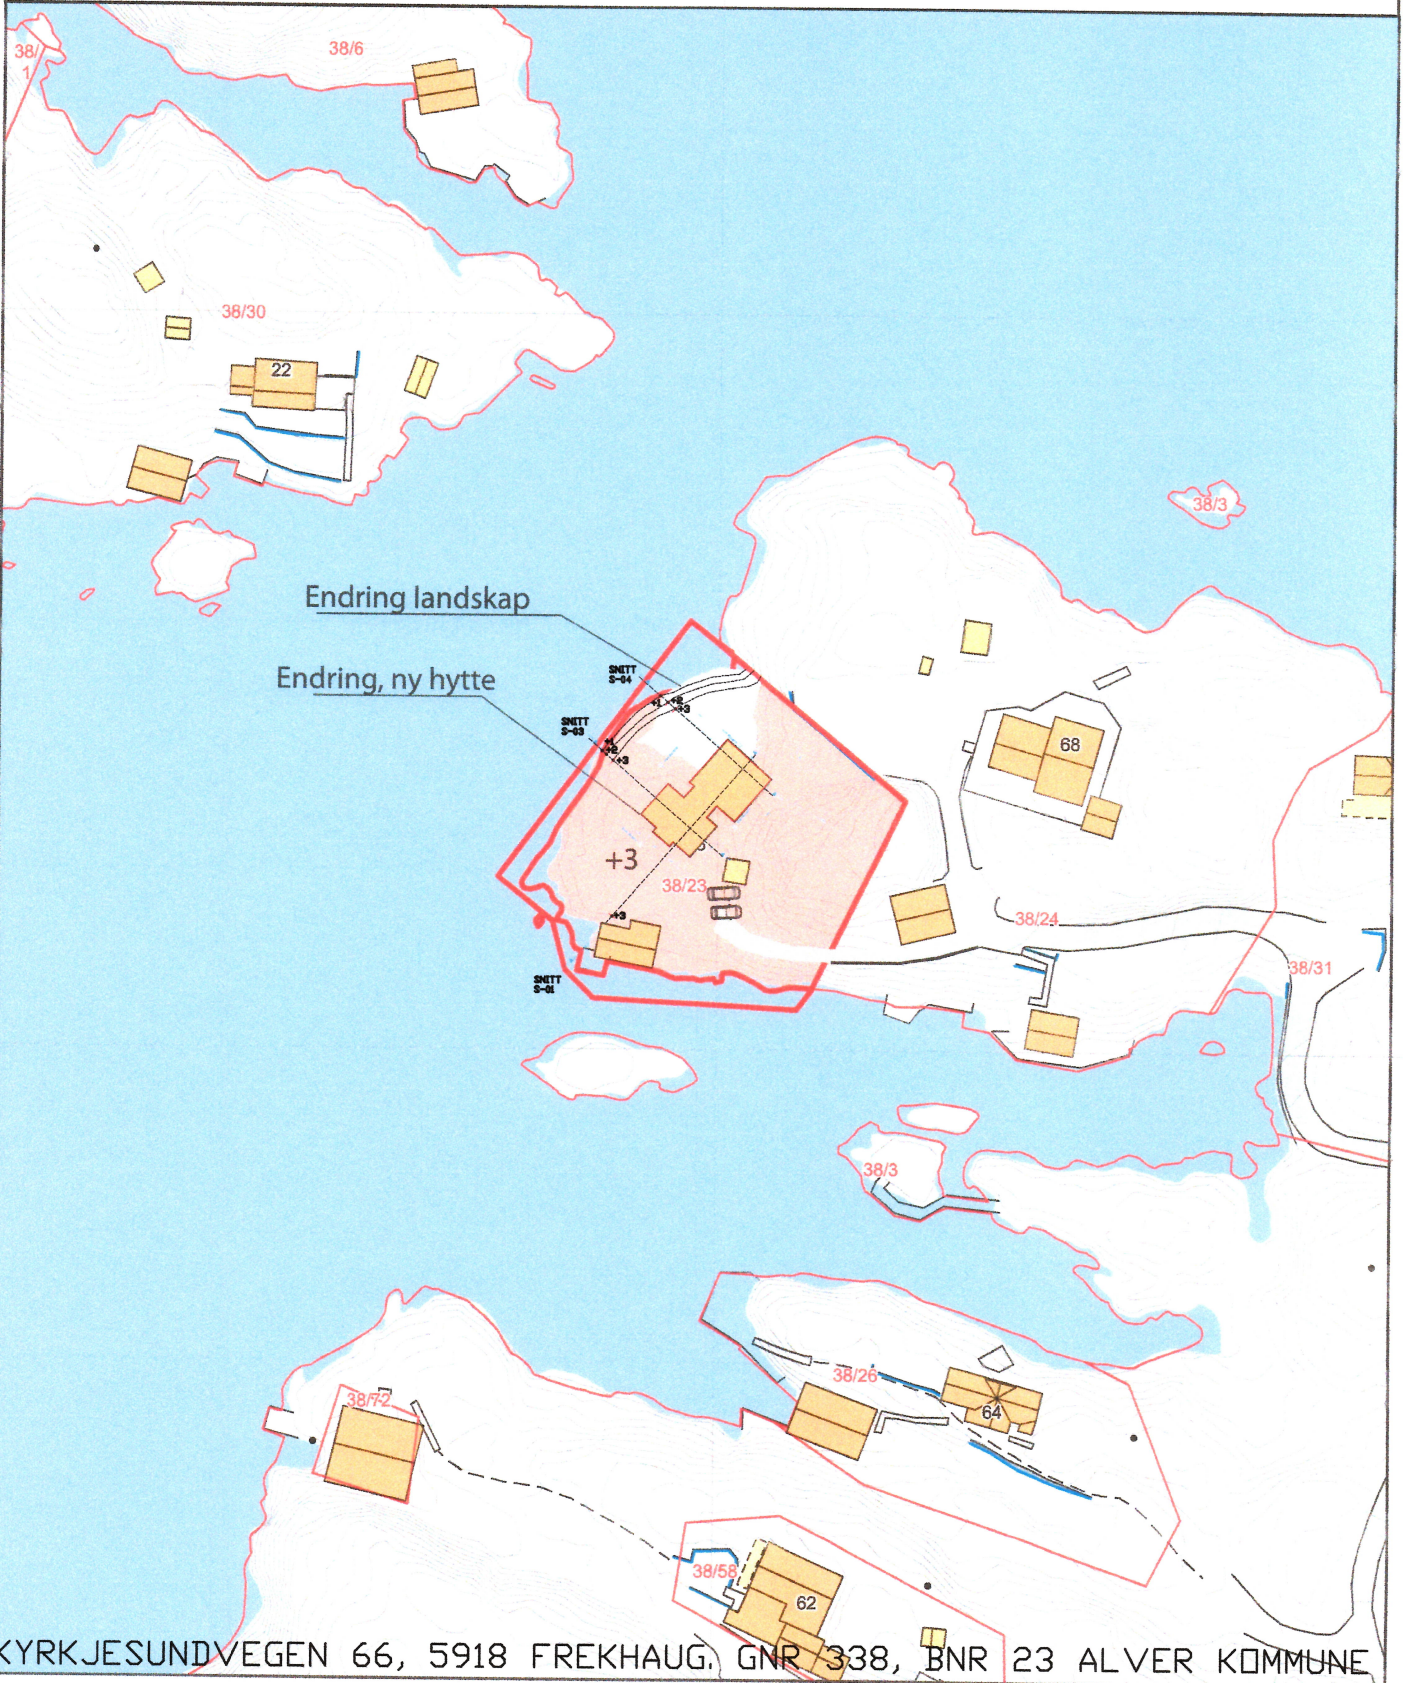

Endring landskap

Endring, ny hytte

KYRKJESUNDVEGEN 66, 5918 FREKHAUG, GNR 338, BNR 23 ALVER KOMMUNE

