


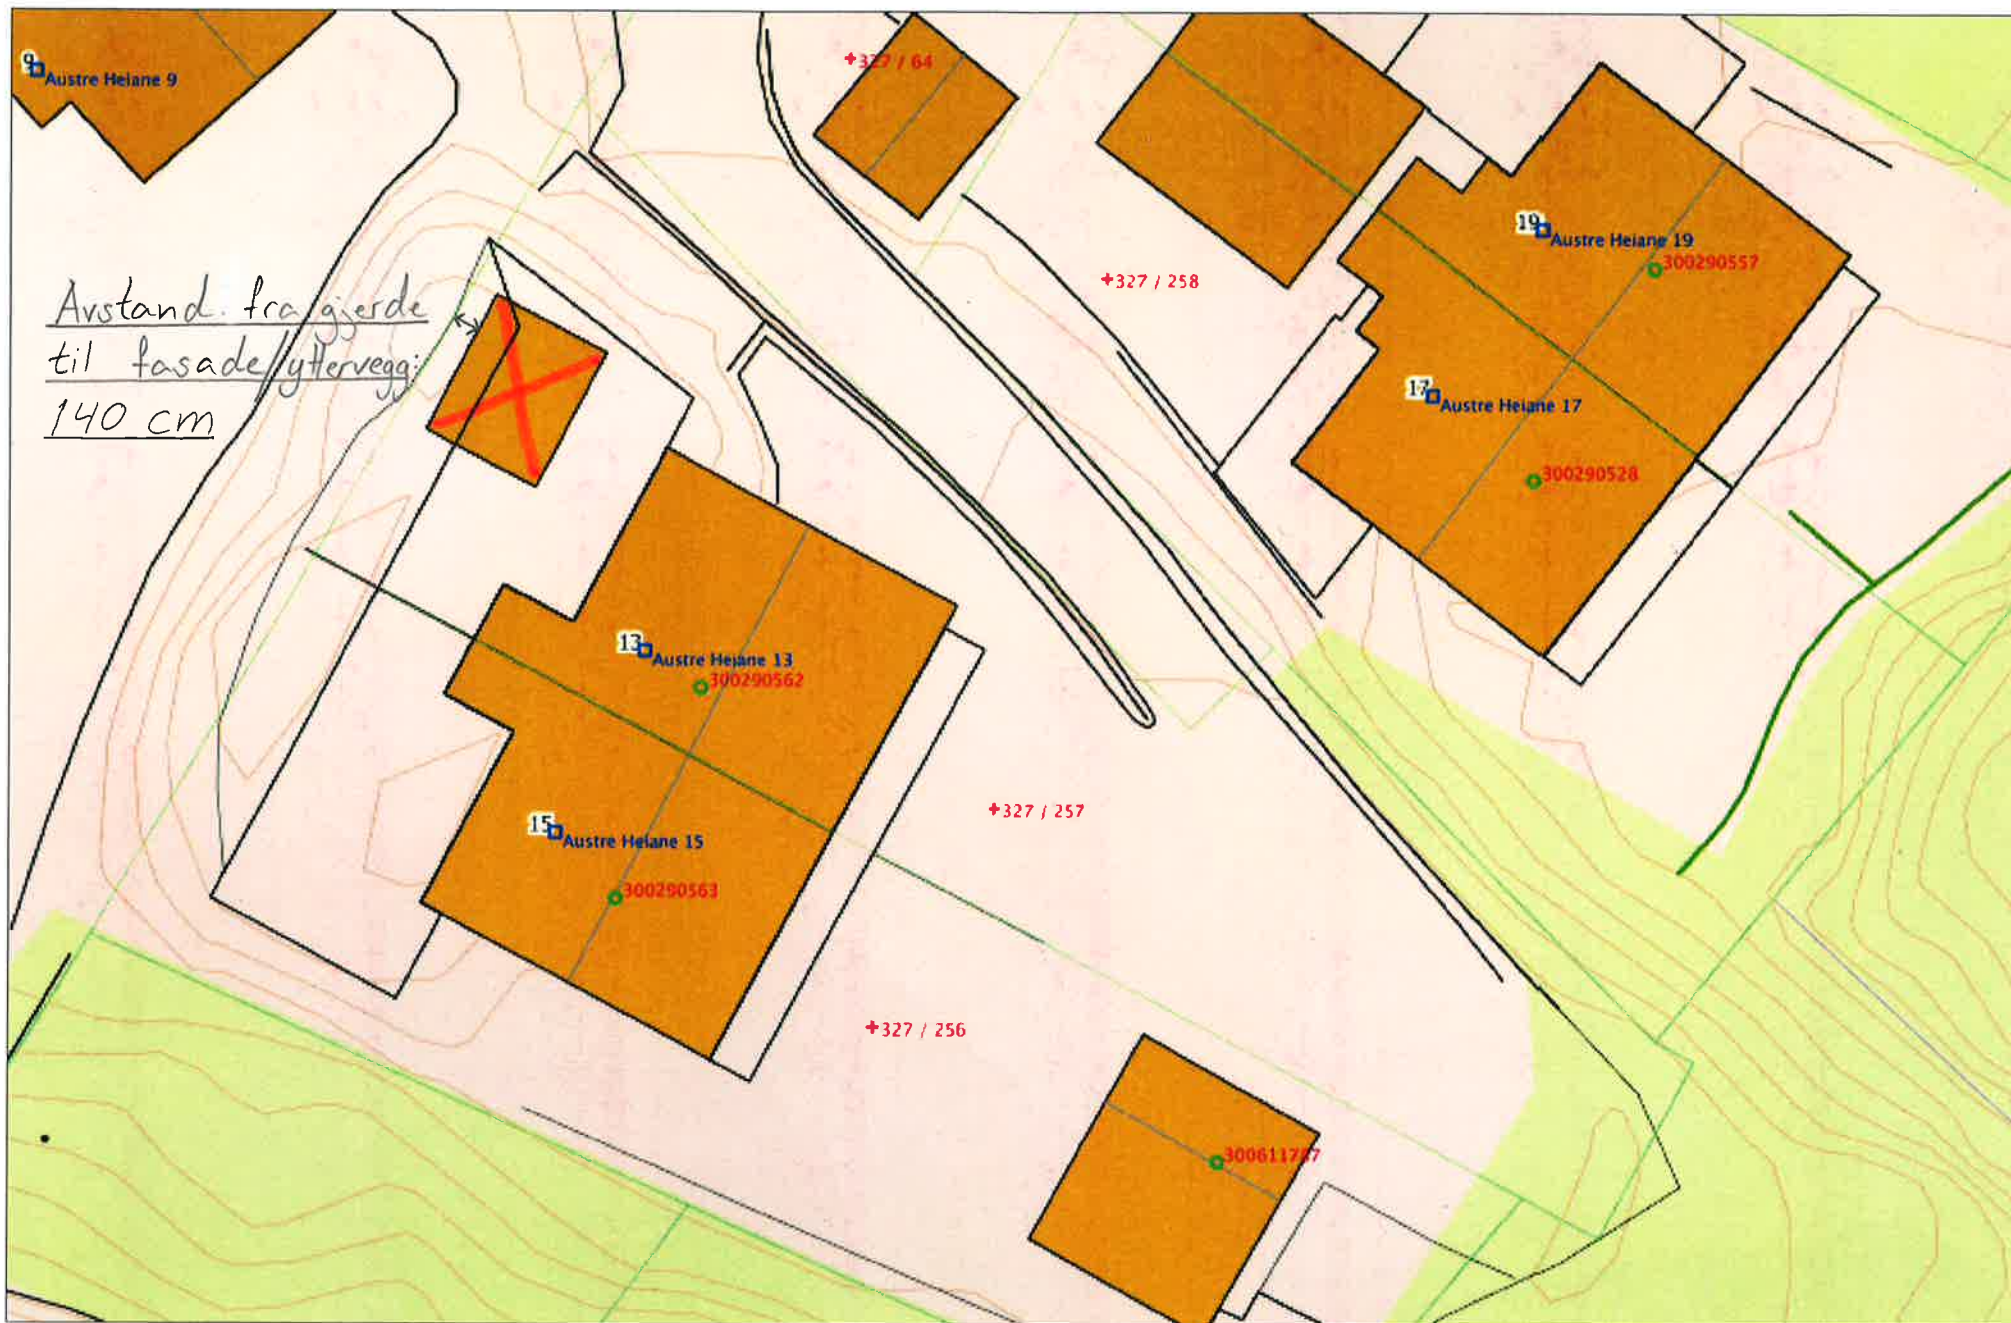

Senterposisjon: -35115.84, 6752841.56
Koordinatsystem: EPSG:25833
Utskriftsdato: 28.10.2020

0 2 4 6 8m