




1 Nord/Øst  
1 : 100

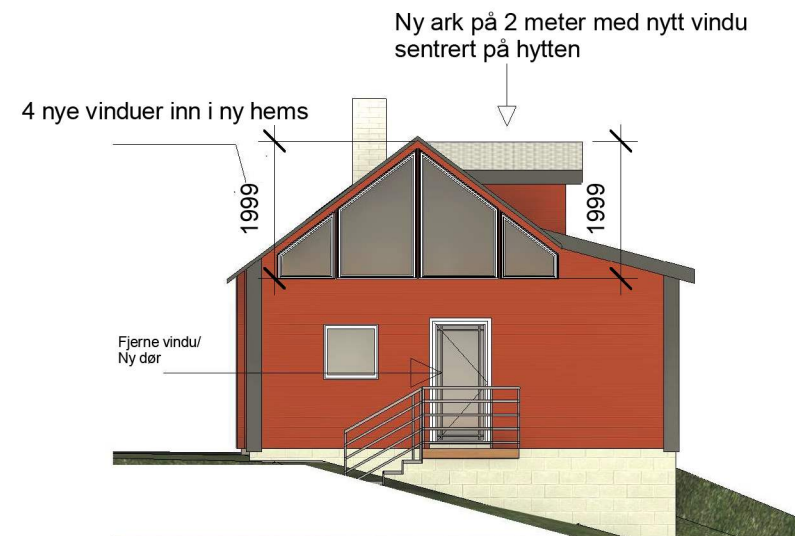

3 Nord/Vest  
1 : 100

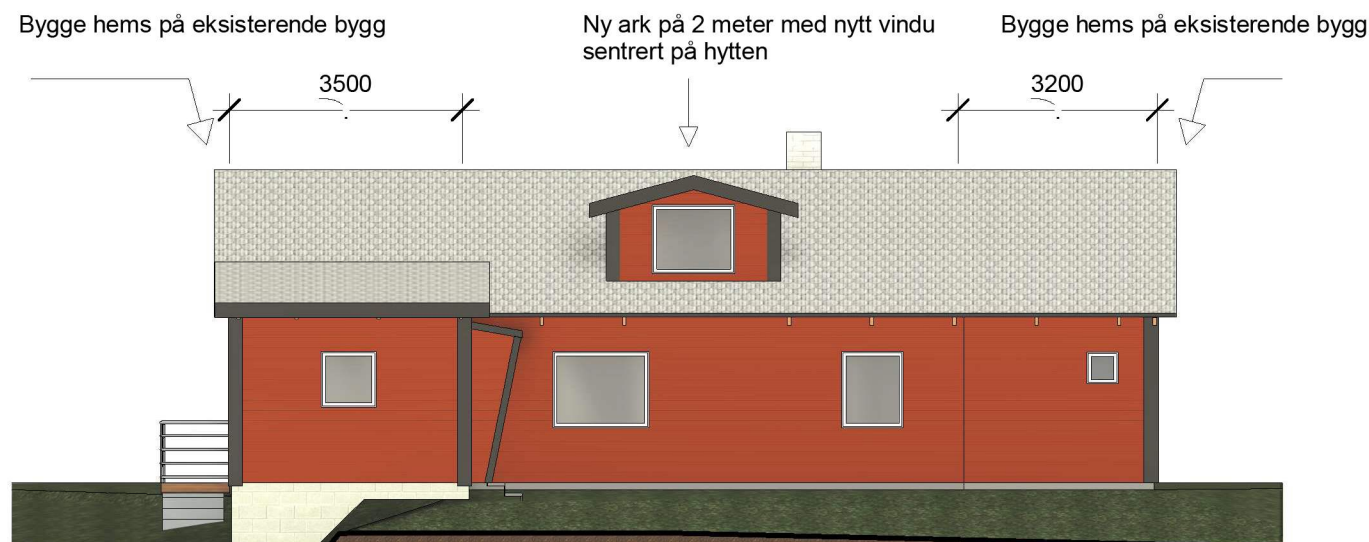

2 Sør/Vest  
1 : 100

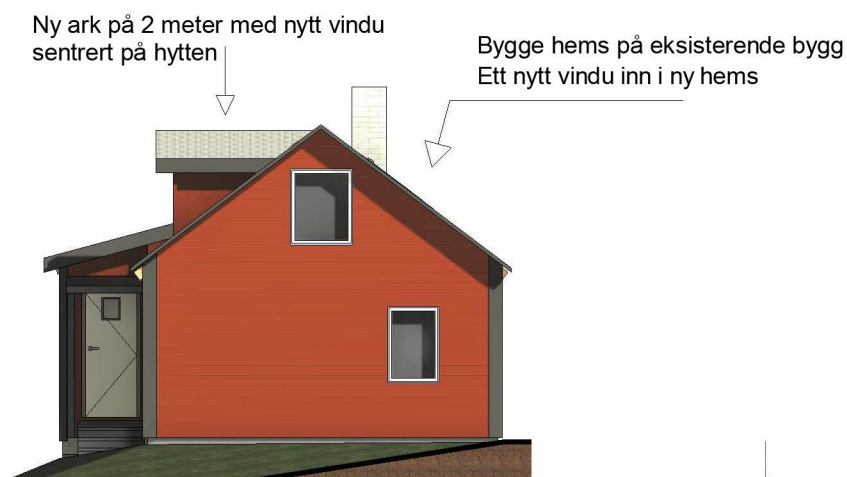

4 Sør/Øst  
1 : 100



Arkitekt Jameson AS

No.	Description	Date

Gunn Opdahl  
Fløholmen 30  
4631- 428/21

### Ny Fasade

Project number	0001	AA1101
Date	20.03.2020	
Drawn by	Jameson	Scale
Checked by	Checker	