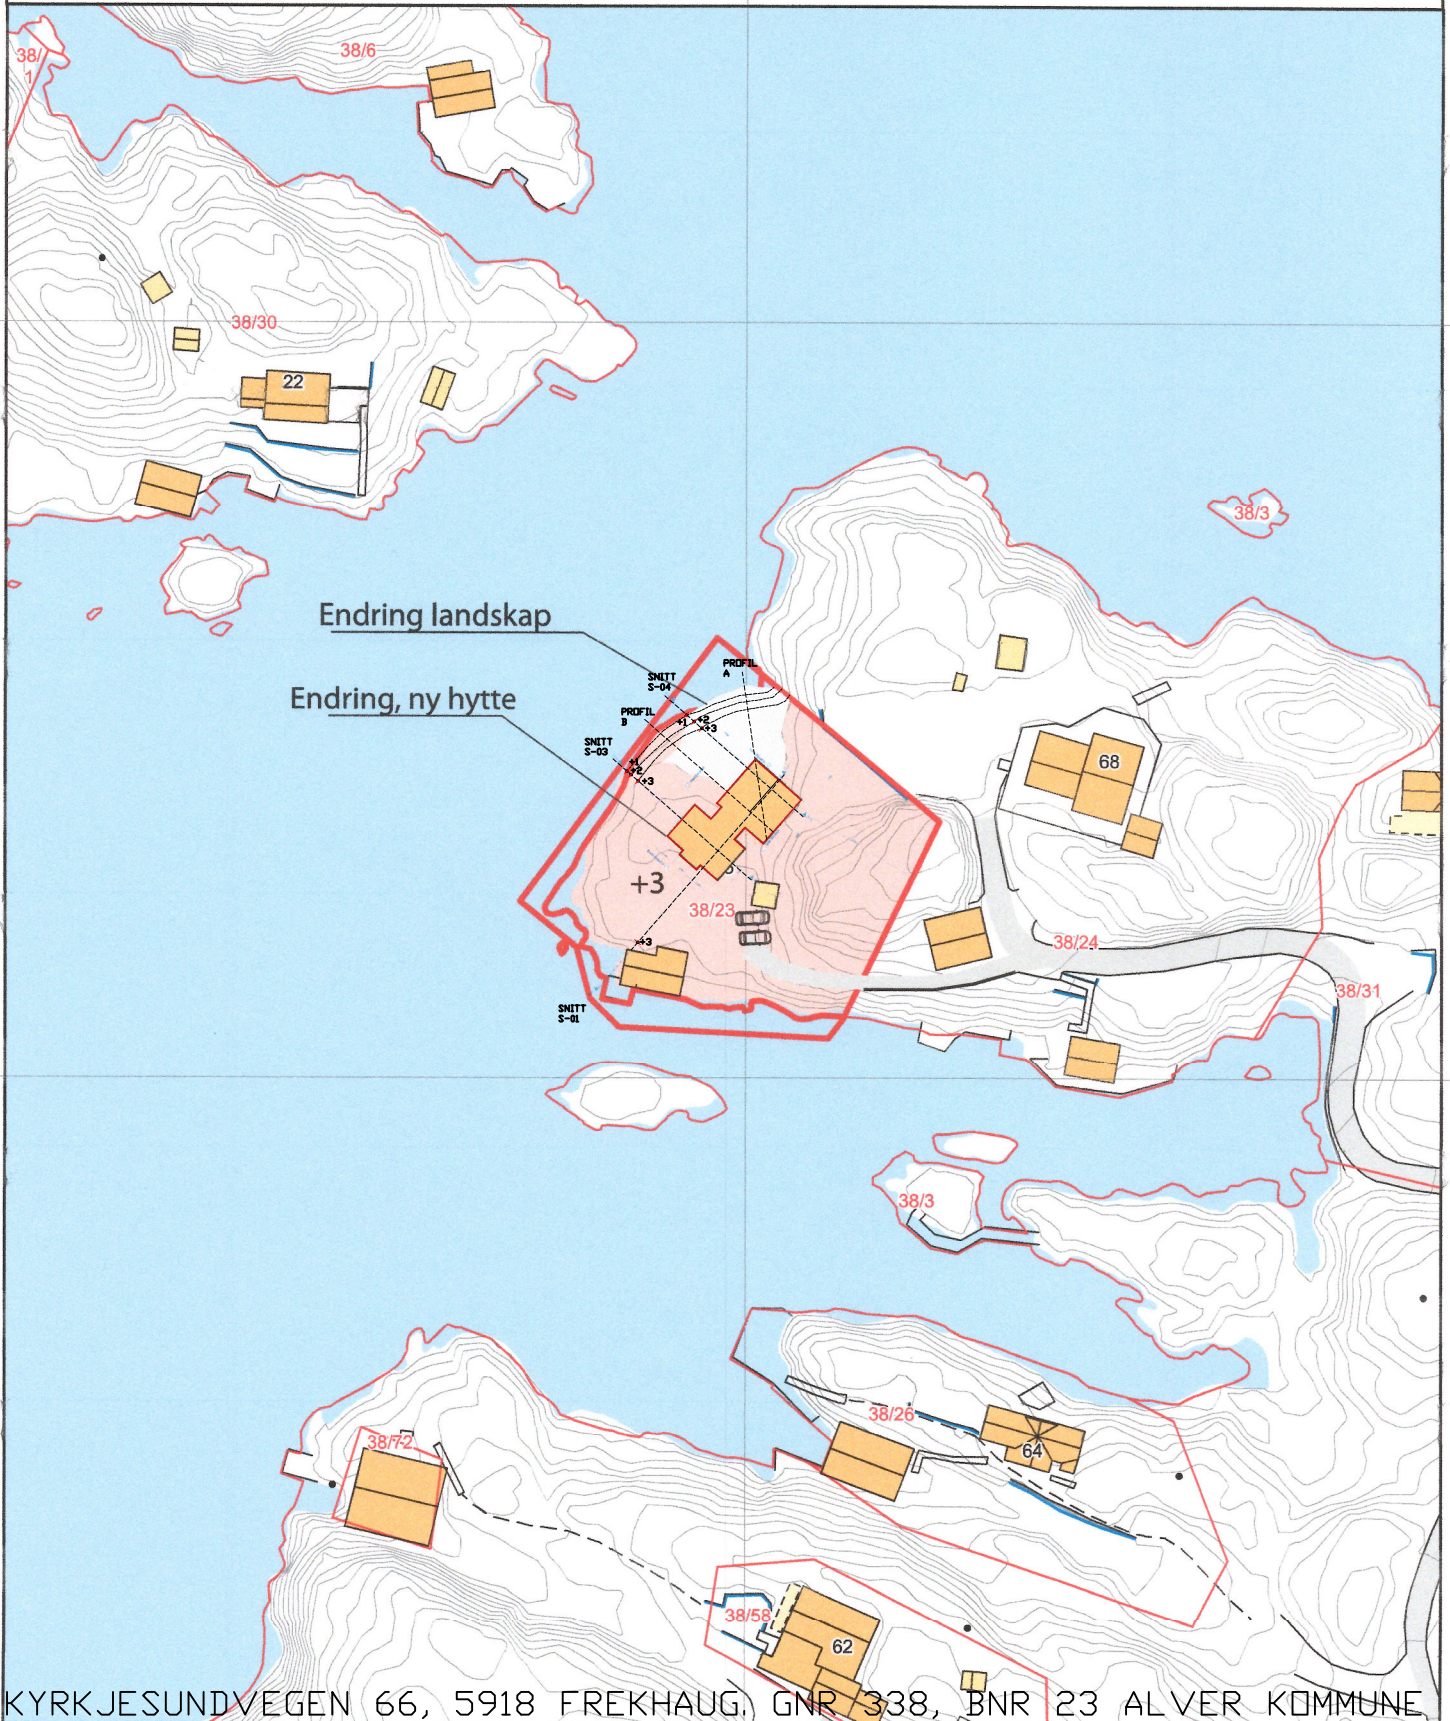


ambita

D3 Kommune: ~~1256 Meland~~ ALVER
Eiendom: ~~1256/38/23~~ 338/23Målestokk 1:1000
Date: 22.4.2016
DATUM: 03.12.2020

KYRKJESUNDVEGEN 66, 5918 FREKHAUG, GNR 338, BNR 23 ALVER KOMMUNE

0 25 50 m

Kartgrunnlag: Geovekst - 8193
Det tas forbehold om feil og mangler i kartet.