

Arkiv nr. 214-46

Arkiv nr. 214-46



Sjå ny teikning (rev.)
datert 22.11.1973.

GODSBEKE
2 NOV. 1973
Lindås Byggnadsråd

2 NOV. 1975

Lindås Byggningsråd


SV

SØ

TILBYGG
"LUNDEVOLL"
GNR 214 BNR 57

ARVID LØNDAL
EIKANGERVÅG


Målestokk	Tegn.	
1:100	Trac.	
	Kfr.	
Erstatning for:		
Erstattet av:		

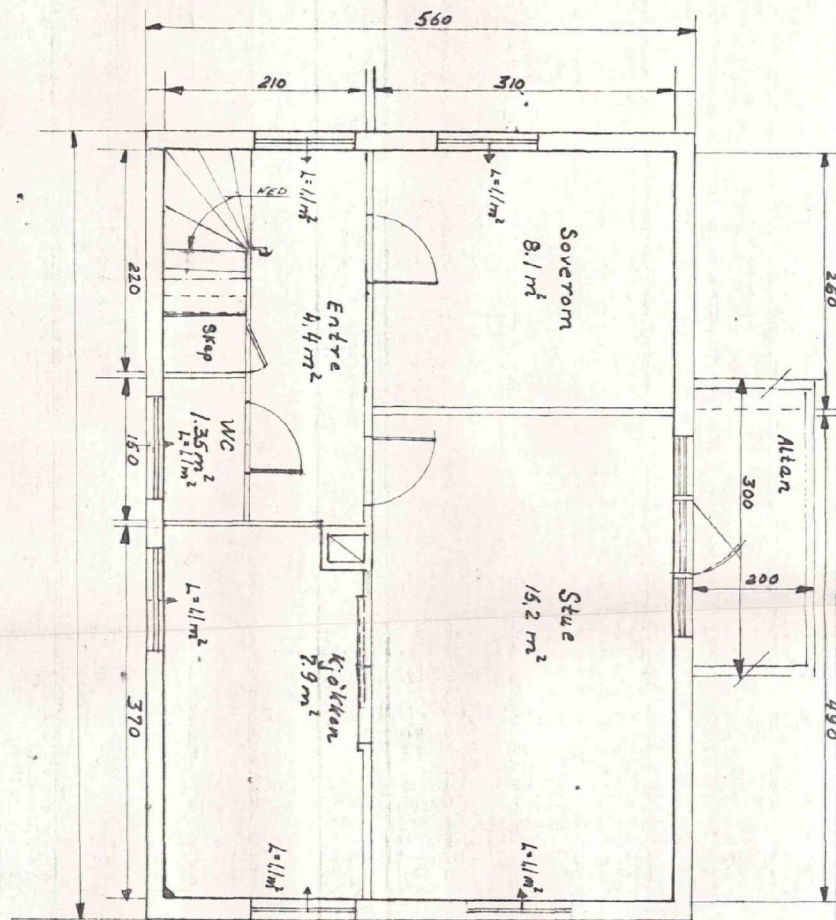


Innredning av 2. etage
til boligket

Målestokk	Tegn. A.L.	29-73
1:50	Trac.	
	Kr.	

783-22.5.73
Ark.no. 214-46

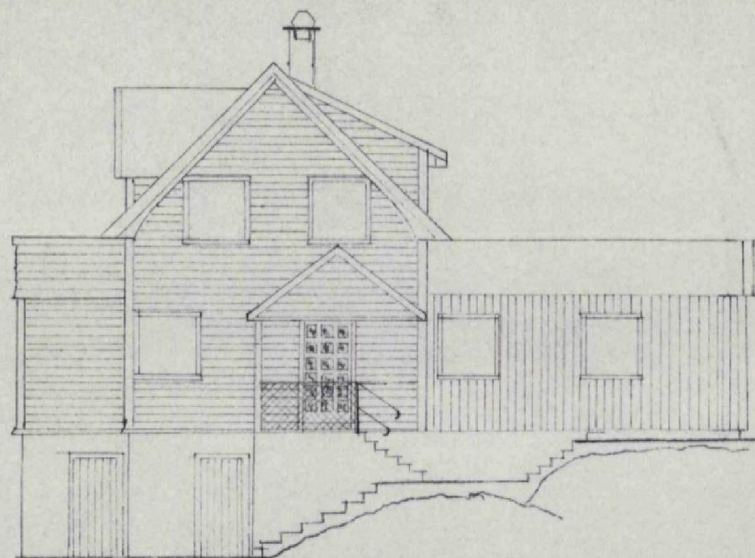


NØ

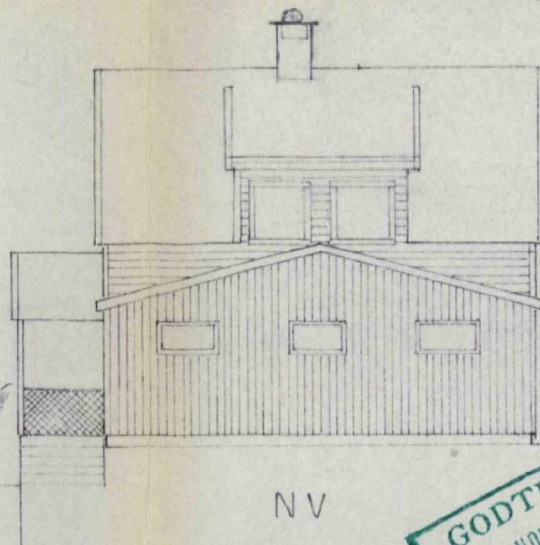


NV



GODTEKE
- 2 NOV. 1973
Lindås Bygningsråd

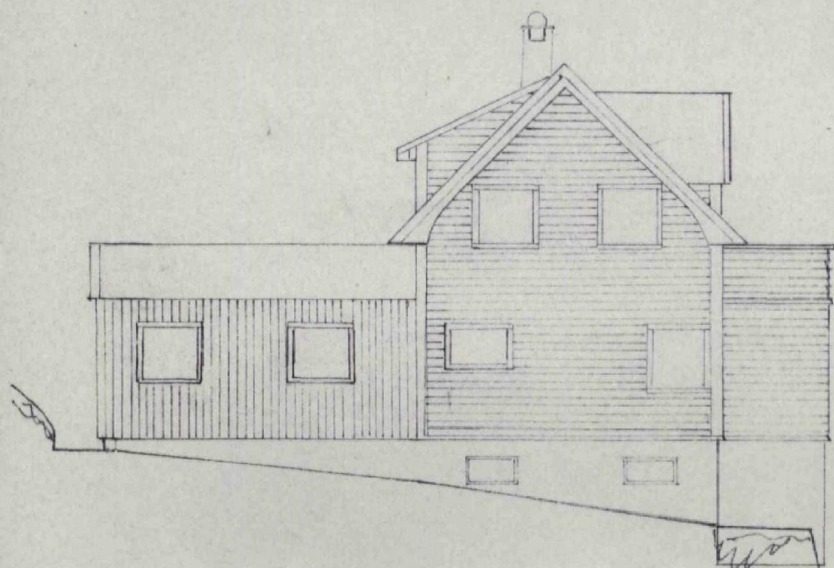

SV

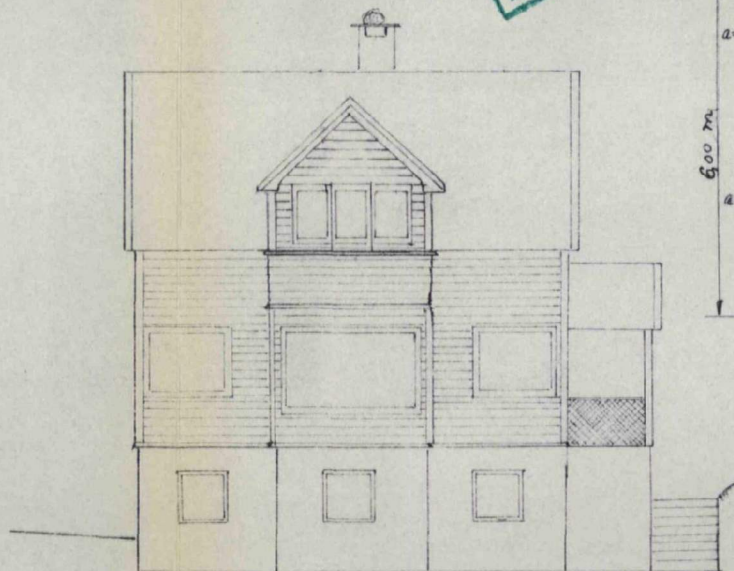

SØ

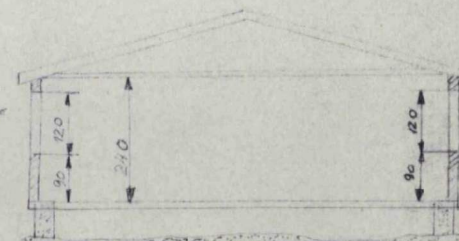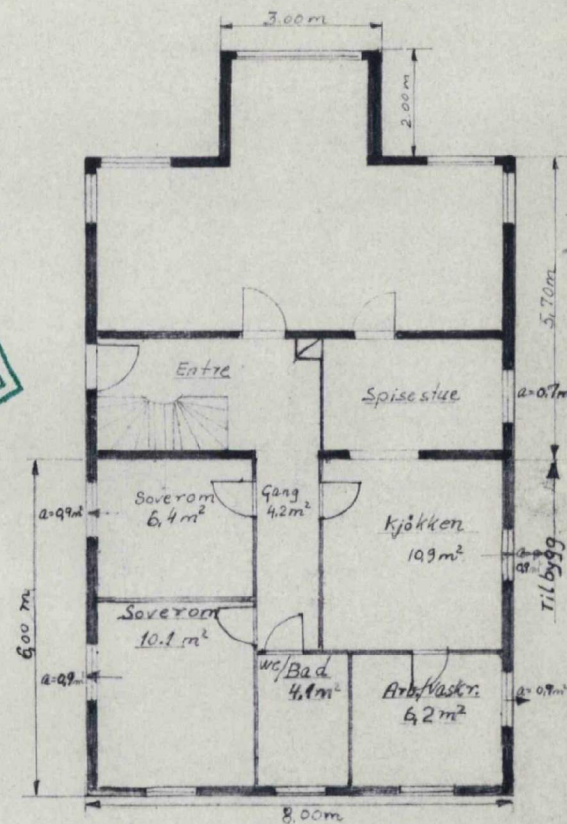

TILBYGG
"LUNDVOLL"
GNR 214 BNR 57
ARVID LØNDAL
EIKANGERVÅ G

Målestokk	Tegn.
1:100	Trac.
Erstatning for:	Kfr.
Korr. 22/11-1973	
Erstattet av:	