


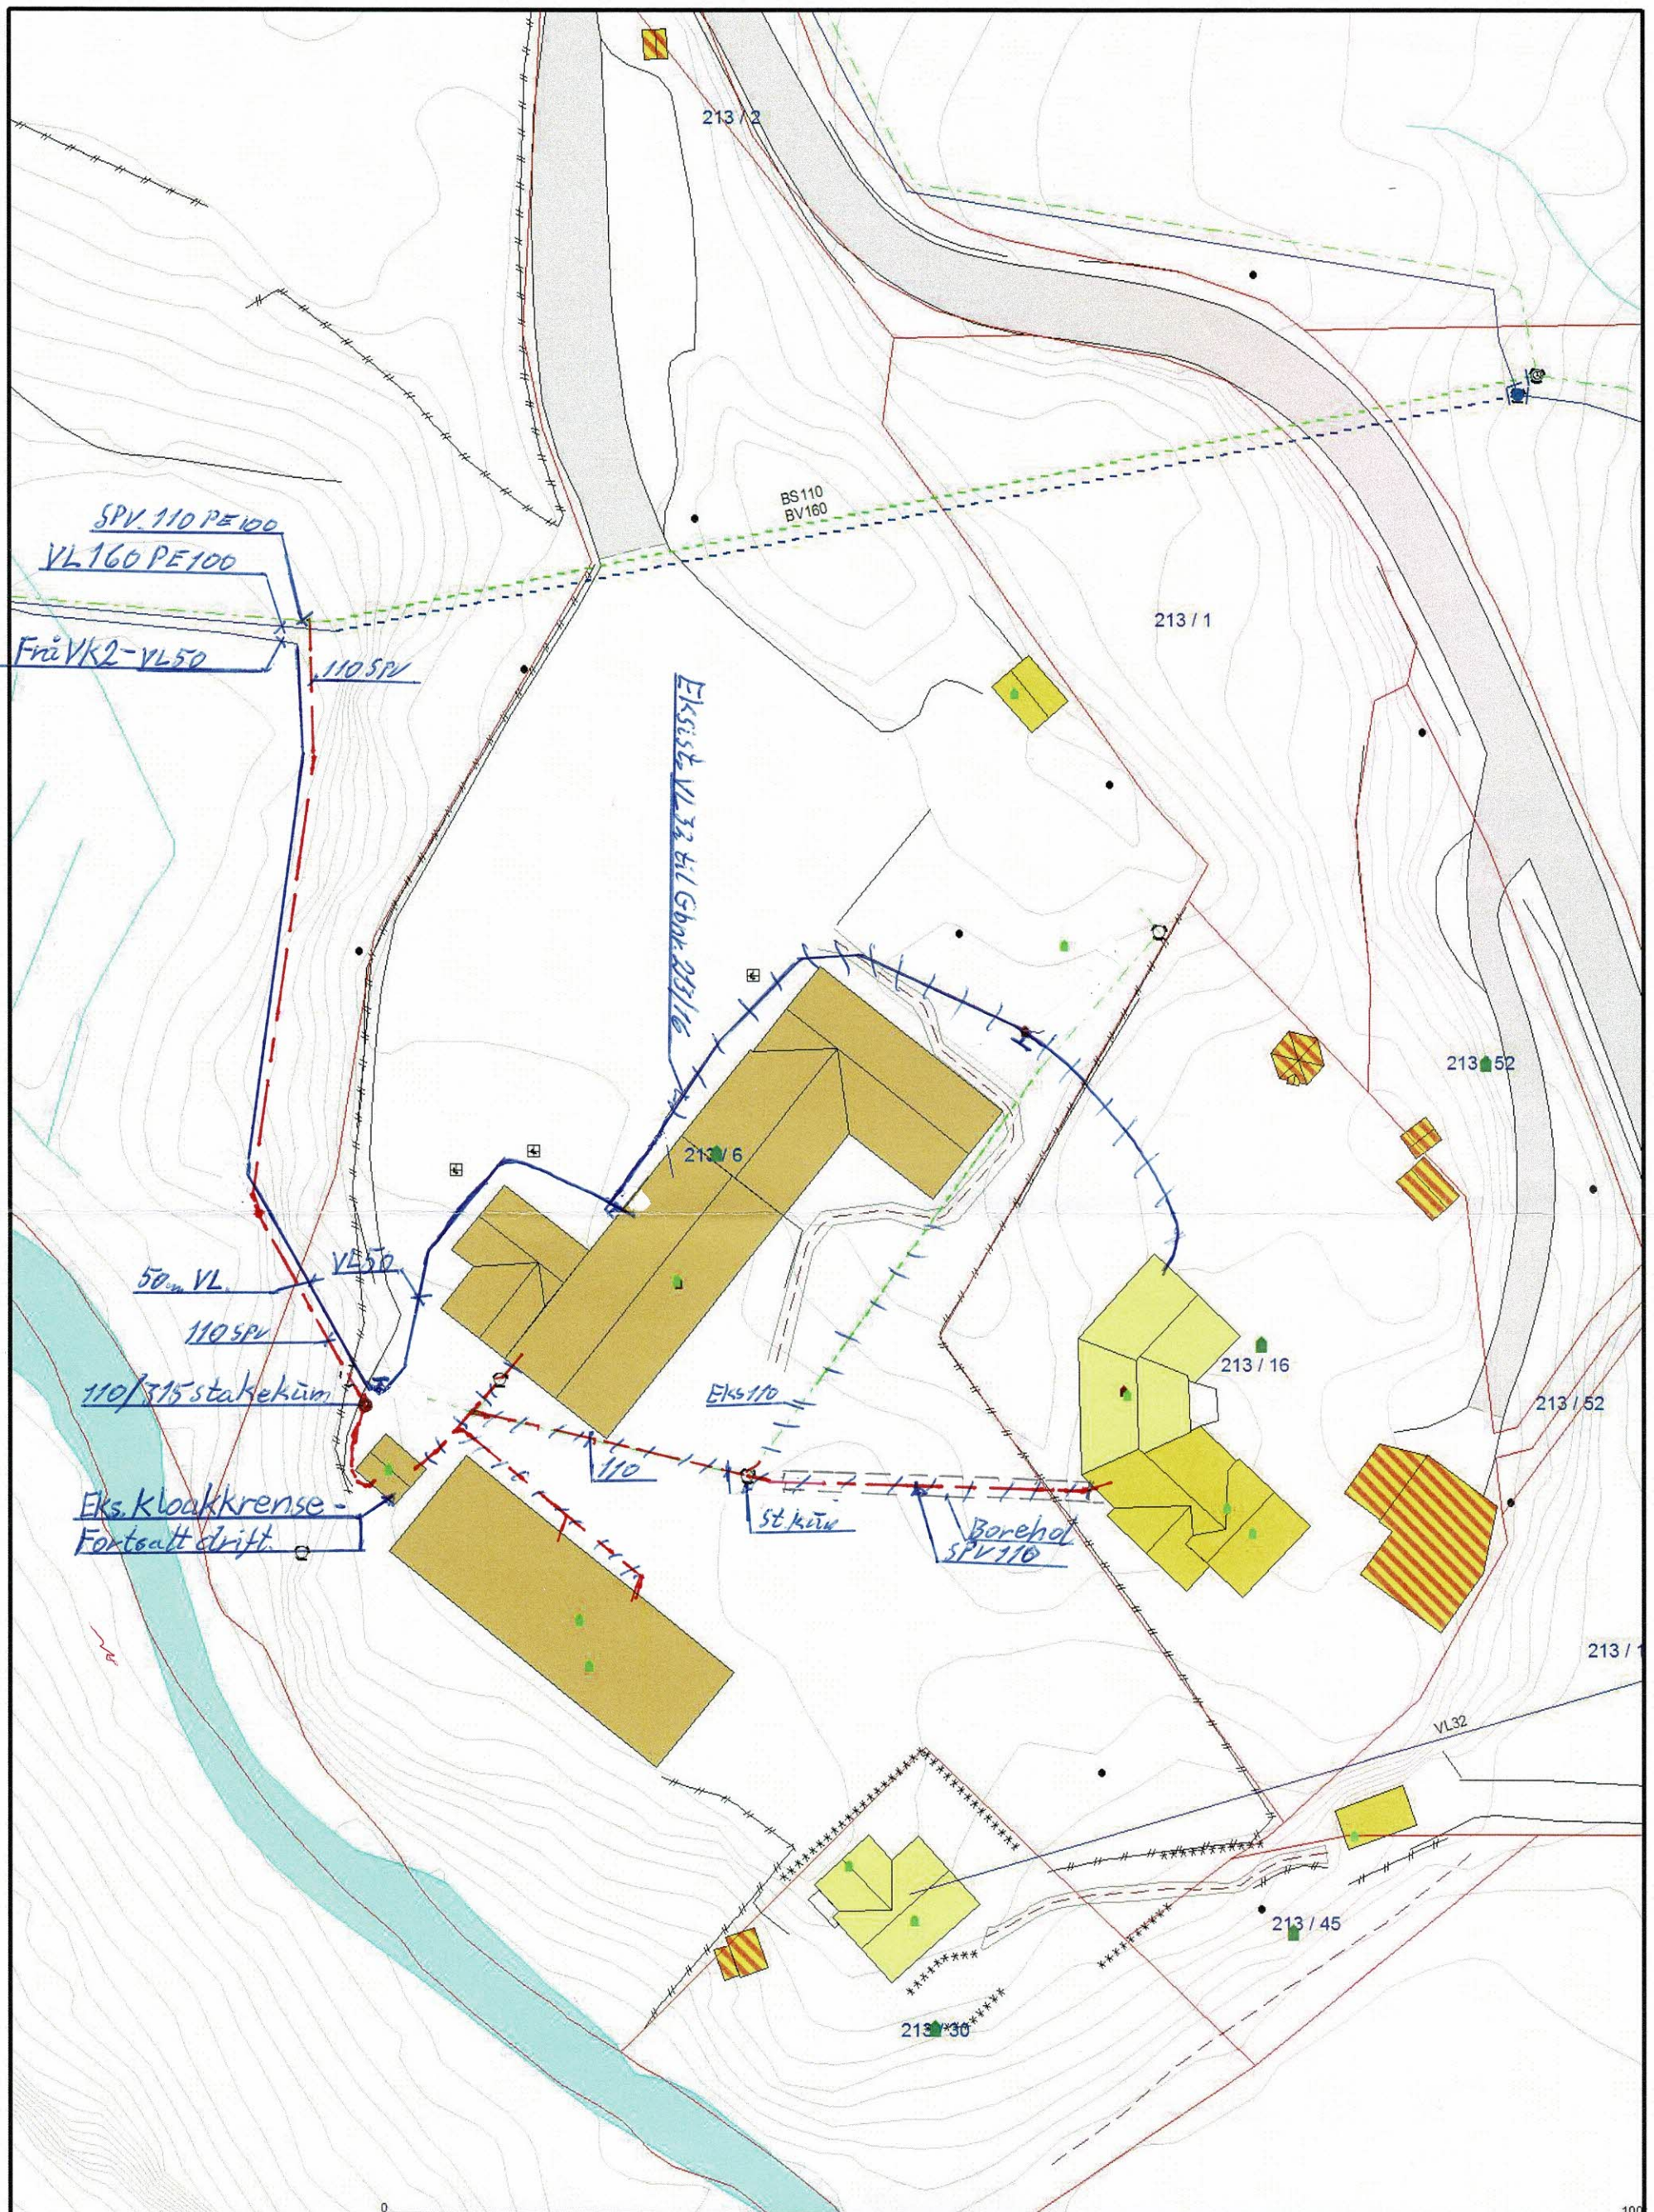

Målte Grenser Registrerte Grenser Udefinert grense Terrengmålte grense Konstruert grensepunkt Bolg Bustad m/leilighet	Våningshus Større bustader Hytte/feriehus Garasje/uthus Industri/lager Andre bygg	<u>Eikanger Skille</u> <u>Fyllingnesv. 352, 5913 Eikanger</u> <u>Gbnr. 213/6</u> <u>10.06.2020</u> LN	Dato: 2020.08.25 Sign: AH	Alver kommune VVA Avdeling <u>Utv. Leidninger VL-SPV</u>	N Målestokk 1:500
--	---	--	---	---	--