


~~TOM LILLESKARE~~
GNC 196 BNC 8/10



COMFORT KNARVIK

AS Haugland VVS

Lyngvn. 2, 5914 ISDALSTØ
56 35 77 94

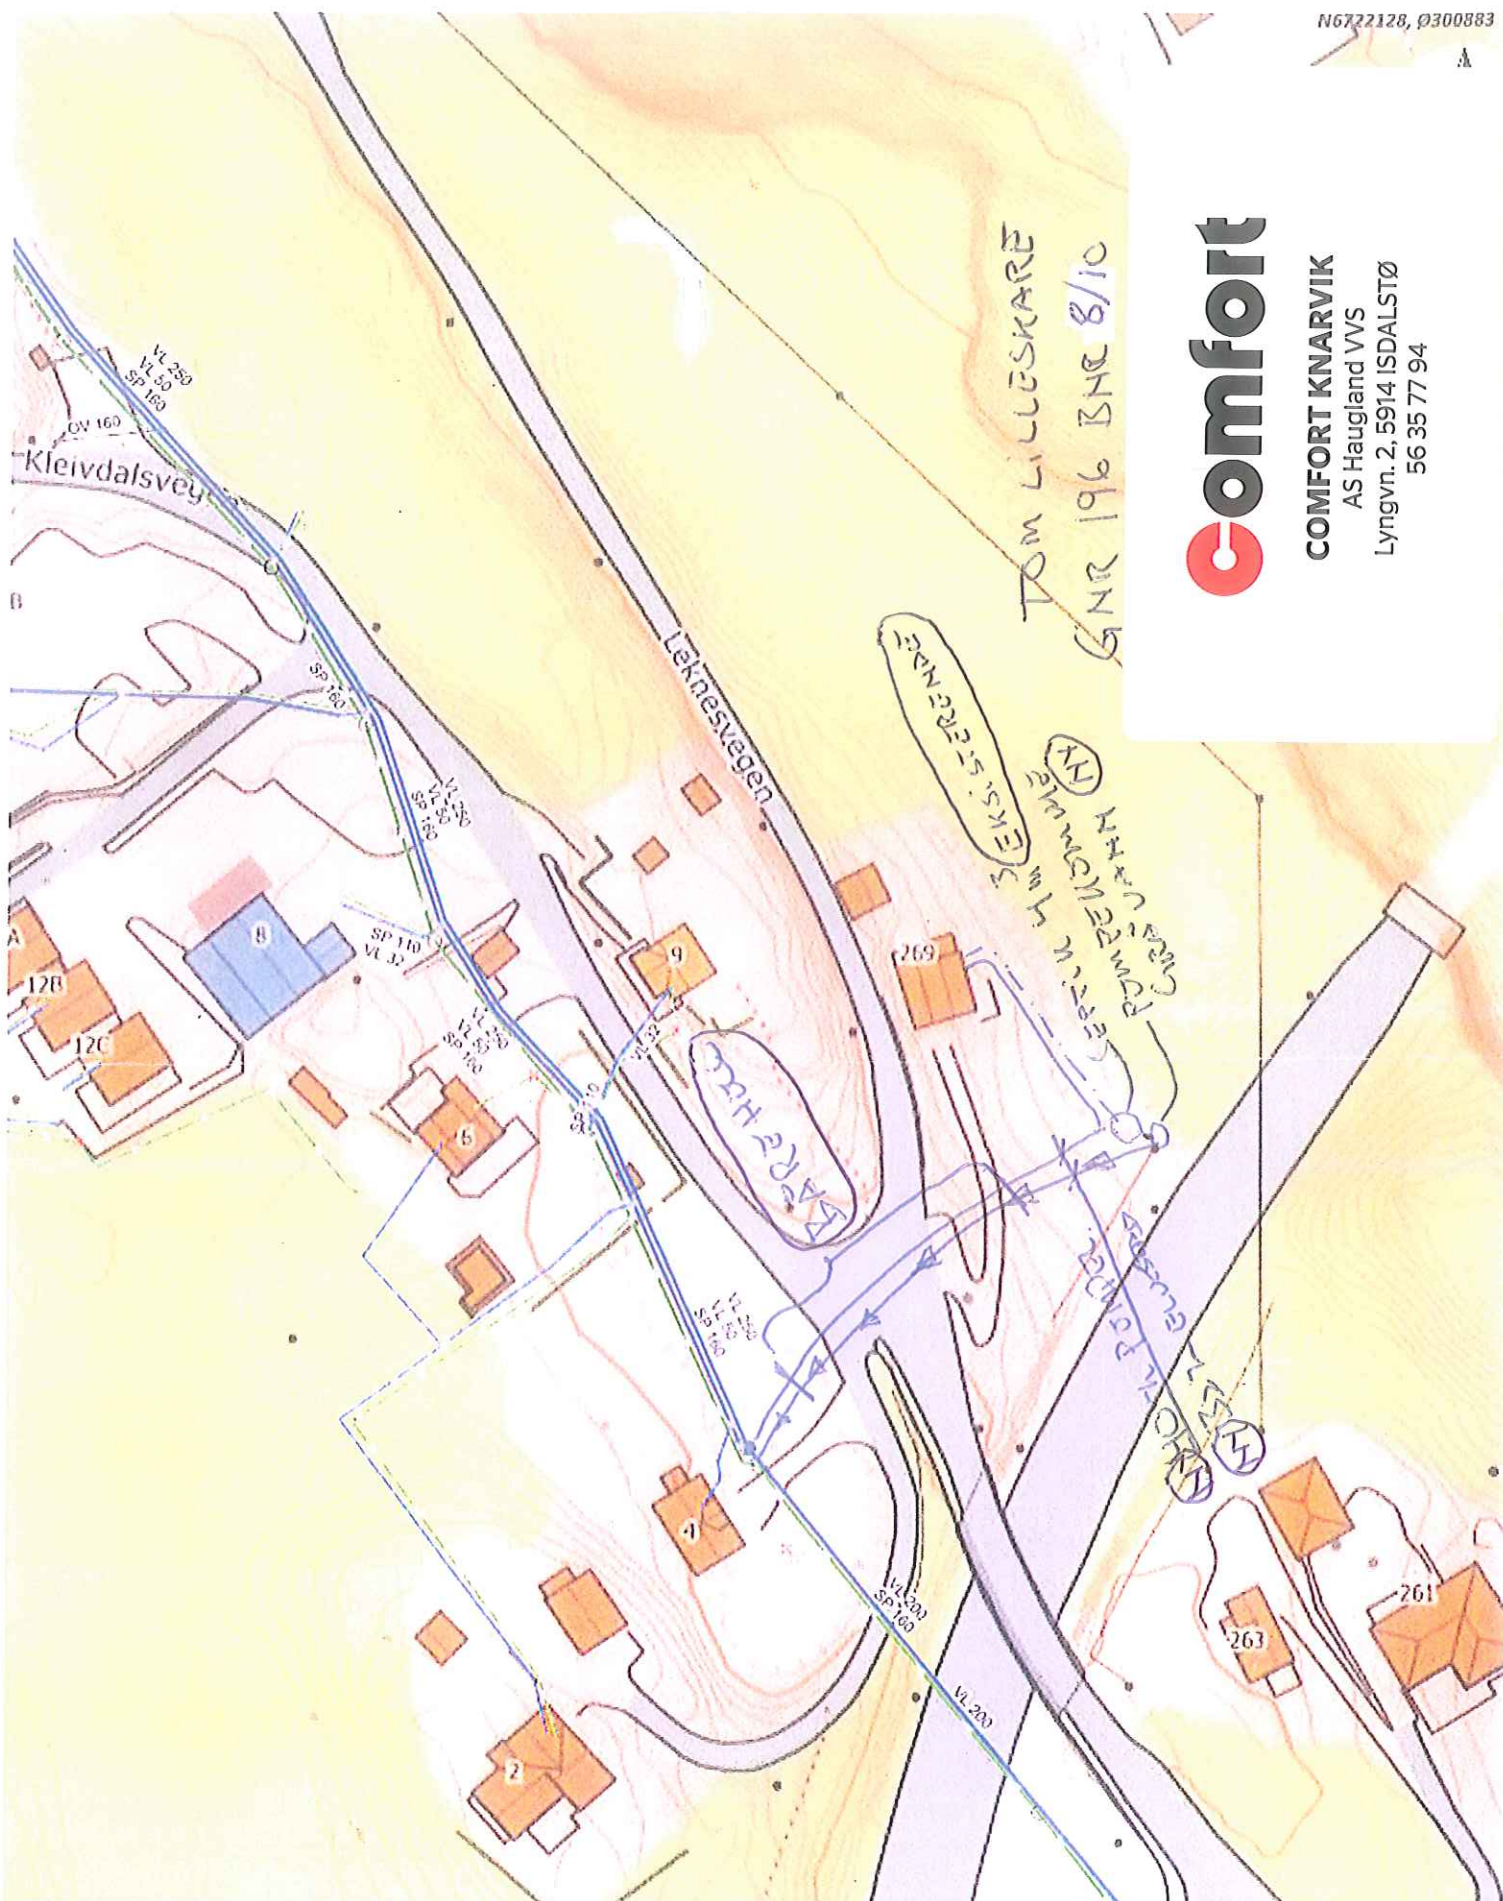

Dato: 06-10-2020

NHdigi.no

Målestokk: 1:1 000

 30m