
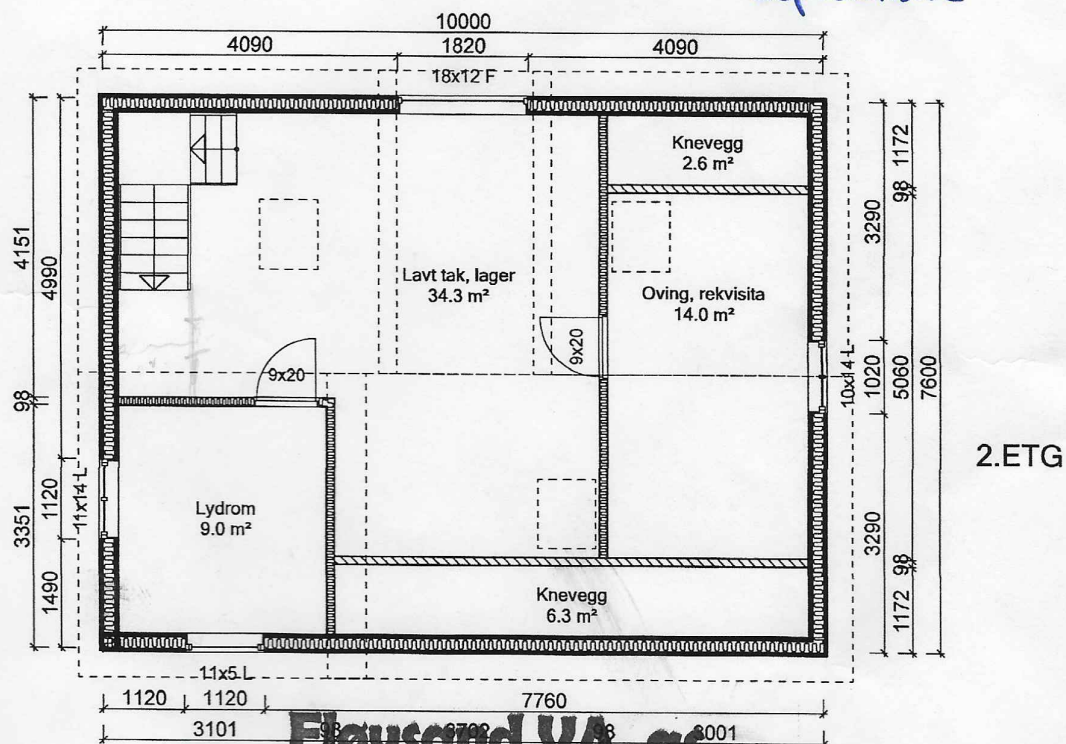


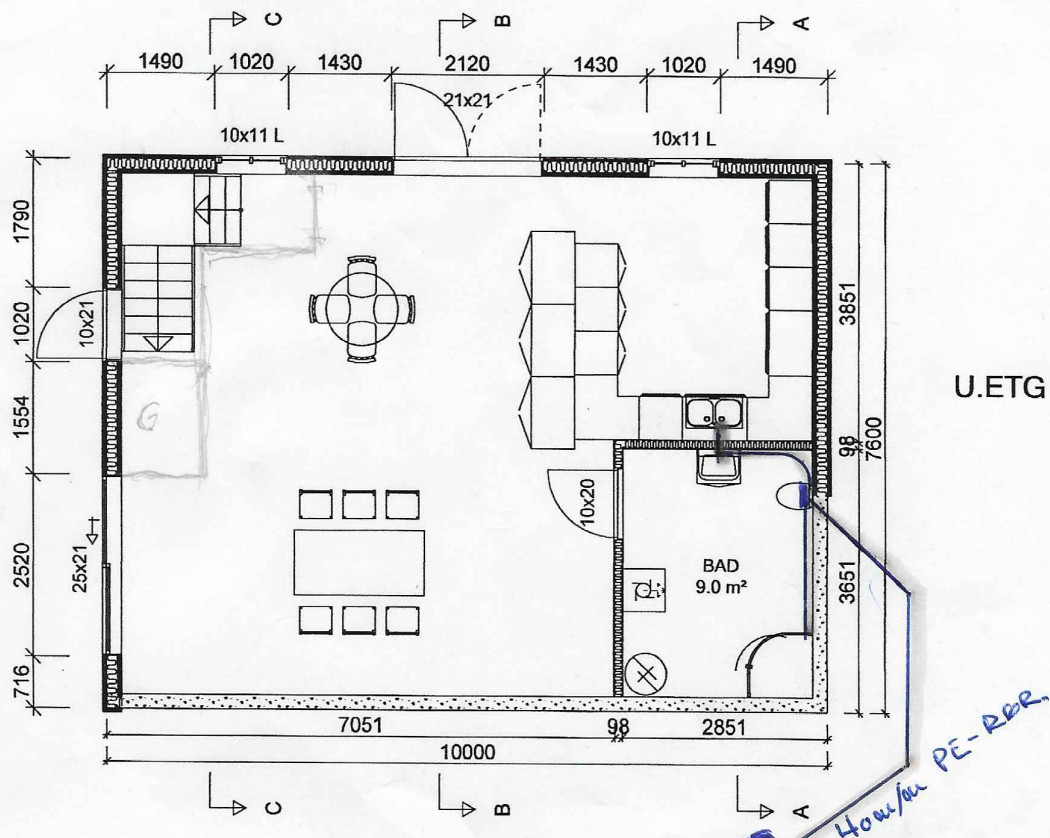

**BYGGMESTER**  
**HAGEWICK**

**Fløysand VA, as**

**Rørlegger**

**Mob. 952 73 505**

**Fløysand, 5918 Frekhaug**

**Org.nr.: No 987 774 525 MVA**

*Handwritten signature and date: 4.2.2021*