

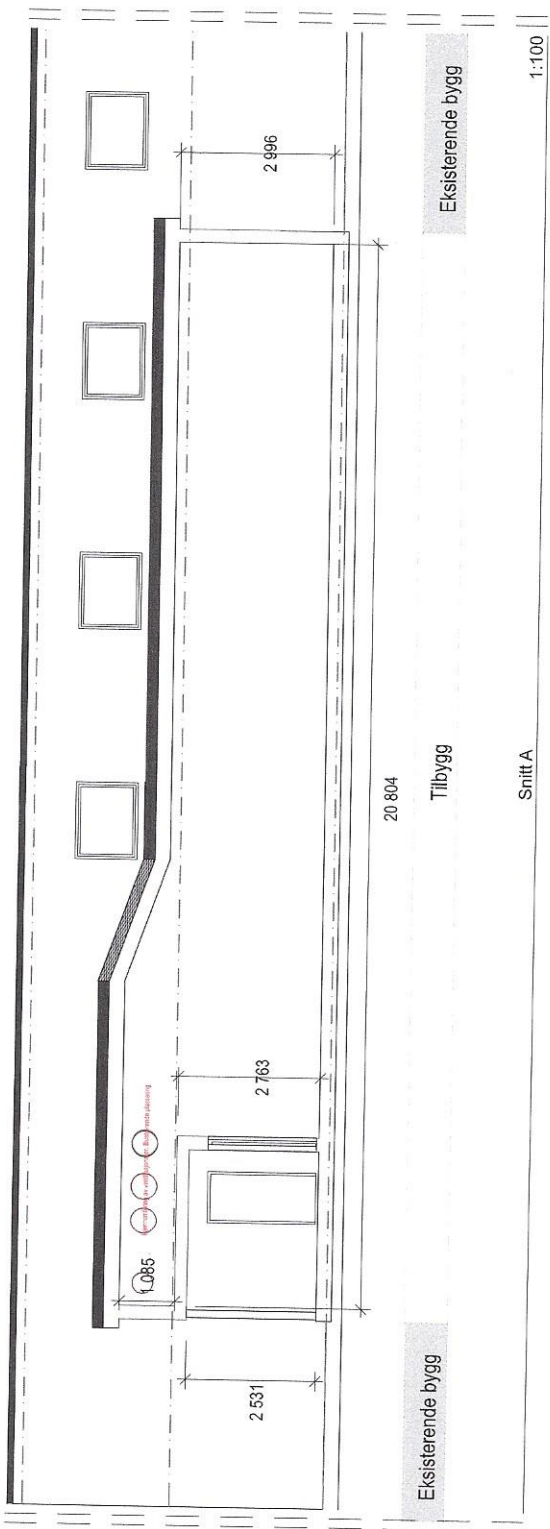



E1

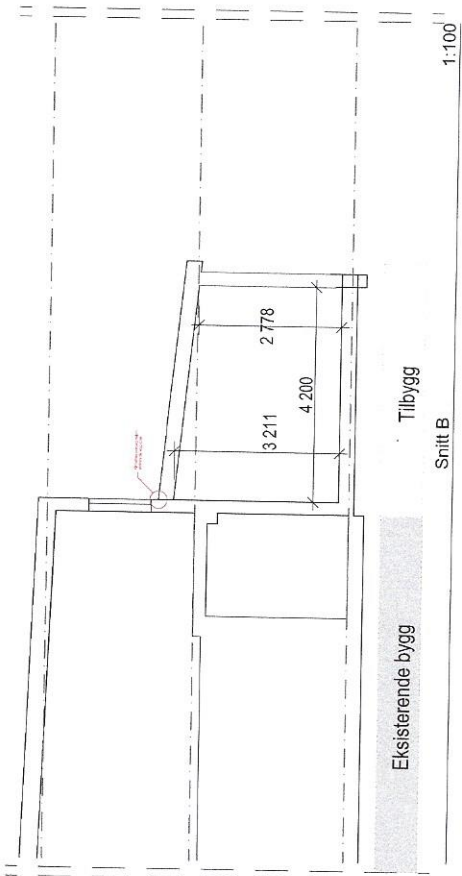


E2

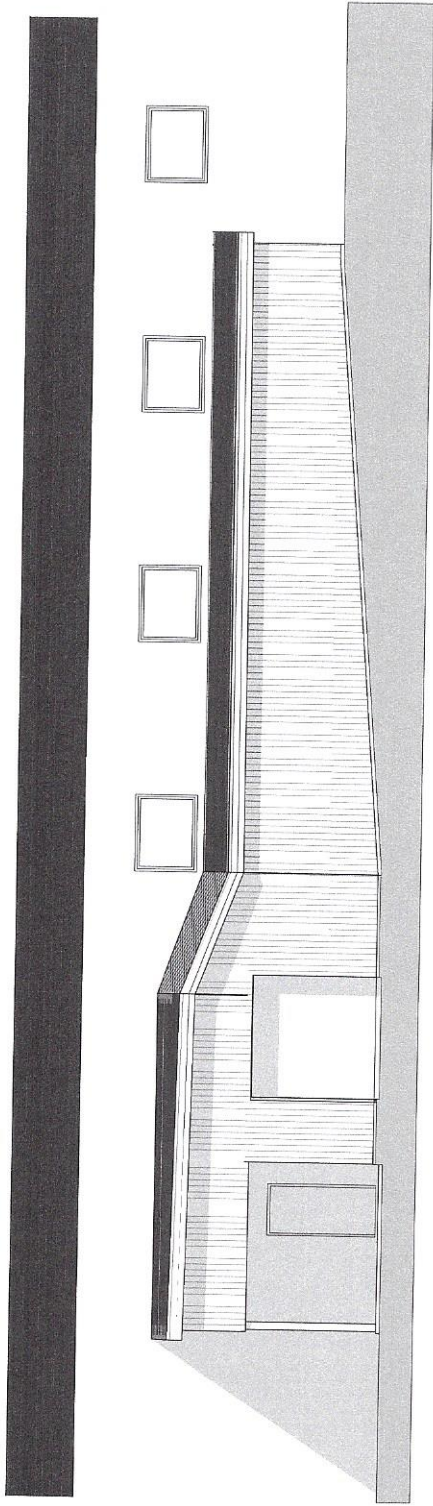

Fasade Øst
1:100

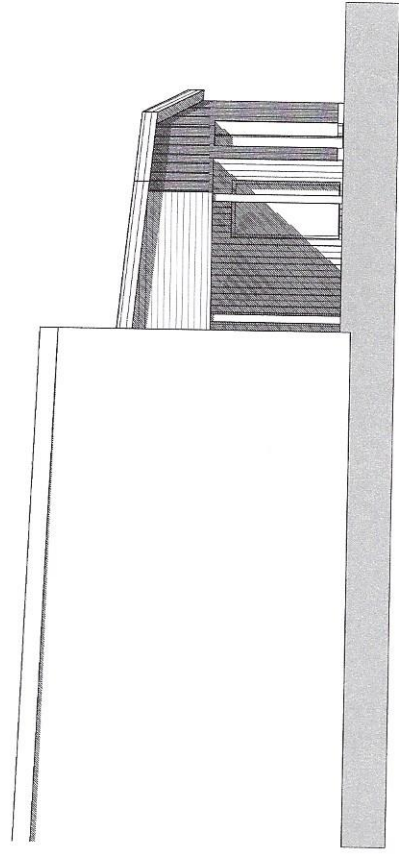

Fasade Sør
1:100

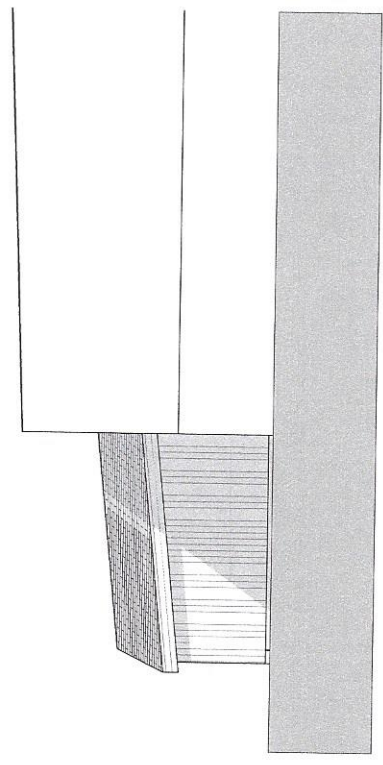

Fasade Nord
1:100

