


25.01.21 Tegn. Thunold M.1:100

Bolig for Øystein Toppe Thunold
Heiane 24 gnr 27 bnr.151

Tegning:
Plan 2 etg.

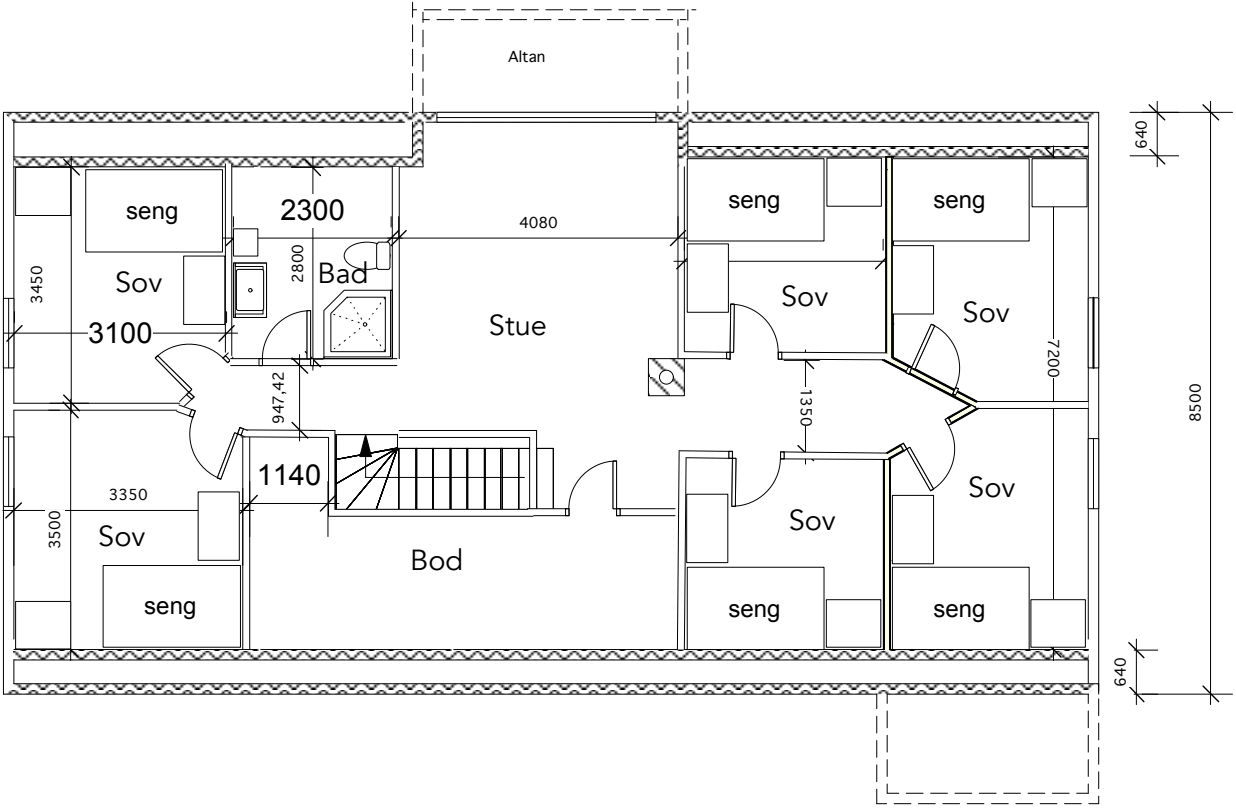



Reviderte tegninger
den 14.03.06

04.09.03	Tegn.S.Thunold	M.1:100	
Bolig for Øystein Toppe Thunold Heiane 24 gnr 27 bnr.151			Tegning: Fasade

