

INNMÅLINGSTJENESTER AS



Organisasjonsnr.979 927 703
Bankgiro:3624 07 79751

Vår ref:

Deres ref:

Dato:23.02.21.

Knut Henanger
Frekhaug Bolig as

Stikningsdata for hytte i Brusundet på Lygra, Gnr.58 Bnr.151,
Alver Kommune

| HYTTE PUNKT | TEMA | X | Y |
|----------------|------|-------------|------------|
| 05 1 | 5000 | 6733407.406 | 289377.638 |
| 05 2 | 5000 | 6733402.104 | 289371.123 |
| 05 3 | 5000 | 6733397.916 | 289374.532 |
| 05 4 | 5000 | 6733397.537 | 289374.067 |
| 05 5 | 5000 | 6733395.210 | 289375.961 |
| 05 6 | 5000 | 6733395.589 | 289376.426 |
| 05 7 | 5000 | 6733390.936 | 289380.214 |
| 05 8 | 5000 | 6733396.239 | 289386.728 |
| 05 9 | 5000 | 6733401.357 | 289382.562 |
| 05 10 | 5000 | 6733400.600 | 289381.631 |
| 05 11 | 5000 | 6733402.461 | 289380.116 |
| 05 12 | 5000 | 6733403.219 | 289381.047 |
| TOMTEN | | | |
| 05 14 | 4011 | 6733381.790 | 289379.790 |
| 05 15 | 4011 | 6733393.720 | 289354.160 |
| 05 16 | 4011 | 6733420.380 | 289373.050 |
| 05 17 | 4011 | 6733399.580 | 289403.130 |
| 05 18 | 4011 | 6733387.630 | 289399.940 |
| 05 19 | 4011 | 6733382.770 | 289390.810 |

Med vennlig hilsen
Innmålingstjenester as

Kjersti K. Madsen

Kontoradresse:
Telefon
Kjersti K. Madsen
Johnny Sandvik

Helgeplasset 144
55 59 02 77 (76)
Mob.tlf.90 78 72 08
Mob.tlf.40 40 23 23

5148 Fyllingsdalen
E.Post: innmal@innmal.no



Y 289350


Y 289400

Stikningsskisse for Gnr.58 Bnr.151

X 6733450

Brusundet, Alver Kommune

X 6733400

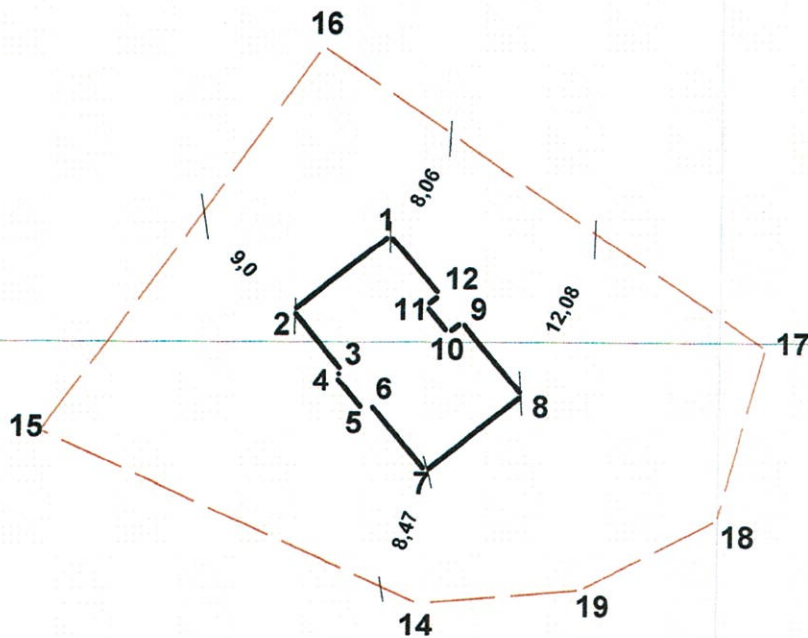

X 6733350



Stikningsskisse for Gnr.58 Bnr.151
Brusundet, Alver Kommune
Hellevik Hus, Frekhaug Bolig as
Dato: 23/02/21

Målestokk 1:500

Innmålingstjenester as

Kjersti K. Madson