

VEDLEGG D-2

5

HAUKELAND INVEST A/S


AVKØRSSELSPLAN

74/58

9/9-13

D. Kope

| | | |
|-----------------|--------------|-----------|
| RADBY KOM. SINE | JOURNAL NR. | 13/2116 |
| 14/5 | 10 SEPT 2013 | 13/2116-5 |
| 10 SEPT 2013 | 10 SEPT 2013 | |
| 74/58 | | |

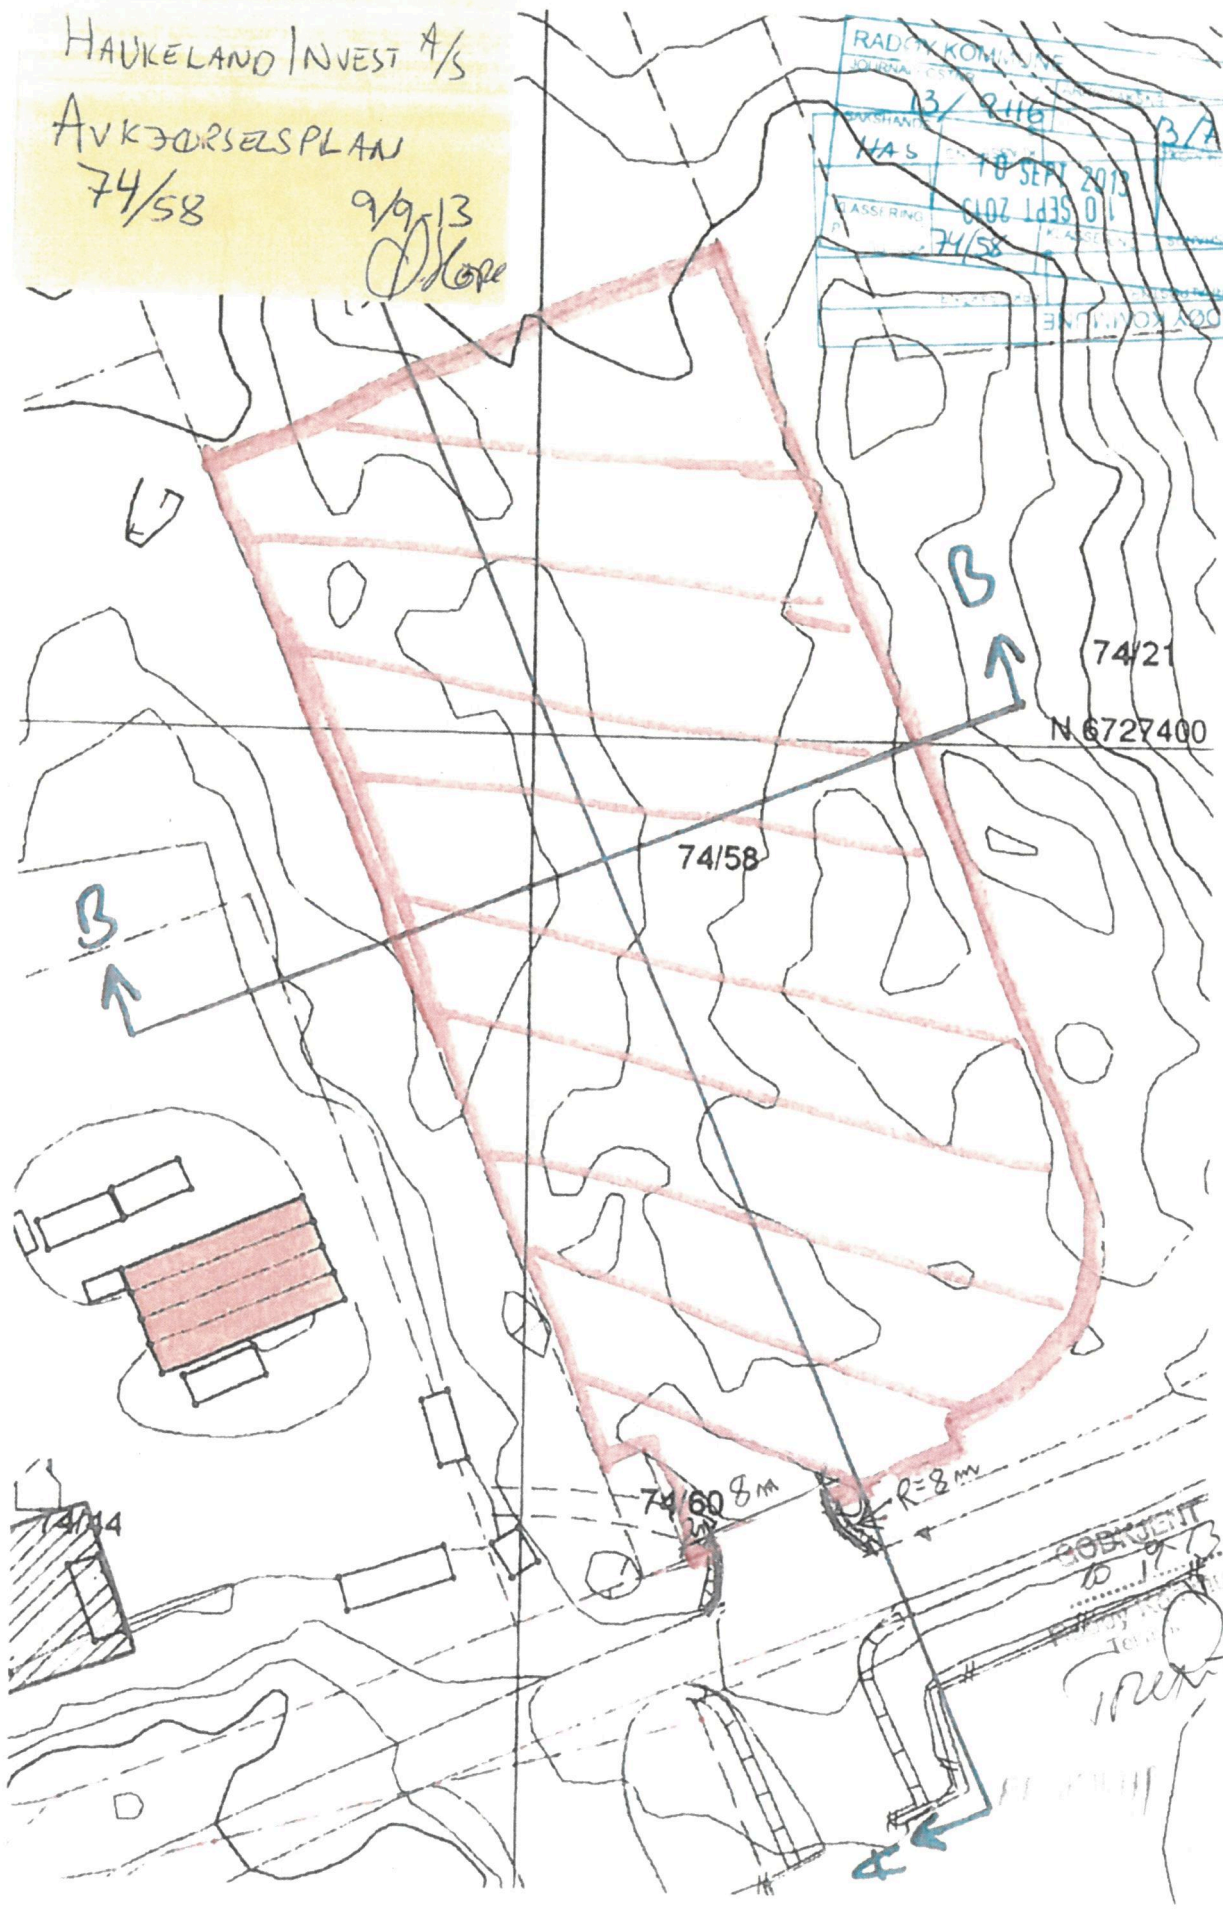

FORBENT
10 19 13
Tegn
[Signature]