



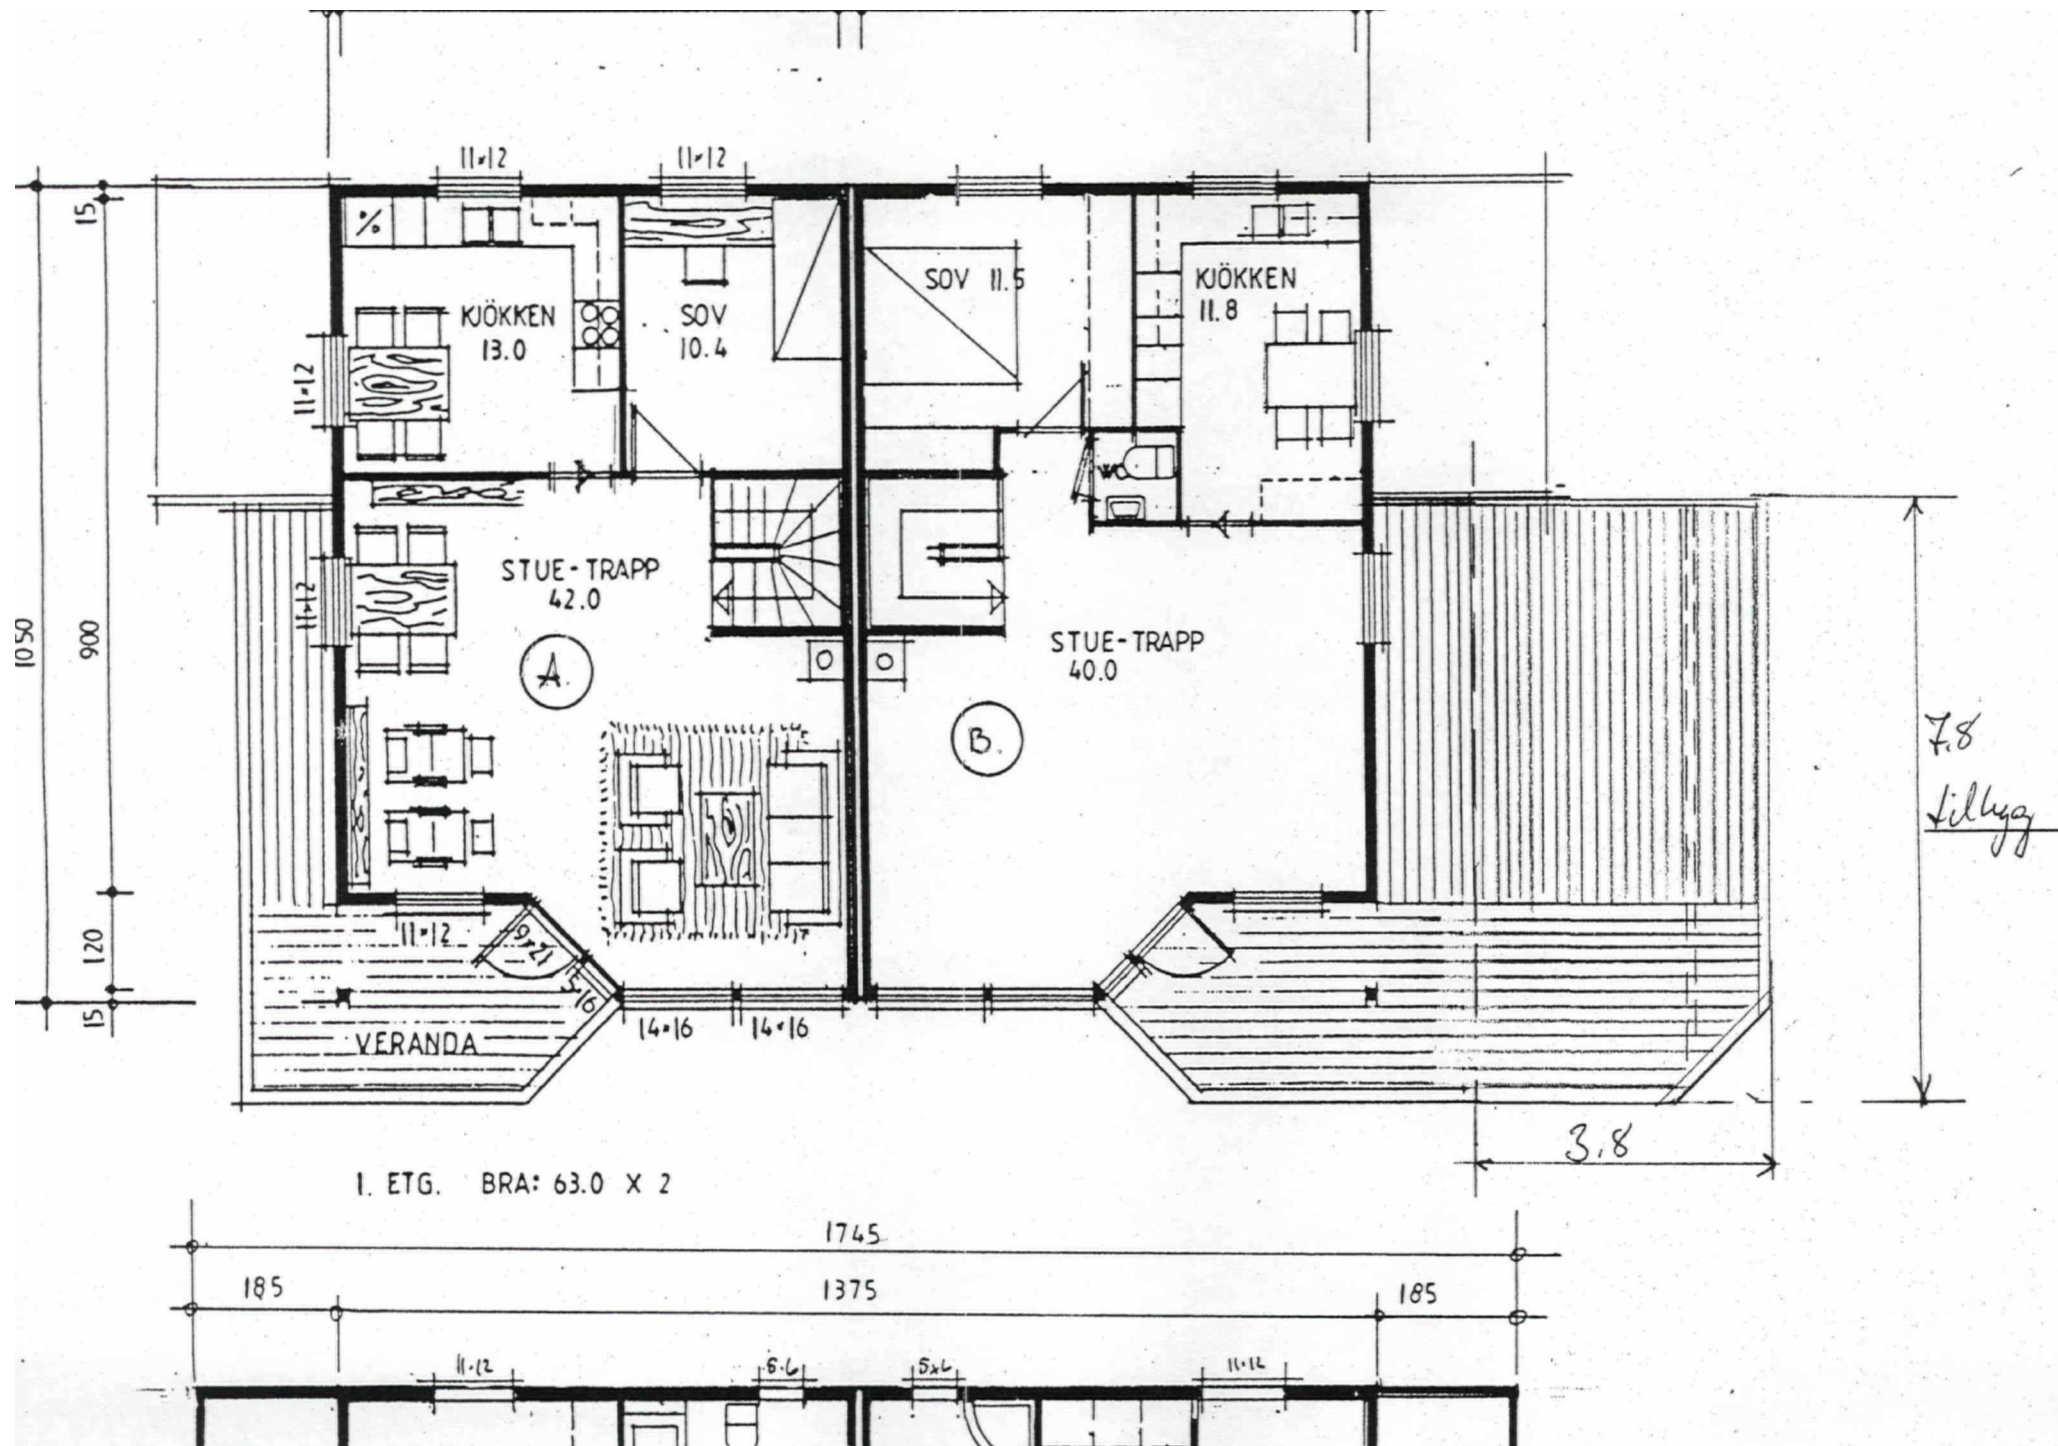


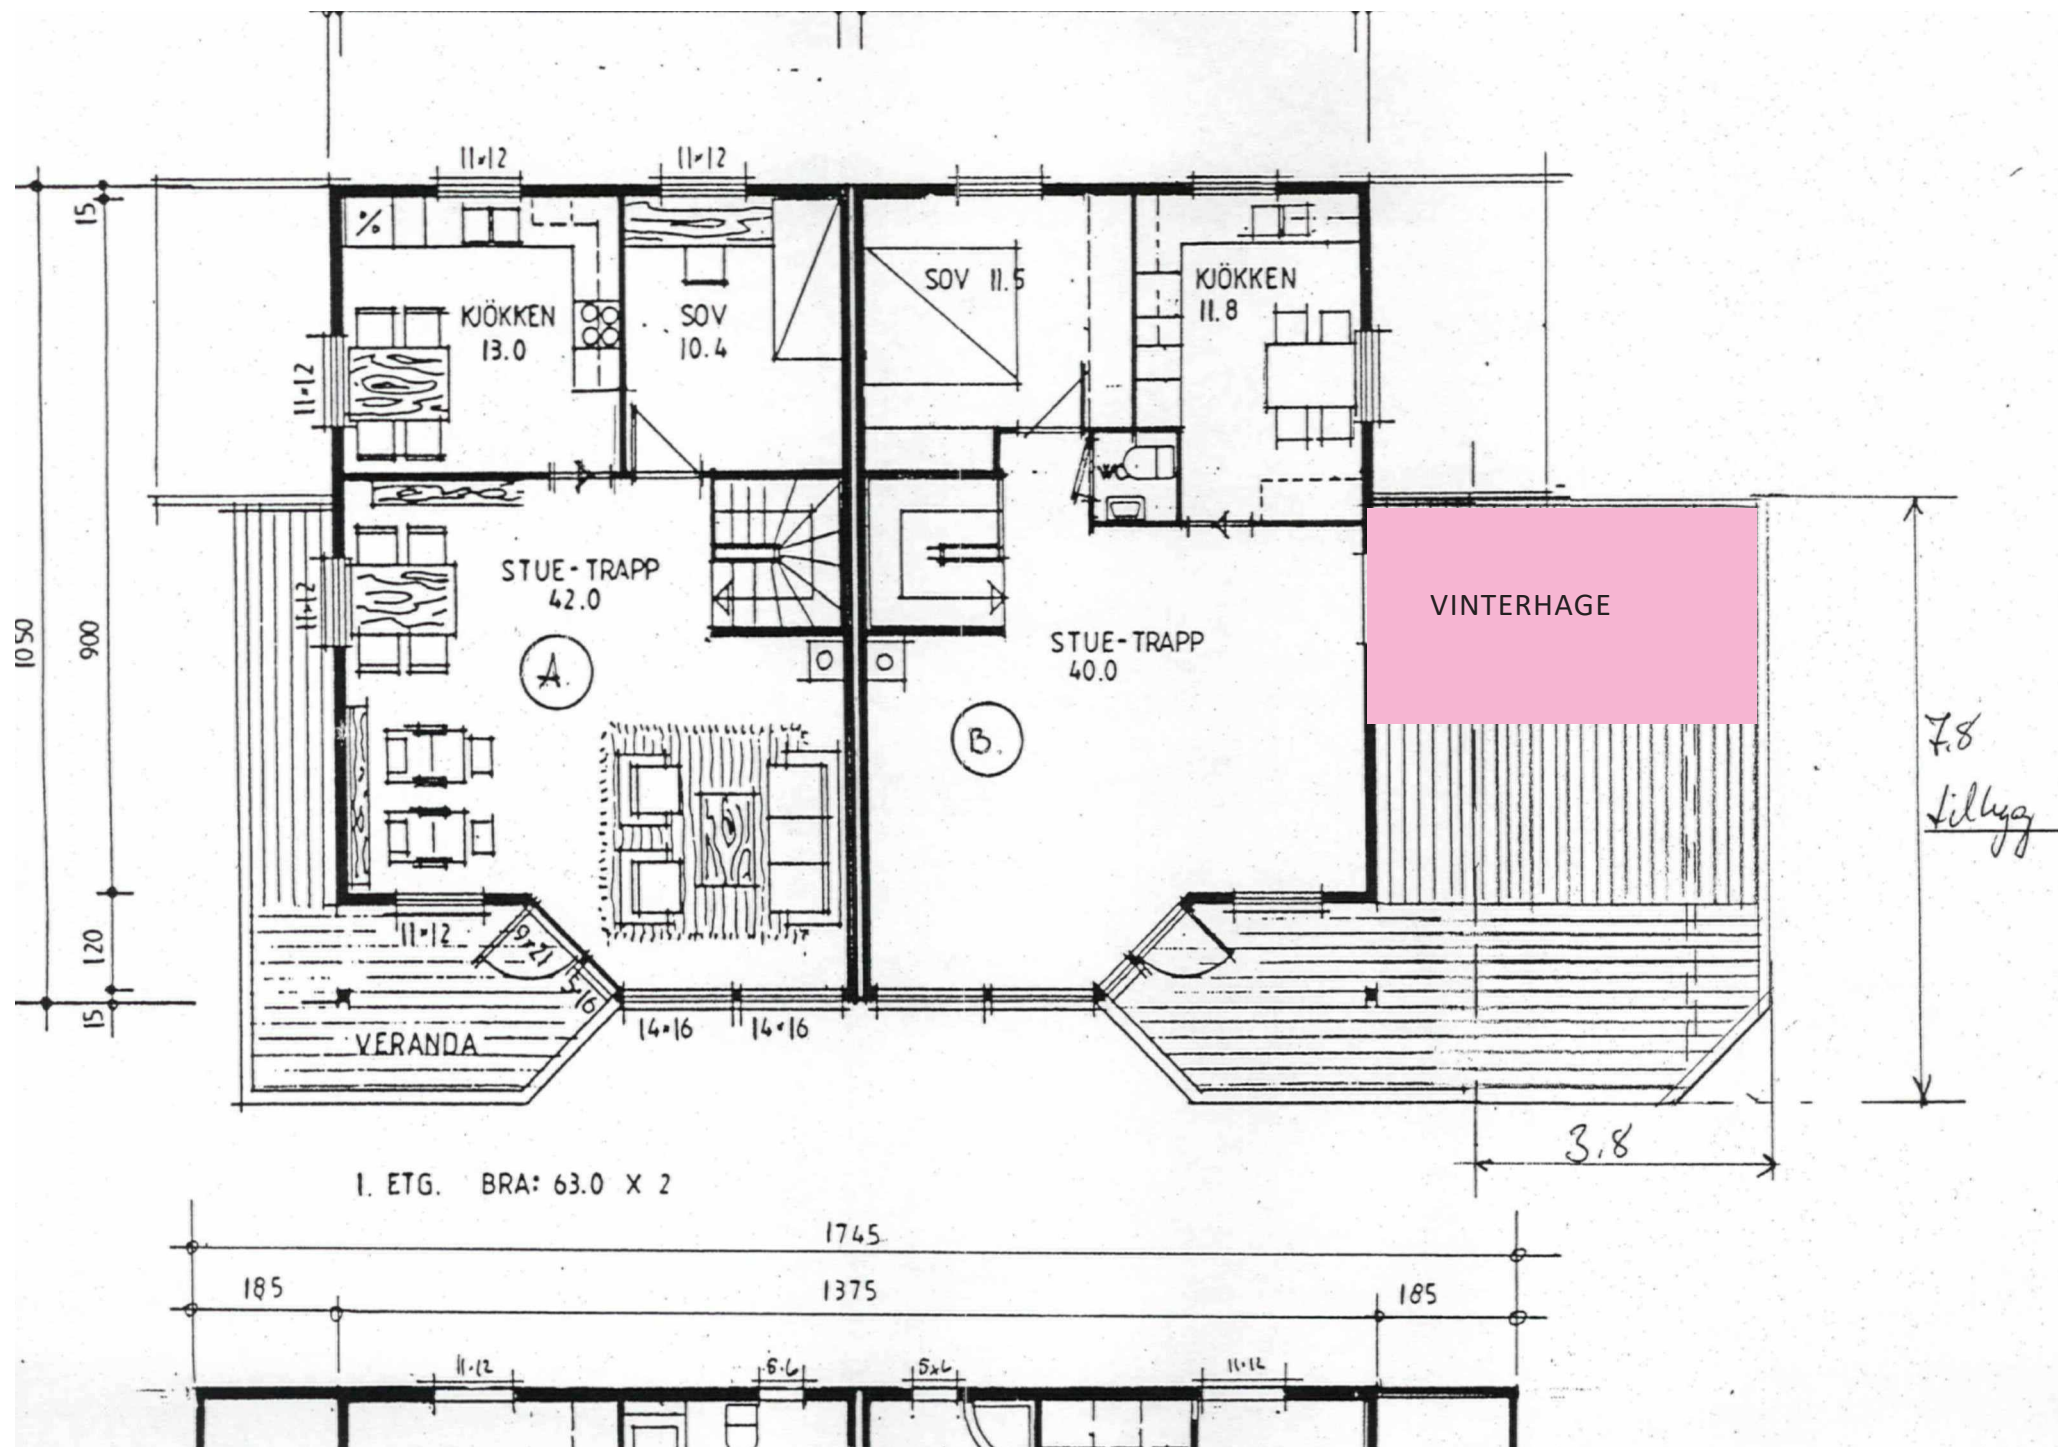

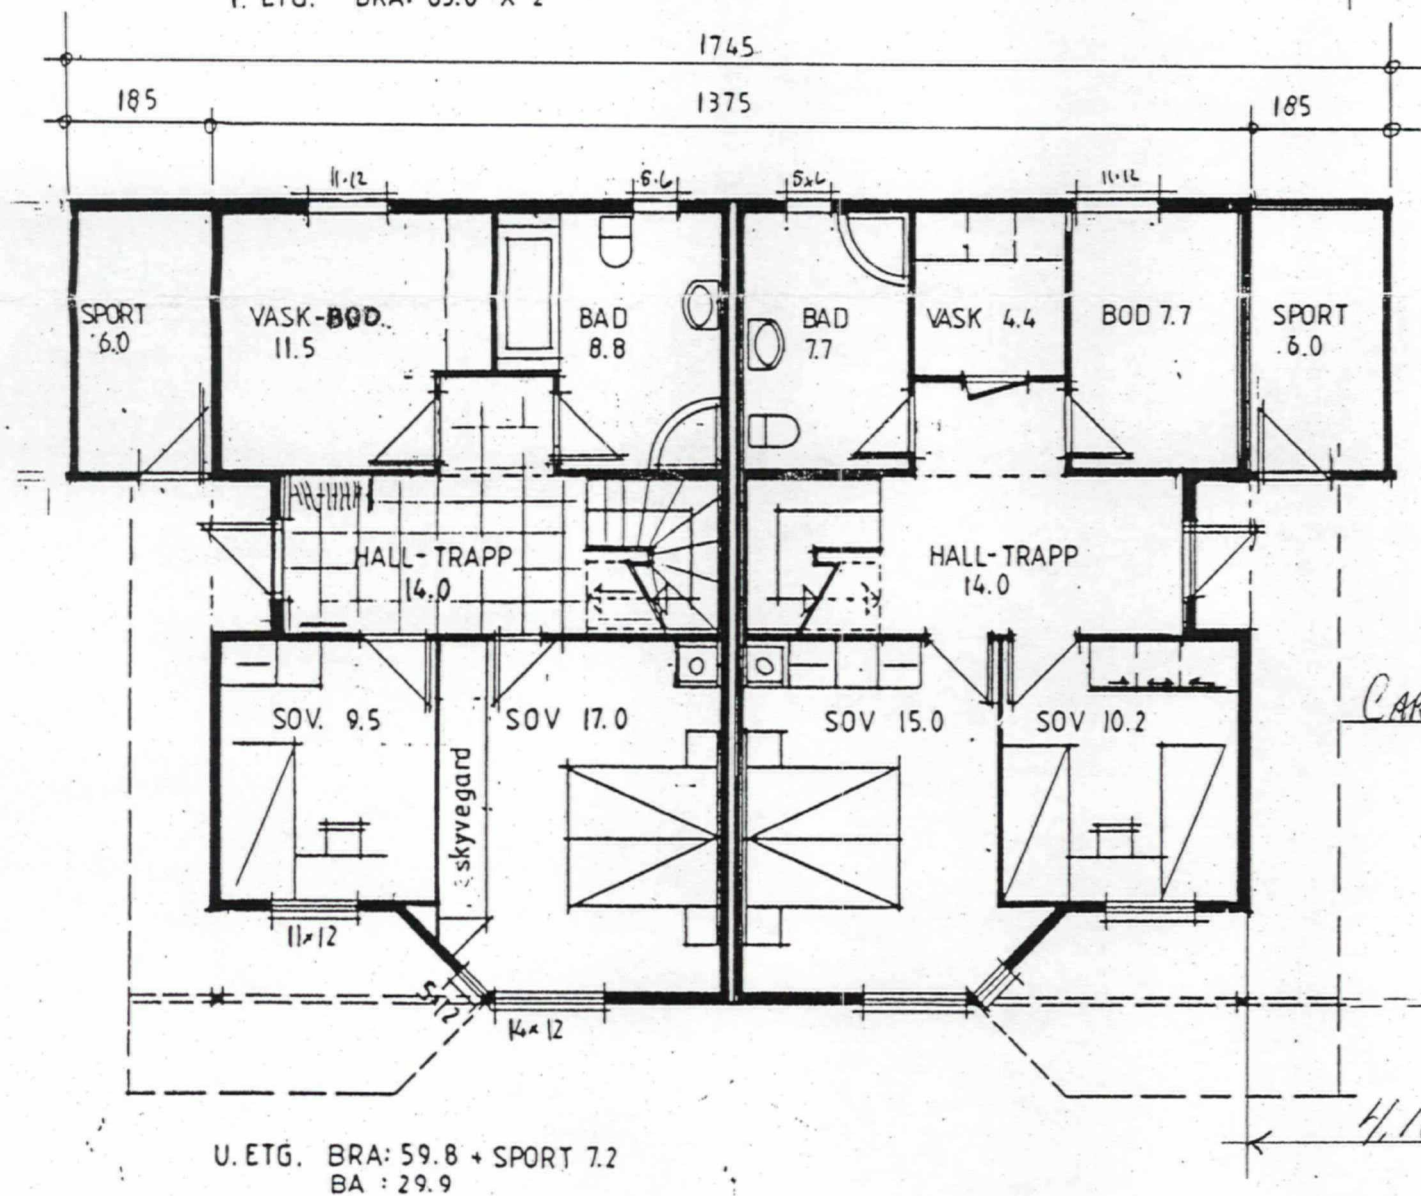


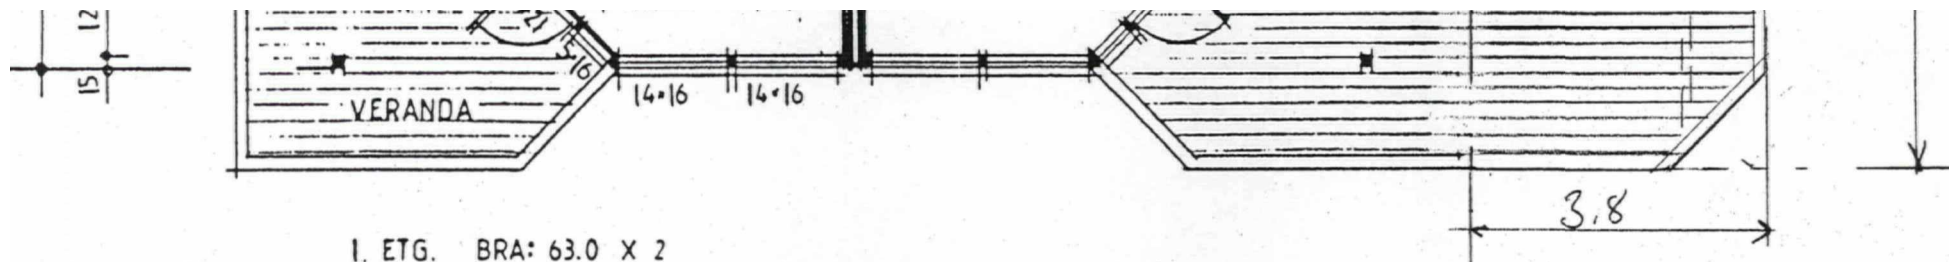

LINDÅS KOMMUNE TEKNISK	137/542	29 AUG. 2000	09/02/40 014943/00
Artiklkode			Skish SVT
			Grad.

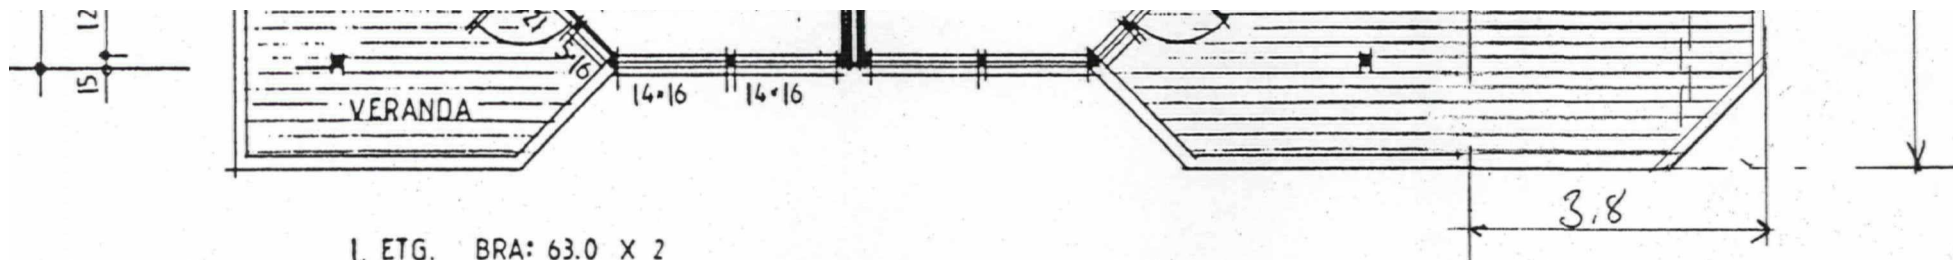

I. ETG. BRA: 63.0 X 2

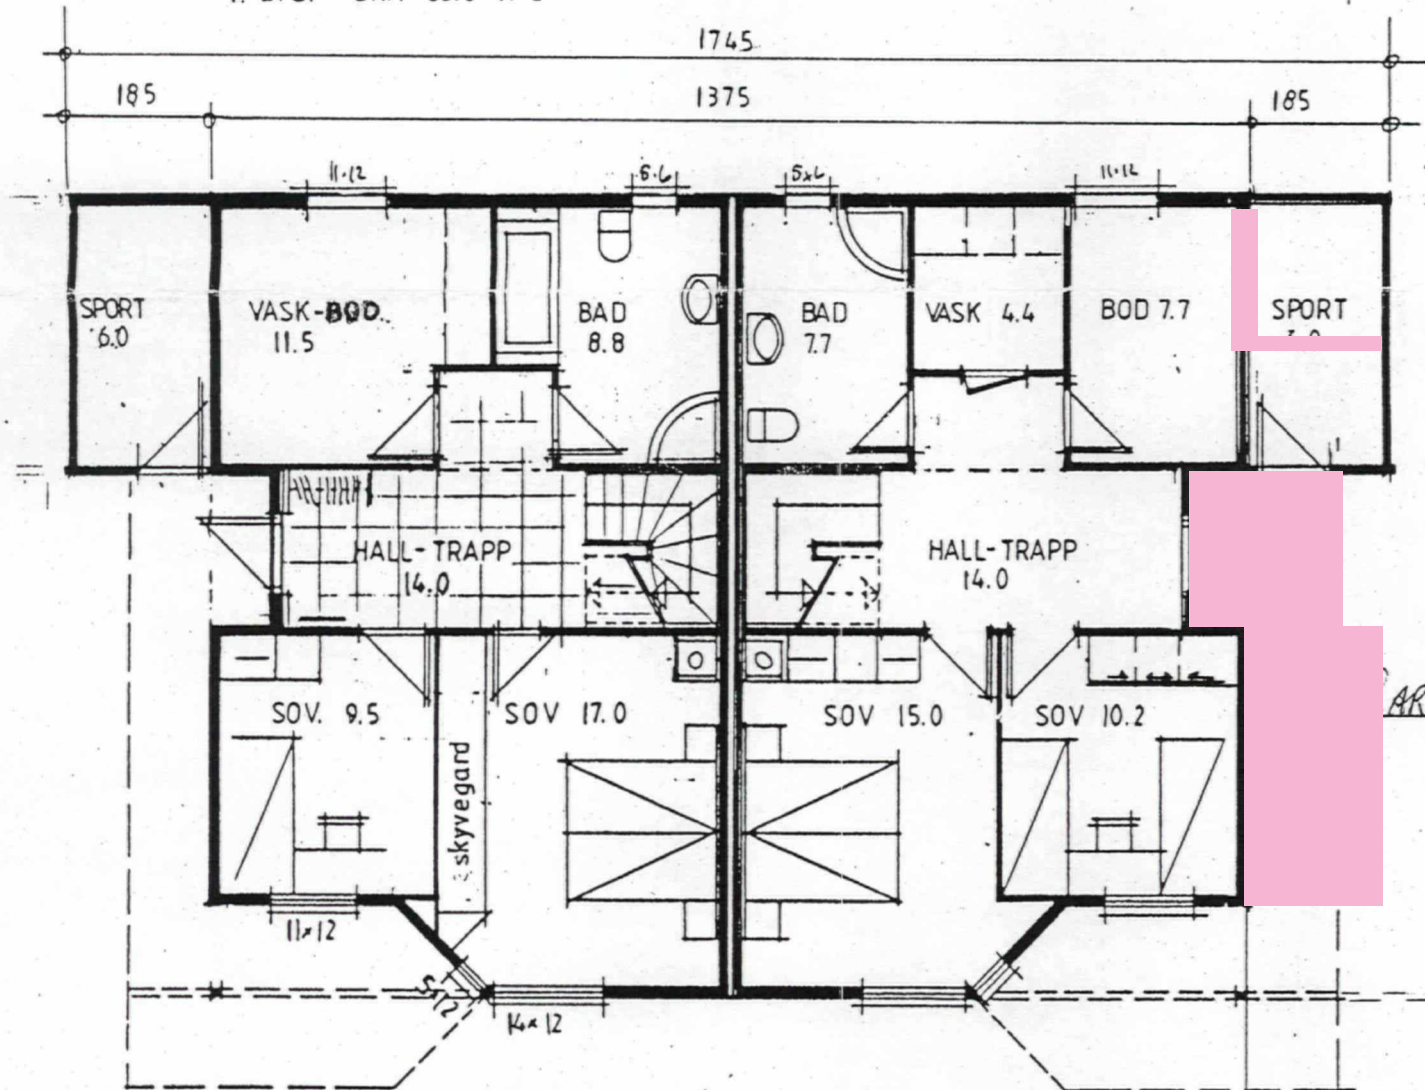

U. ETG. BRA: 59.8 + SPORT 7.2
BA : 29.9

ARPORT

LINDÅS KOMMUNE	TEKNISK
Arkivkode	137/542
29 AUG. 2000	
00/0240 014943/00	Grad.
SVT	


