


4

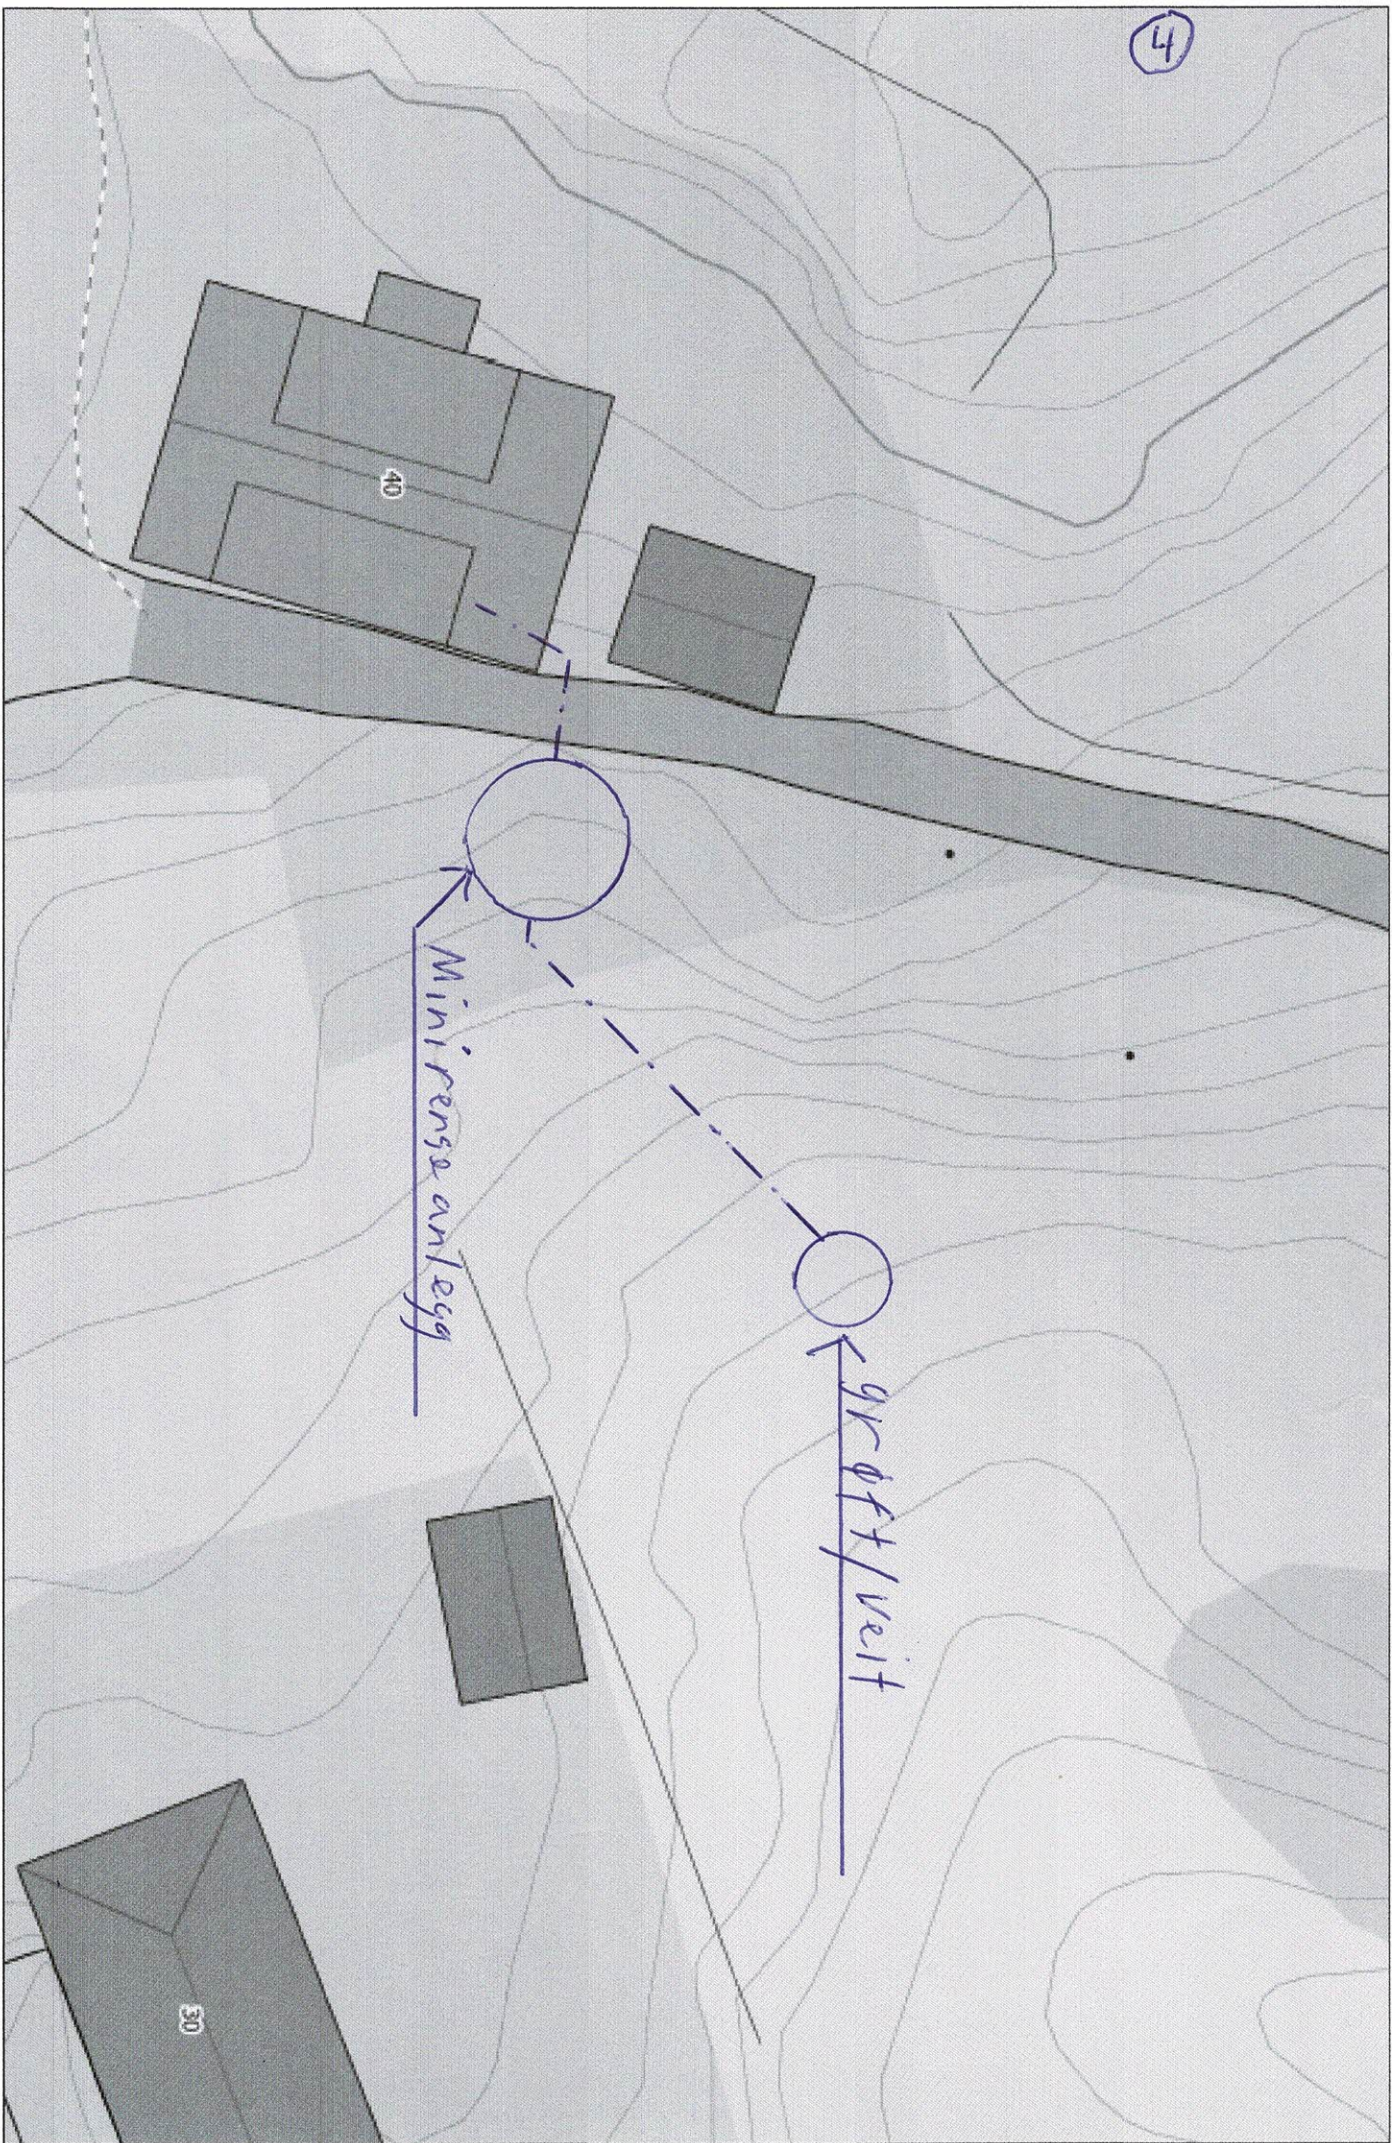

Senterposisjon: -39435,04, 67633333,16
Koordinatsystem: EPSG:25833
Utskriftsdato: 01.03.2021

