


4

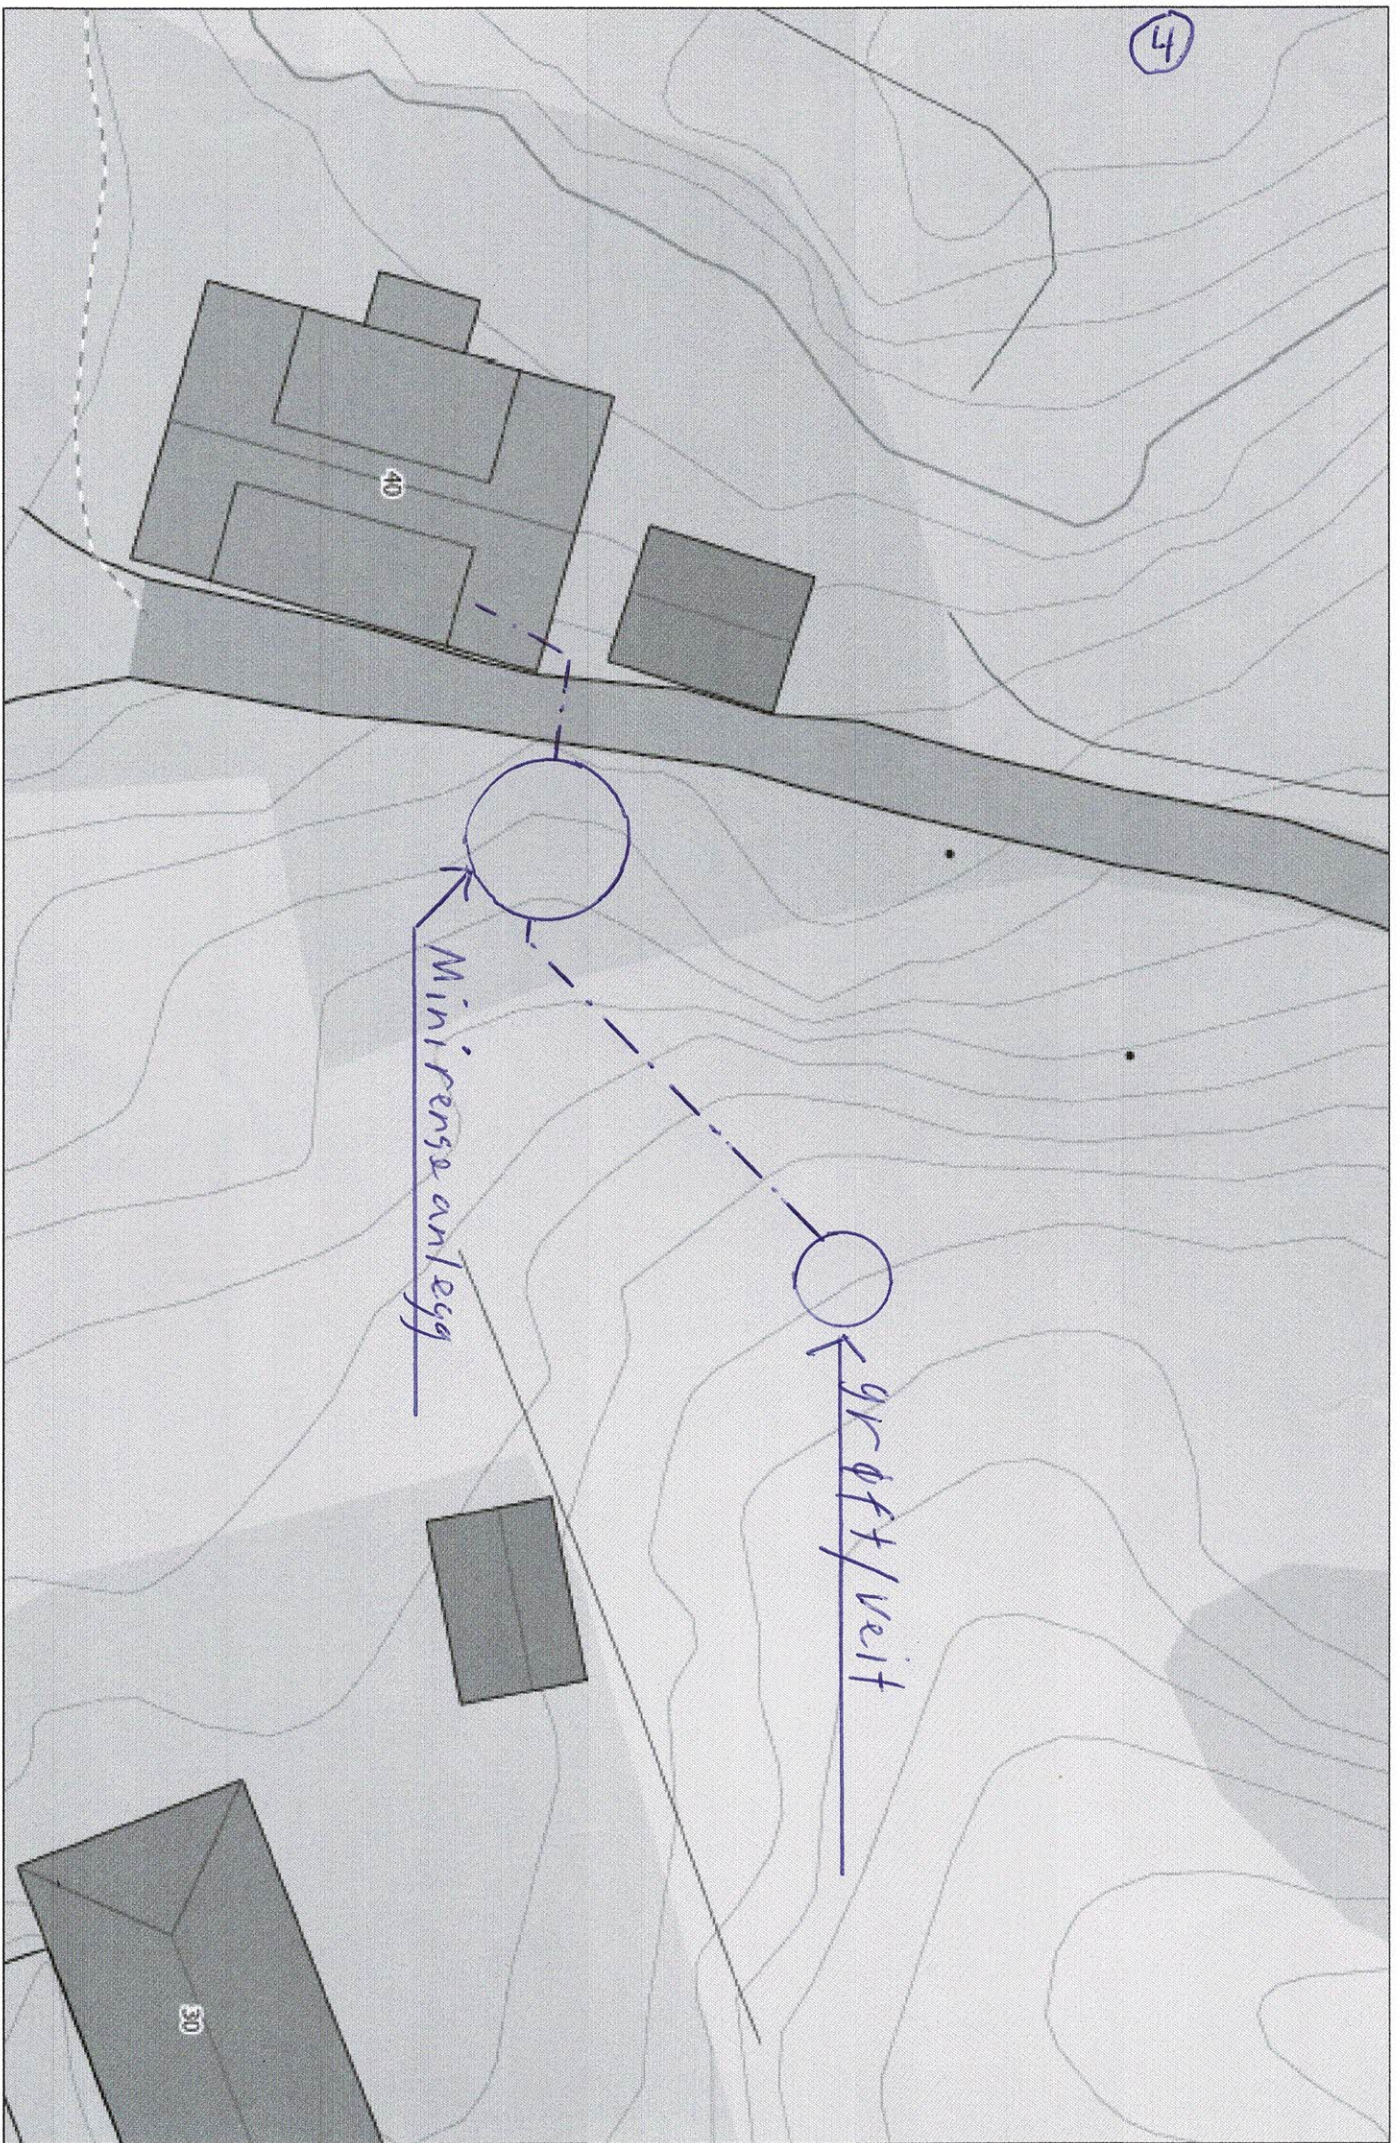

Senterposisjon: -39435,04, 67633333,16  
Koordinatsystem: EPSG:25833  
Utskriftsdato: 01.03.2021

