




LOFTSPLAN

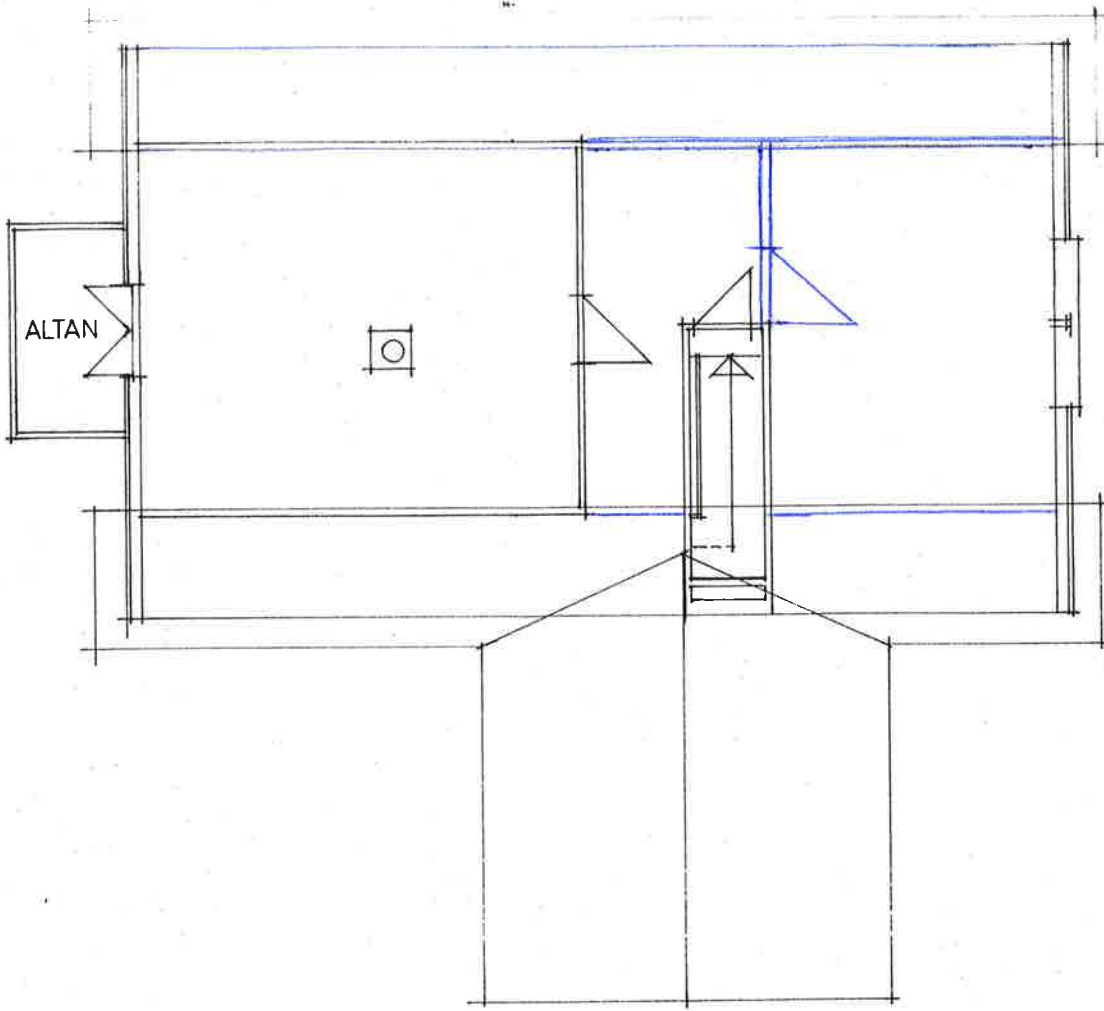

SNITT

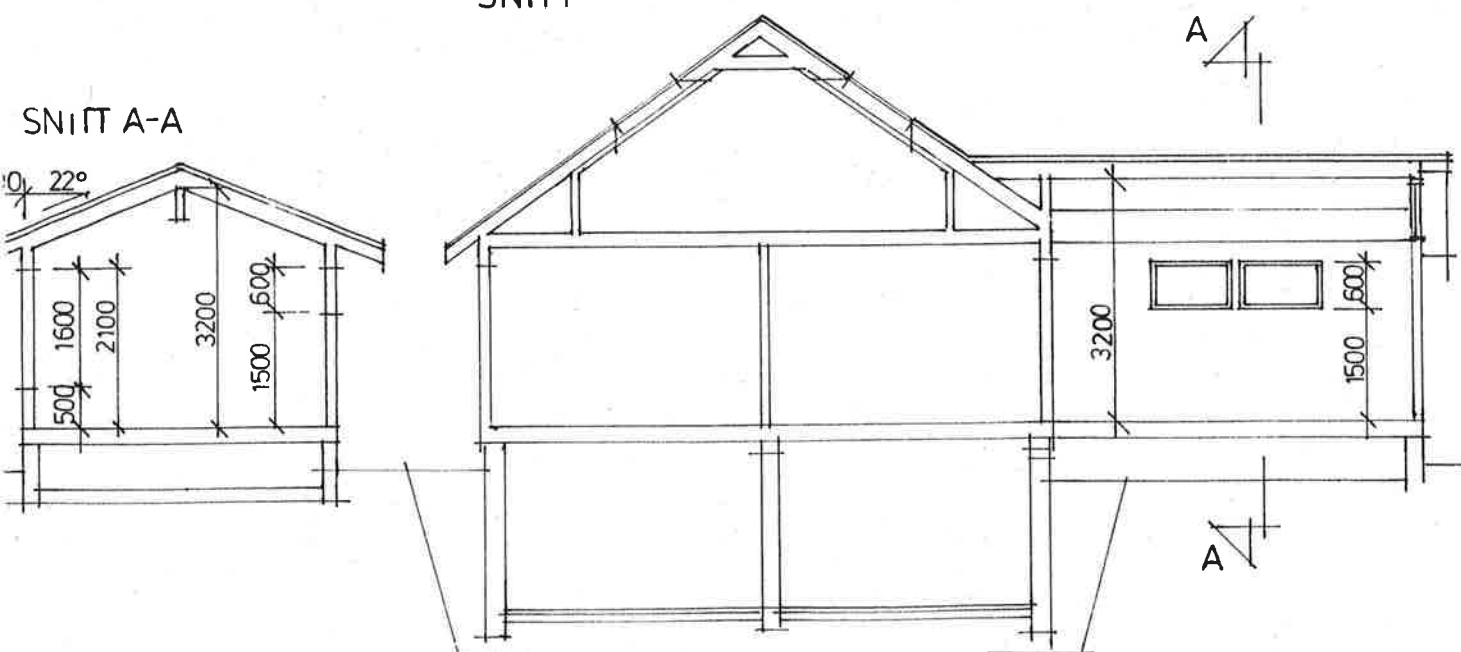


SNITT A-A

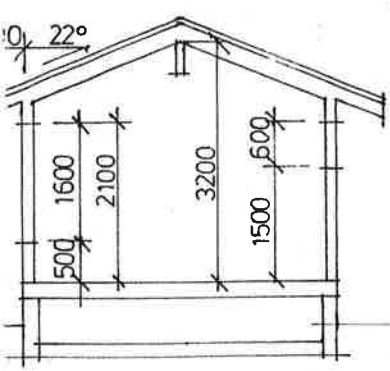


PROSJ NR 95019	MAL 1:100		<h1>Helge Helgesen</h1> <p>Arkitekt tjenester</p>
TEGN NR. 002	DATE 22.12.95		
	TEGN HH		

Kloppedalsv. 5. Postboks 230 5040 PARADIS
Tlf (55) 911877 Telefax (55) 913190

HOVEDPLAN

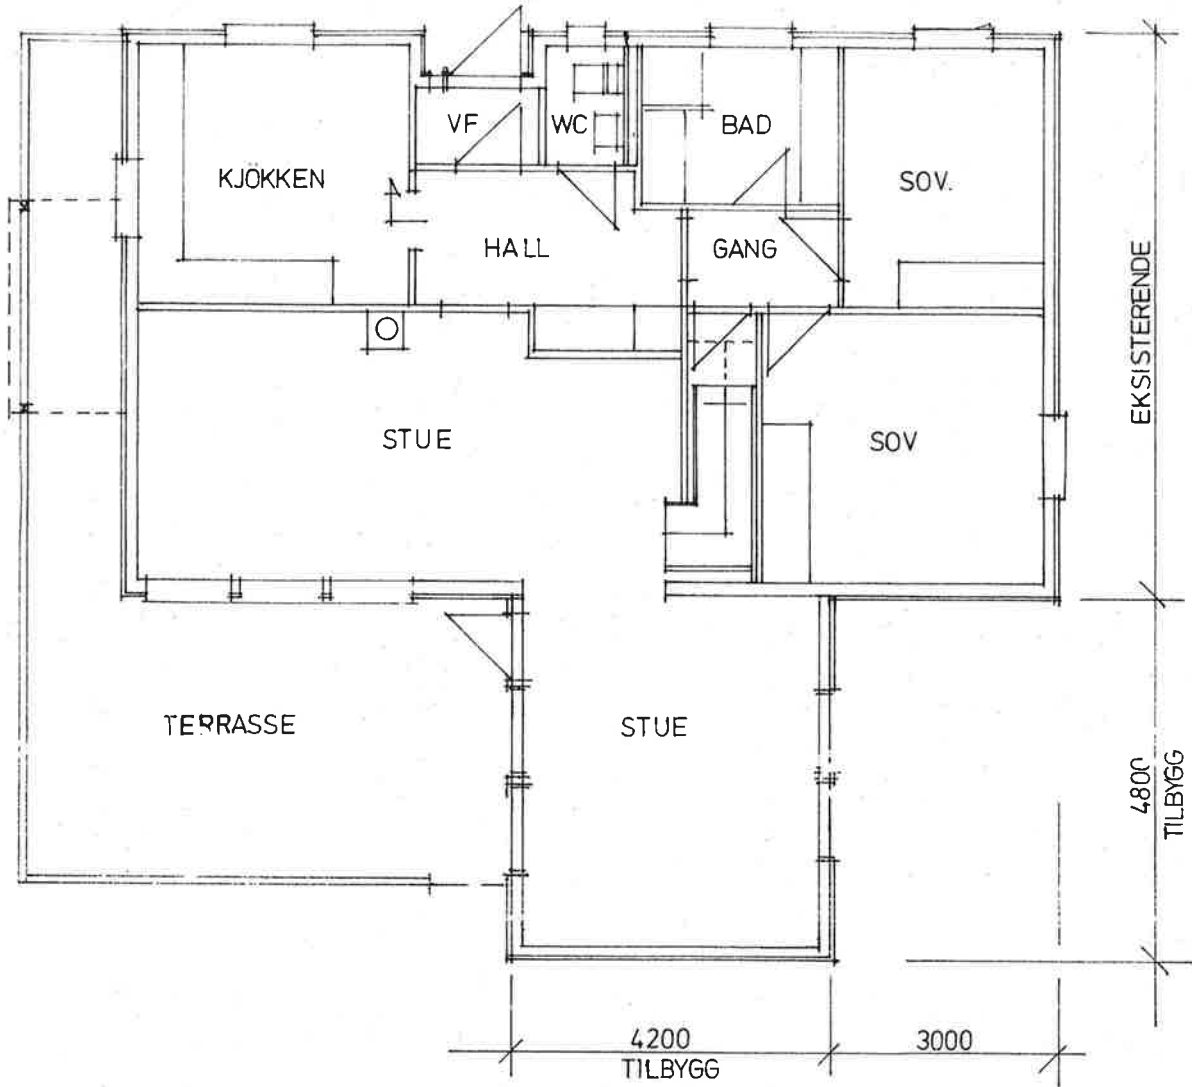

KJELLER

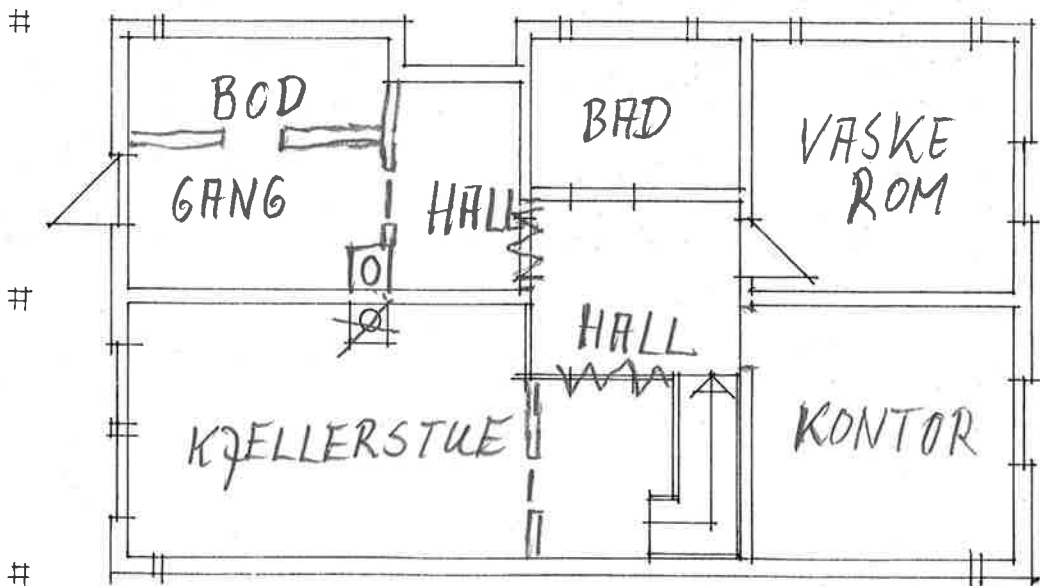

ENDRE JENSEN
JUVIKNIPA 68, 5110 FREKHAUG
TILBYGG - PLAN OG SNITT