


Kopi

24.3.2021

Manglar på målestokk

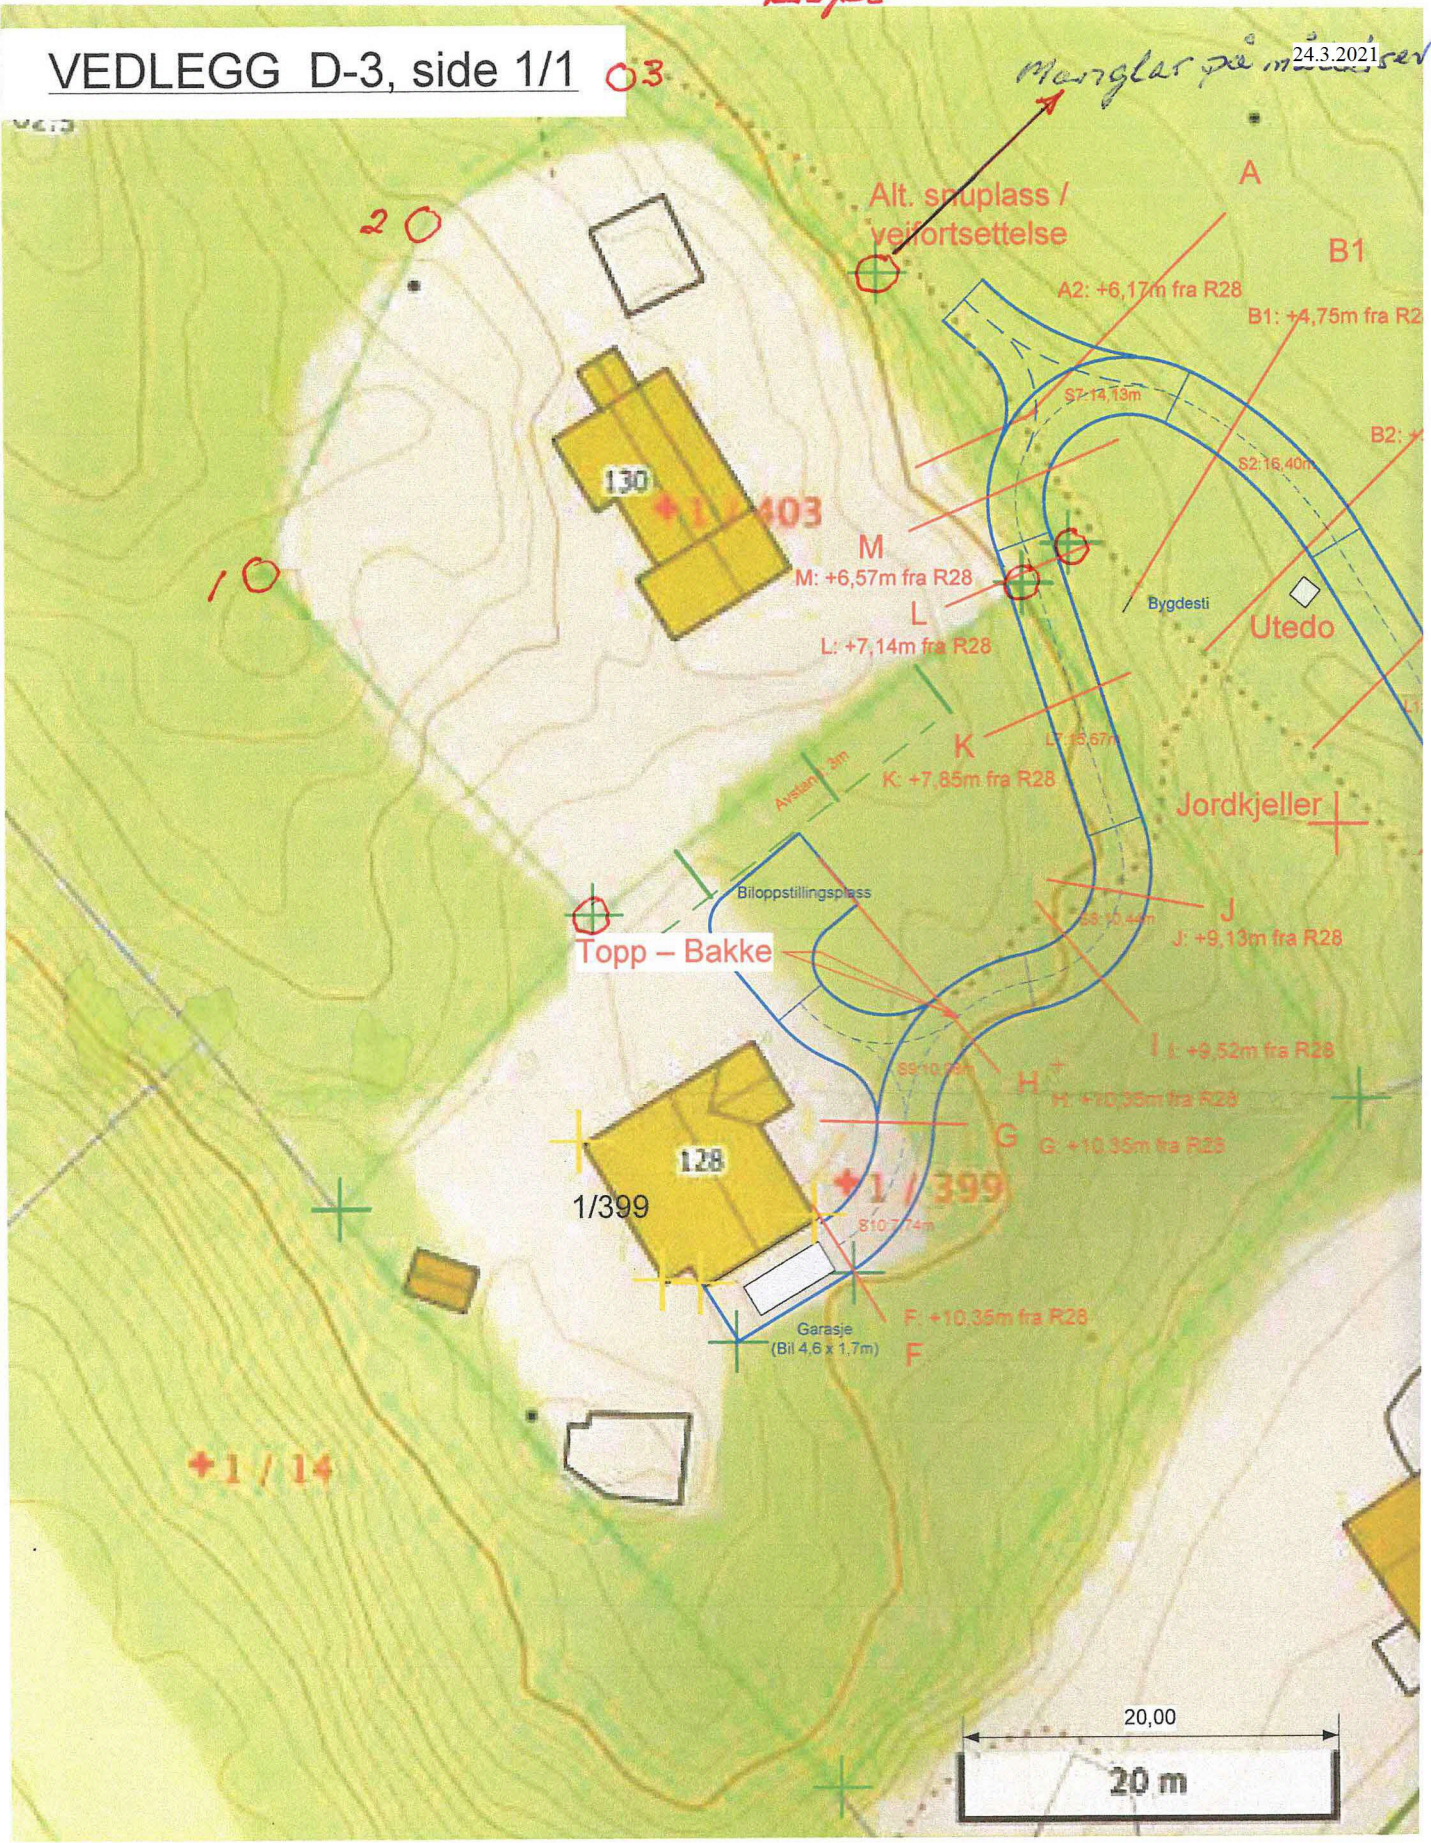

Plan inntegnet veitrase Alternativ 3 – skala 1:400

Kopi

T