




Alver, gnr 428 bnr 141
Innmålt fasadeliv

13.11.2020

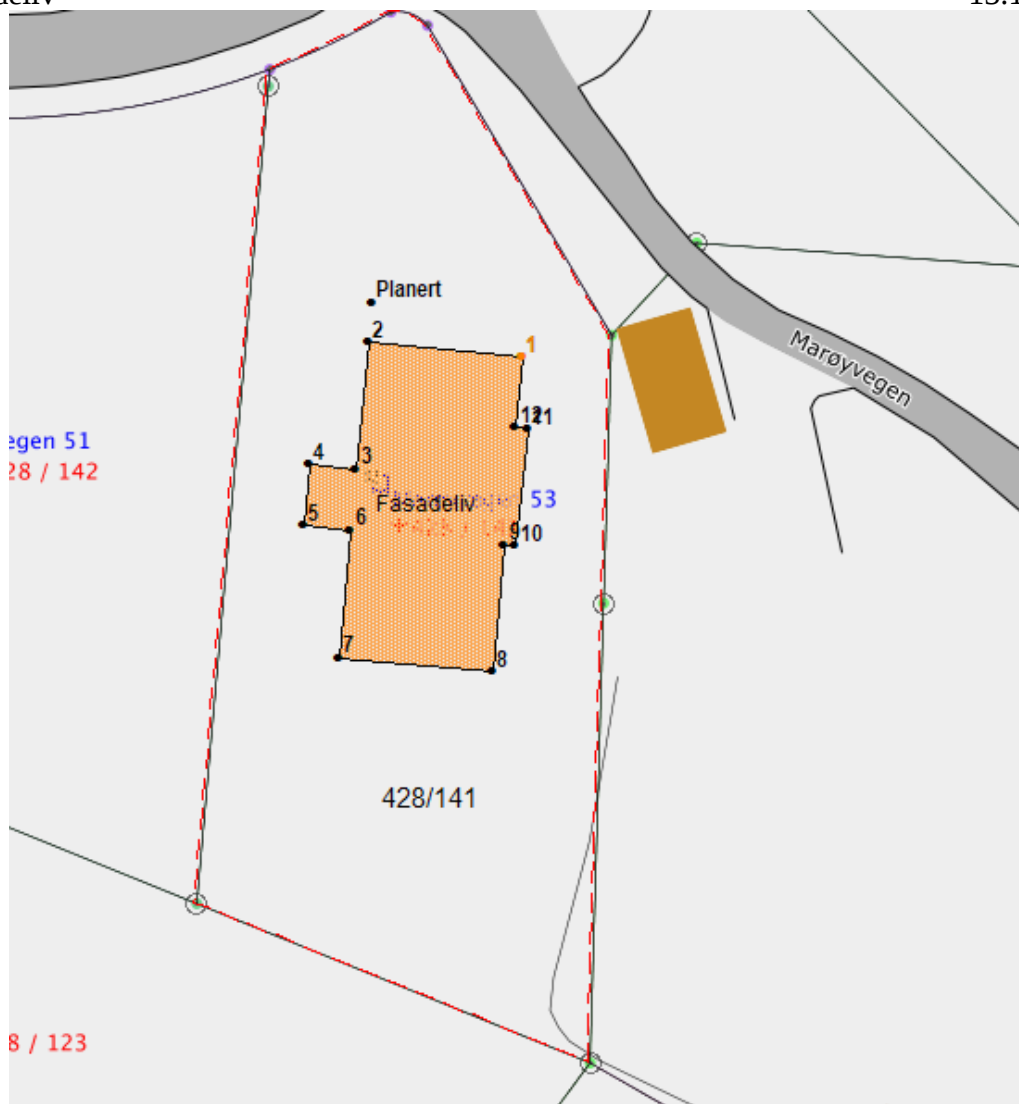

PunktID	N-koord.	Ø-koord.	Høyde	PunktID	N-koord.	Ø-koord.	Høyde
Hushjørner fasadeliv							
1	6735140,47	277728,43		7	6735124,96	277718,95	
2	6735141,23	277720,49		8	6735124,21	277726,87	
3	6735134,67	277719,87		9	6735130,78	277727,50	
4	6735134,90	277717,45		10	6735130,72	277728,10	
5	6735131,76	277717,16		11	6735136,76	277728,68	
6	6735131,53	277719,58		12	6735136,82	277728,08	

Høyde planert utenfor hus

Planert	6735143,29	277720,69	14,42
---------	------------	-----------	-------