


Y 287720

Y 287760

X 6743640

X 6743600

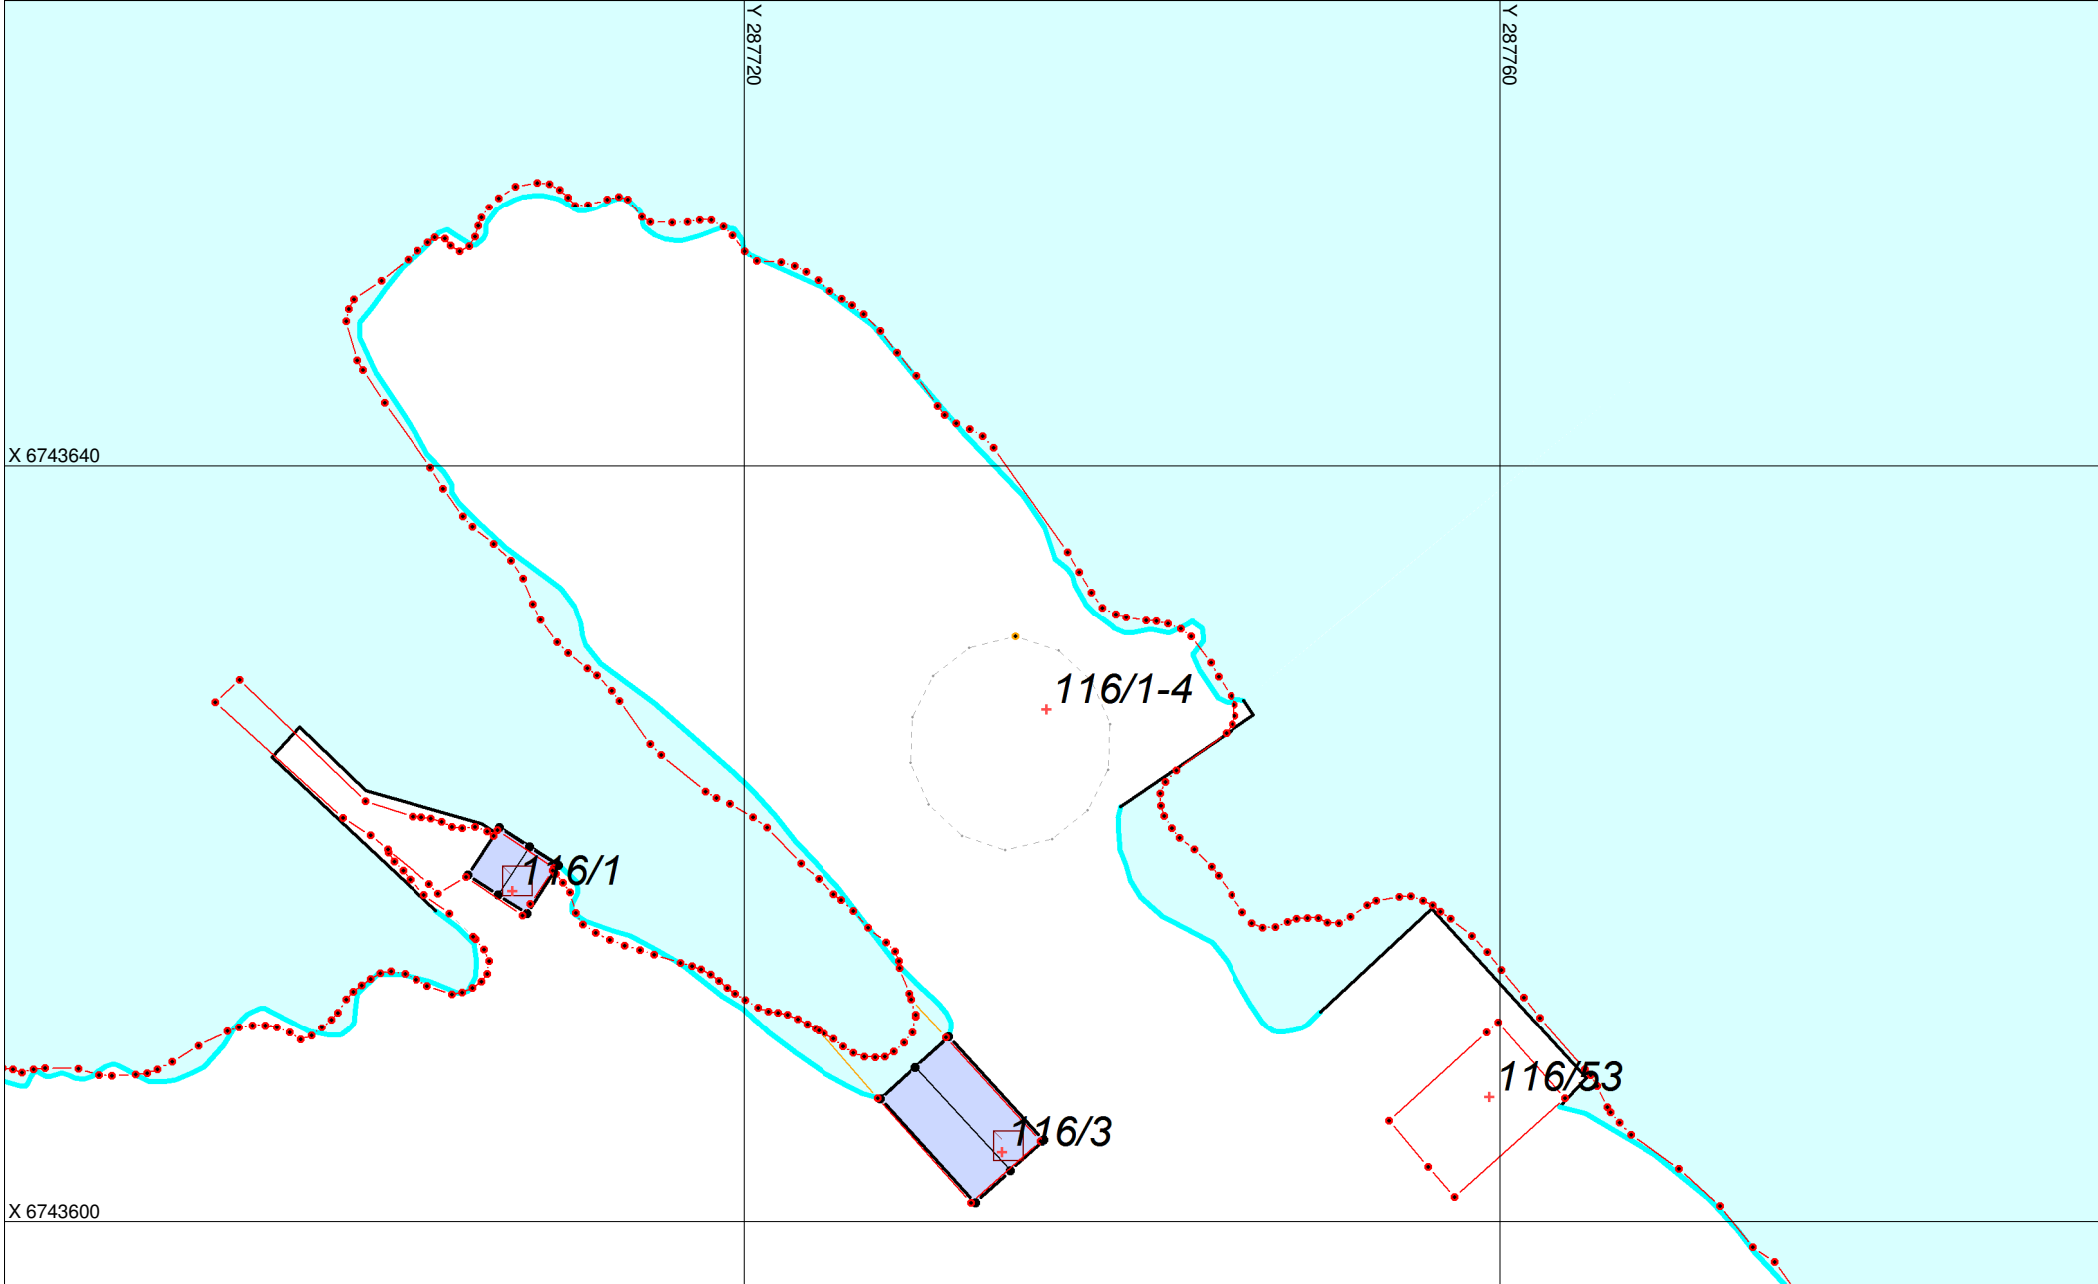

116/4-Nordre Lauvåsvika, før kartretting
08.04.2021
Målestokk 1:400