


025/21

01

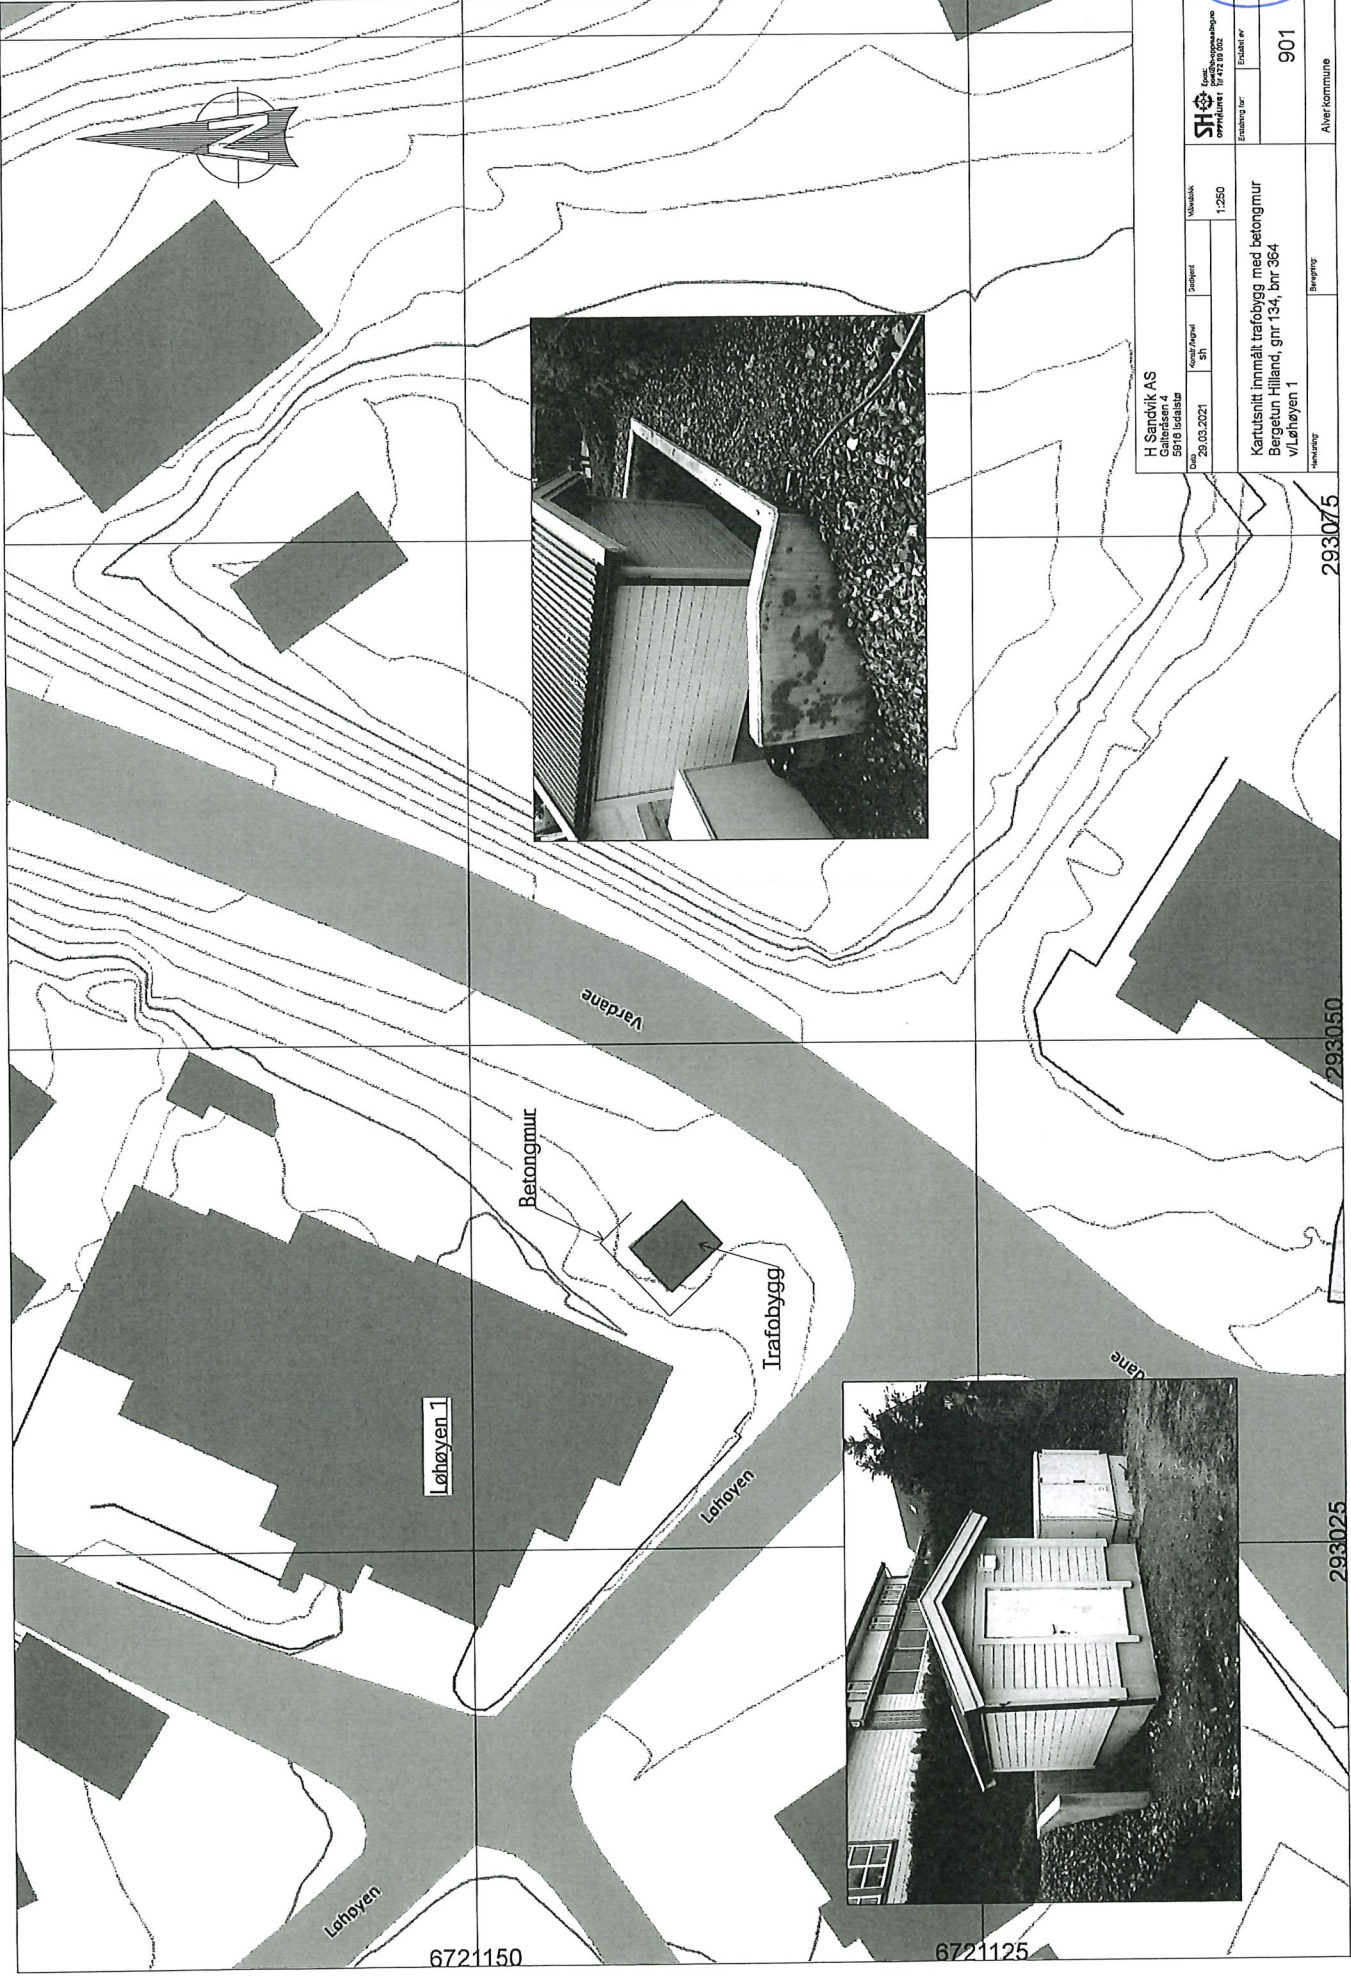

	H Sandvik AS Calmetstr. 4 5918 Isdalstun			Beropning Kartusnitt innmålt trafobbygg med betongmur Bergetun Hilland, gnr 134, bnr 364 v/Løhøyen 1

