



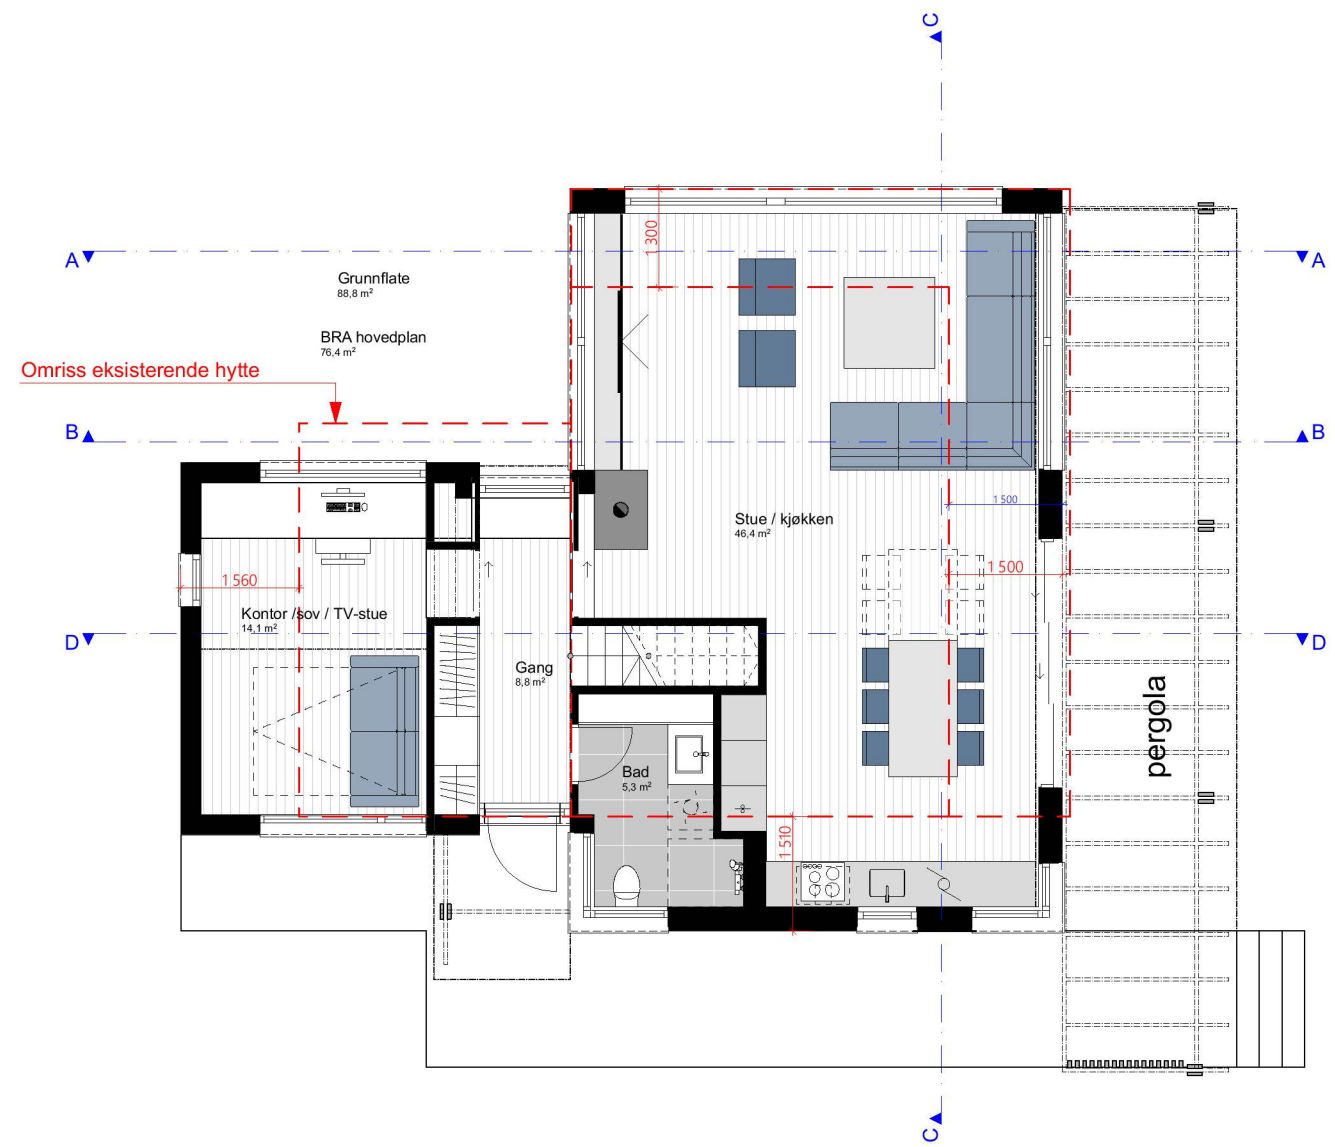

1. Etasje

1:100

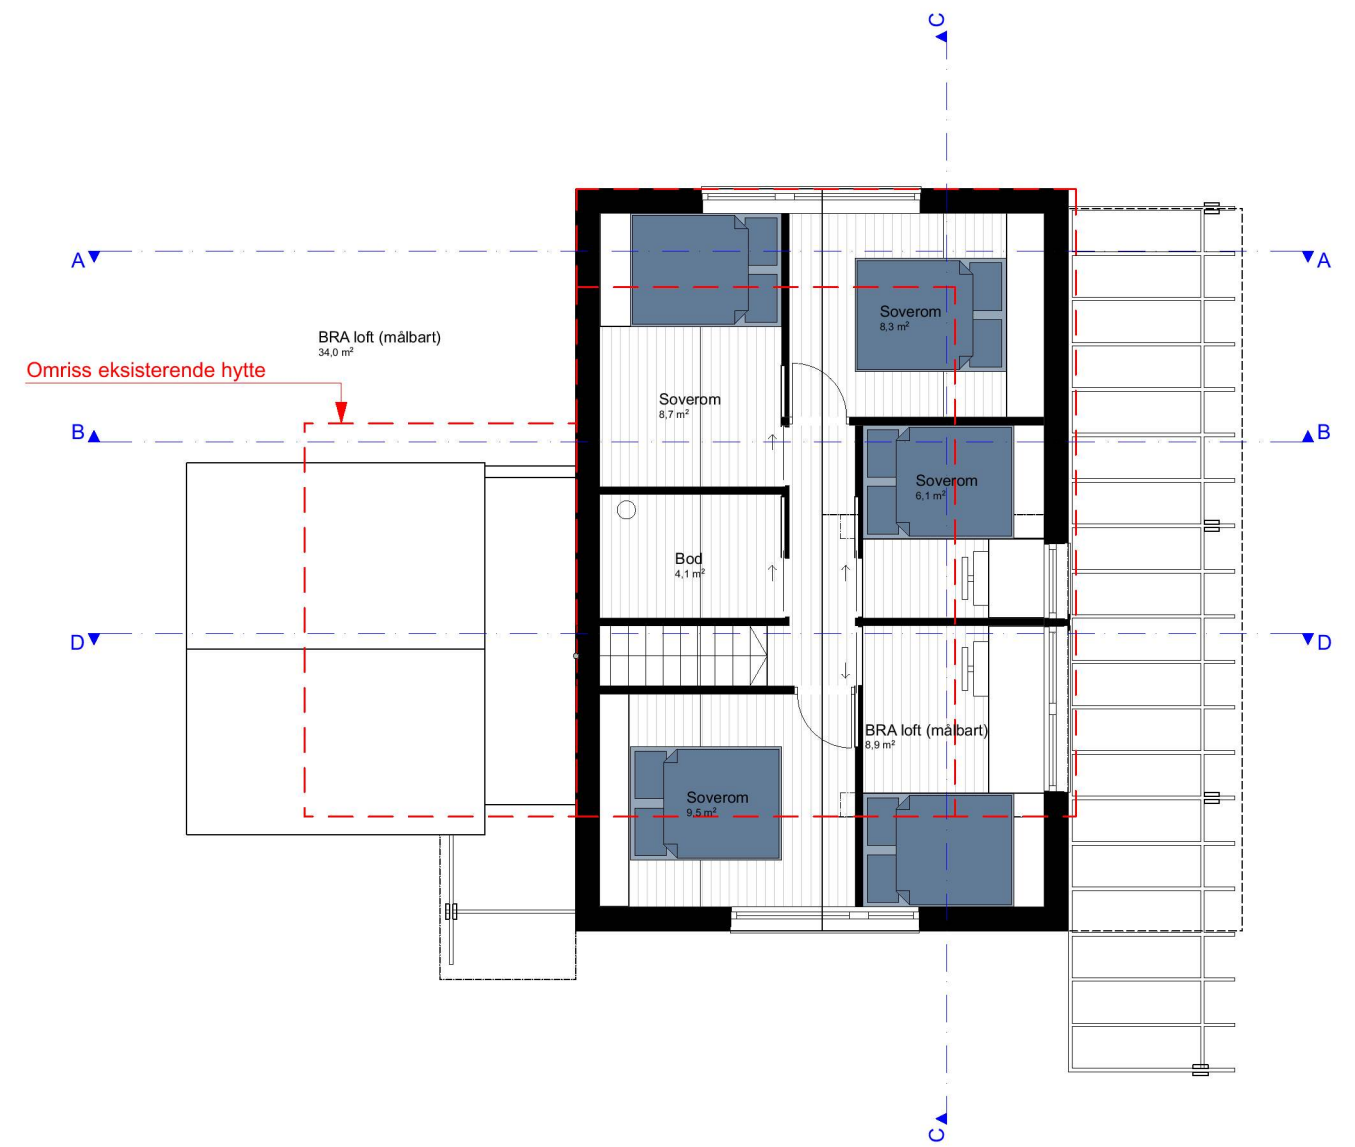

Loft

1:100