
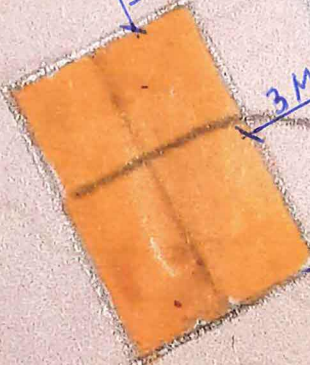


DI

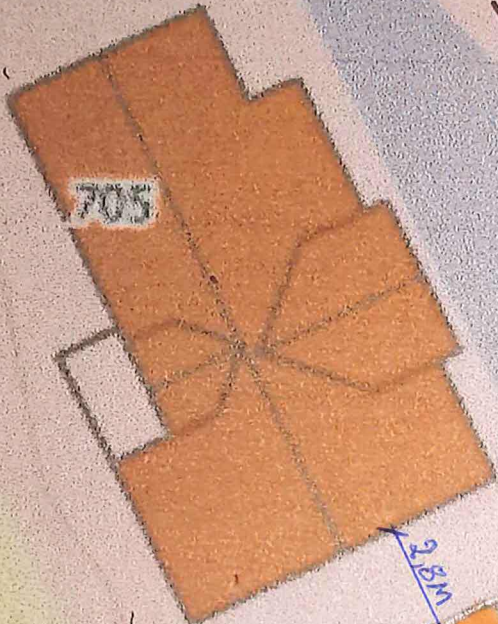

2.8M

3M

9M

