


4

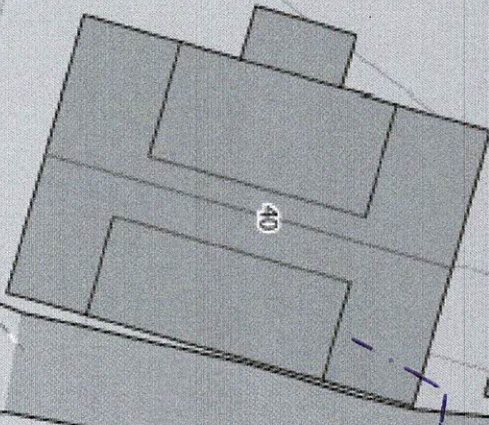


40

Minirensaanlegg



Grøft/veit

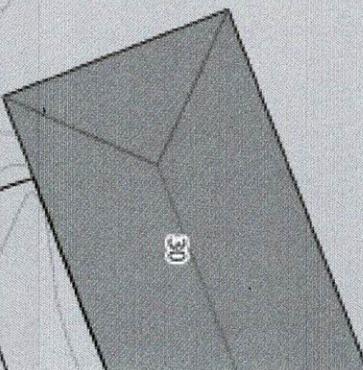

30