
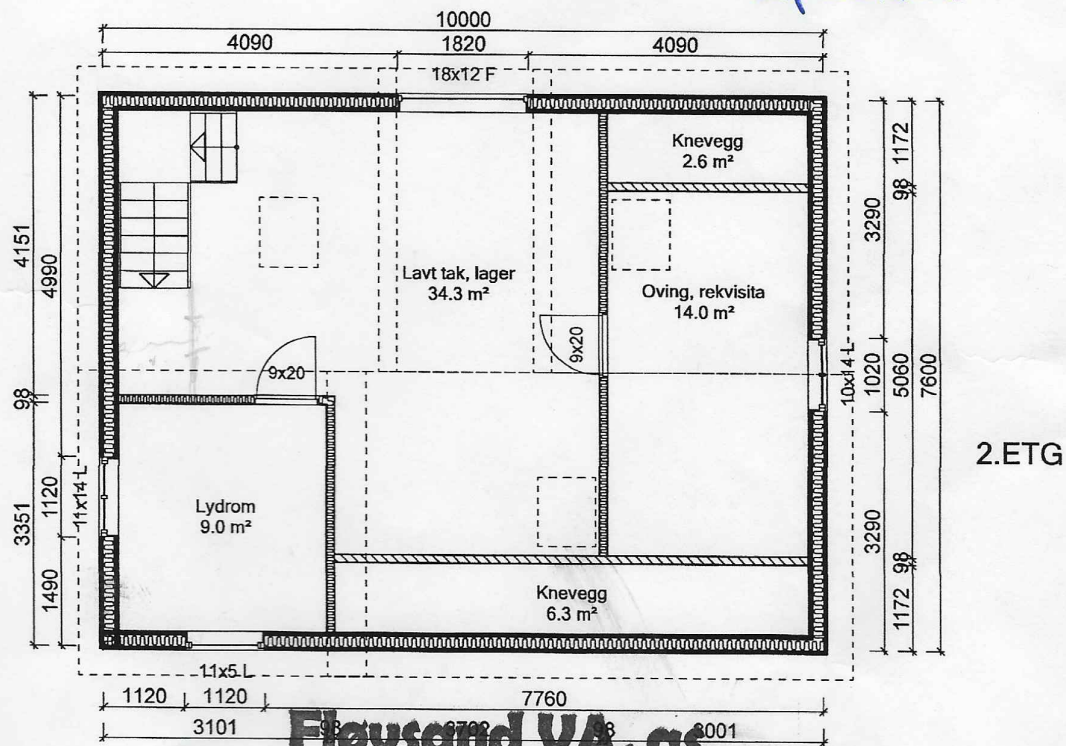


1 # 2

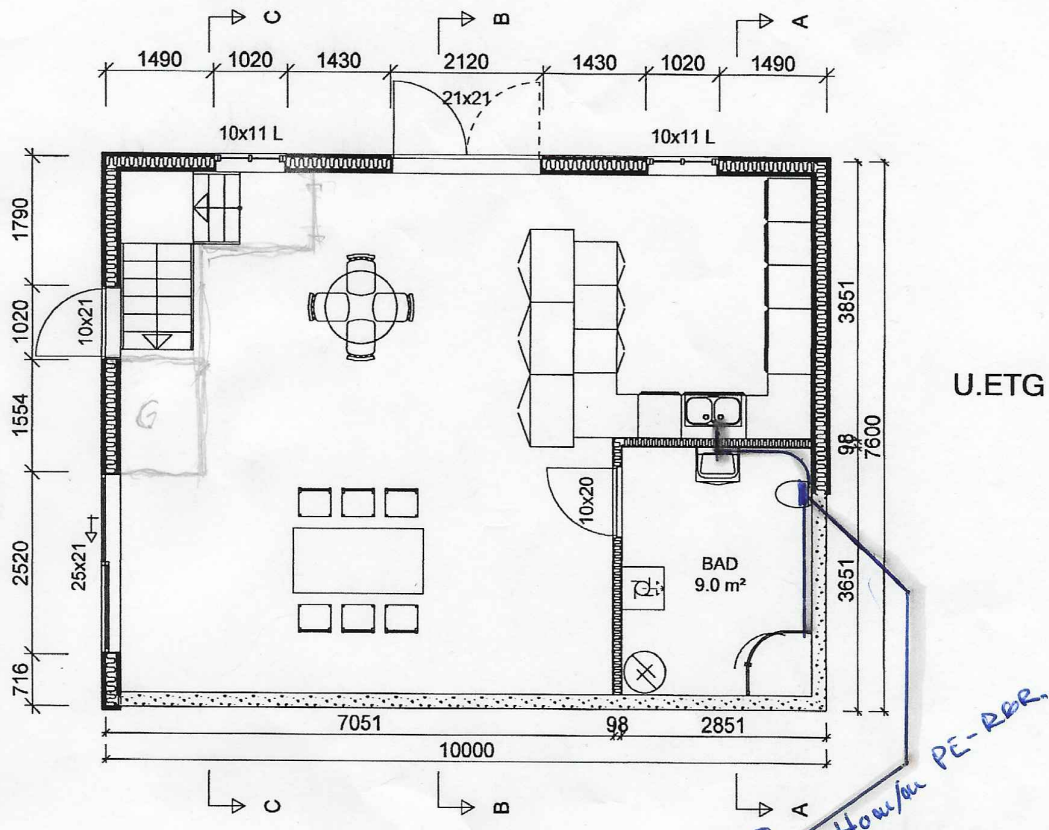

Floysand VA, as

Rørlegger

Mob. 952 73 505

Floksand, 5918 Frekhaug

Org.nr.: No 987 774 525 MVA

Handwritten signature and date: 4.2.2021

BYGGMESTER
HAGEWICK