




Alver, gnr 239 bnr 123
Innmålt grunnmur

25.02.2021

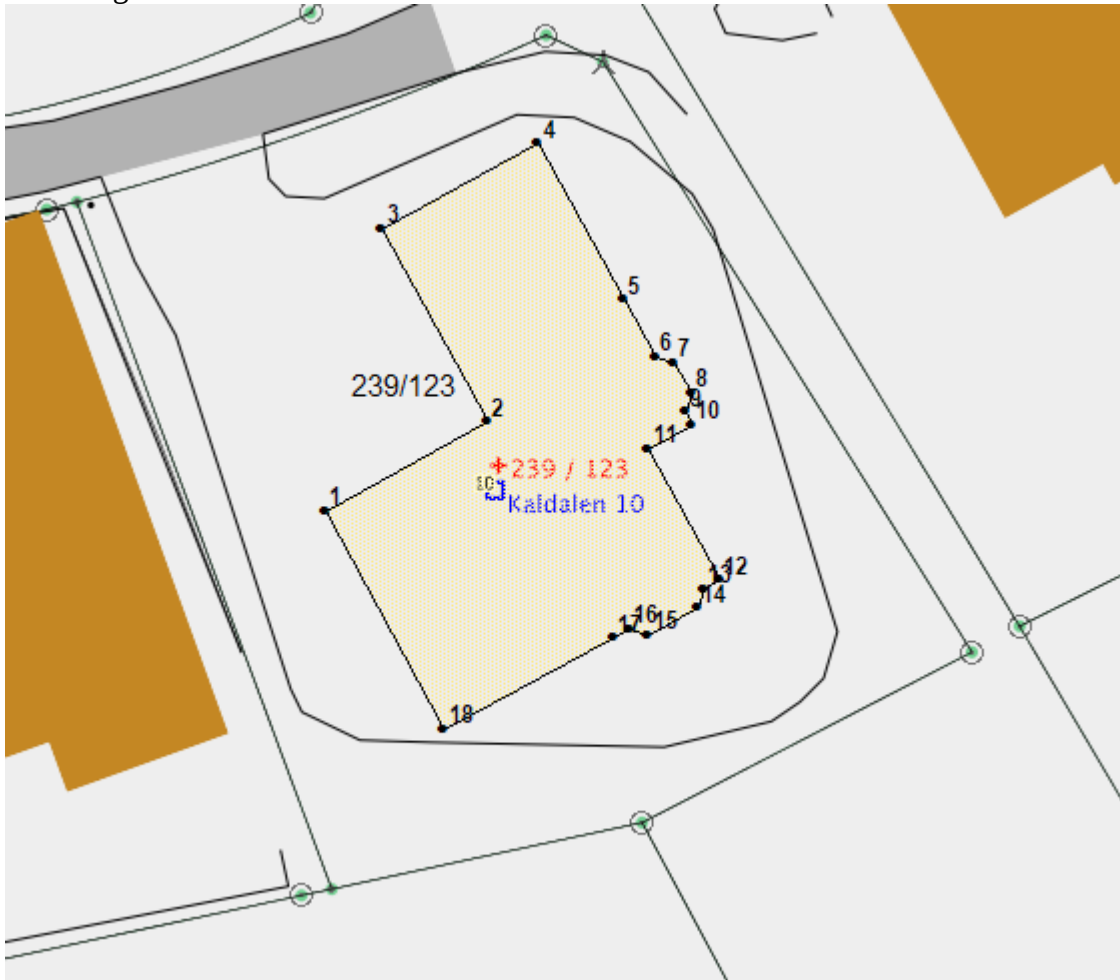

PunktID	N-koord.	Ø-koord.	Høyde
1	6723797,11	305479,70	26,17
2	6723800,85	305486,54	
3	6723808,99	305482,11	
4	6723812,58	305488,65	
5	6723805,98	305492,23	26,16
6	6723803,59	305493,56	26,16
7	6723803,35	305494,36	26,16
8	6723802,07	305495,09	26,15
9	6723801,27	305494,83	26,16
10	6723800,75	305495,10	26,15
11	6723799,74	305493,27	26,16
12	6723794,21	305496,27	26,16
13	6723793,84	305495,61	26,16
14	6723793,06	305495,37	26,16
15	6723791,89	305493,29	26,16
16	6723792,15	305492,49	26,16
17	6723791,79	305491,81	26,15
18	6723787,93	305484,71	