




Alver, gnr 156 bnr 39
Innmålt grunnmur

30.01.2020

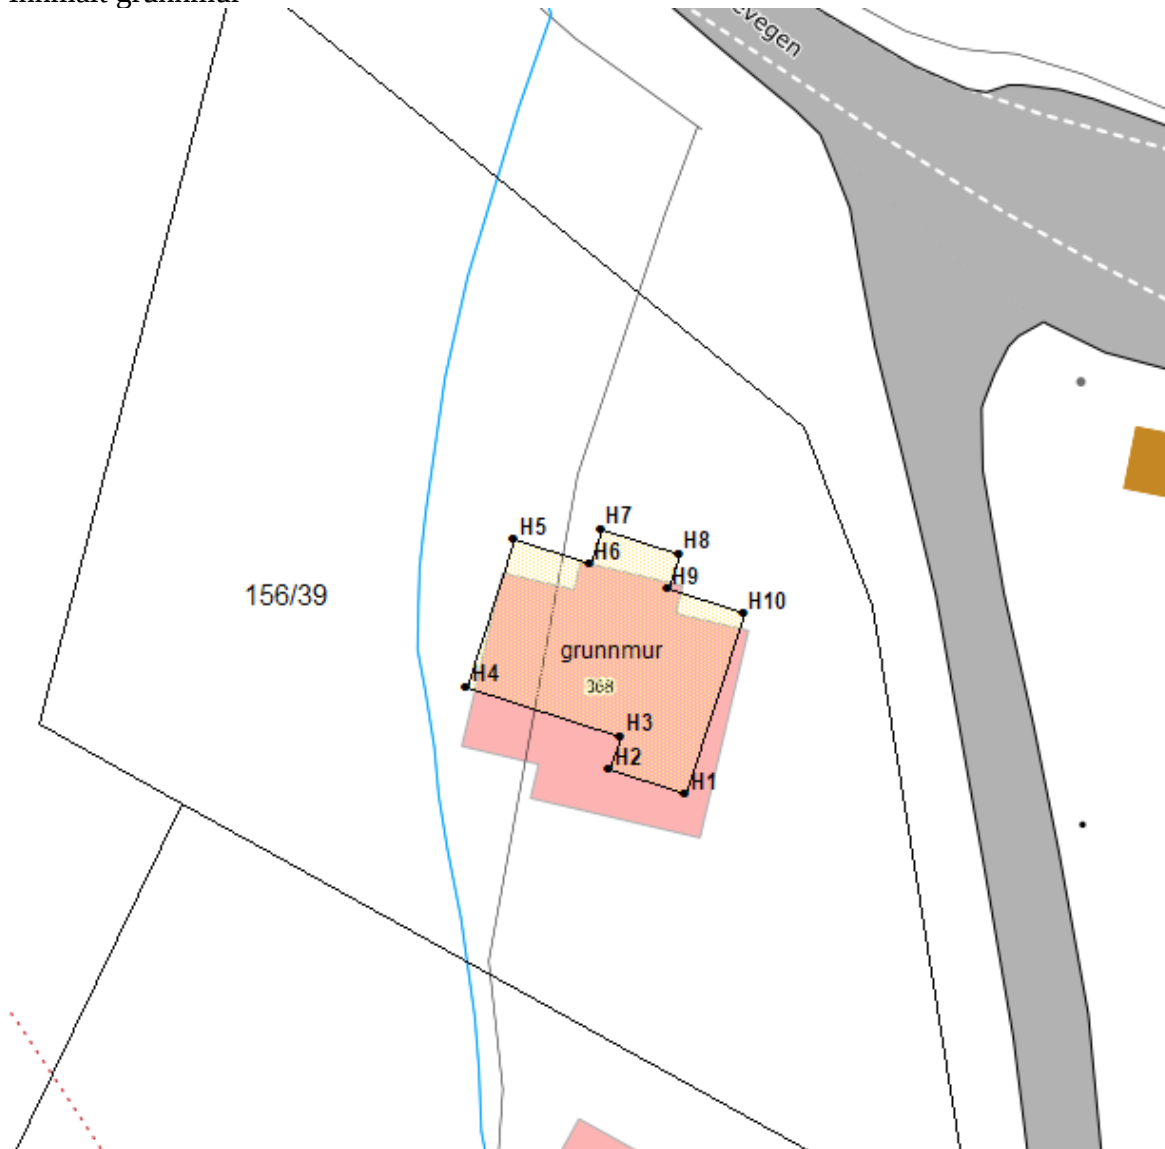

PunktID	N-koord.	Ø-koord.	Høyde
H1	6726400,36	294700,34	34,40
H2	6726401,54	294696,62	34,42
H3	6726403,16	294697,15	34,41
H4	6726405,58	294689,63	34,42
H5	6726412,82	294691,93	34,42
H6	6726411,61	294695,64	34,42
H7	6726413,33	294696,19	34,41
H8	6726412,10	294699,99	34,42
H9	6726410,39	294699,44	34,41
H10	6726409,21	294703,16	34,41