


Alver kommune

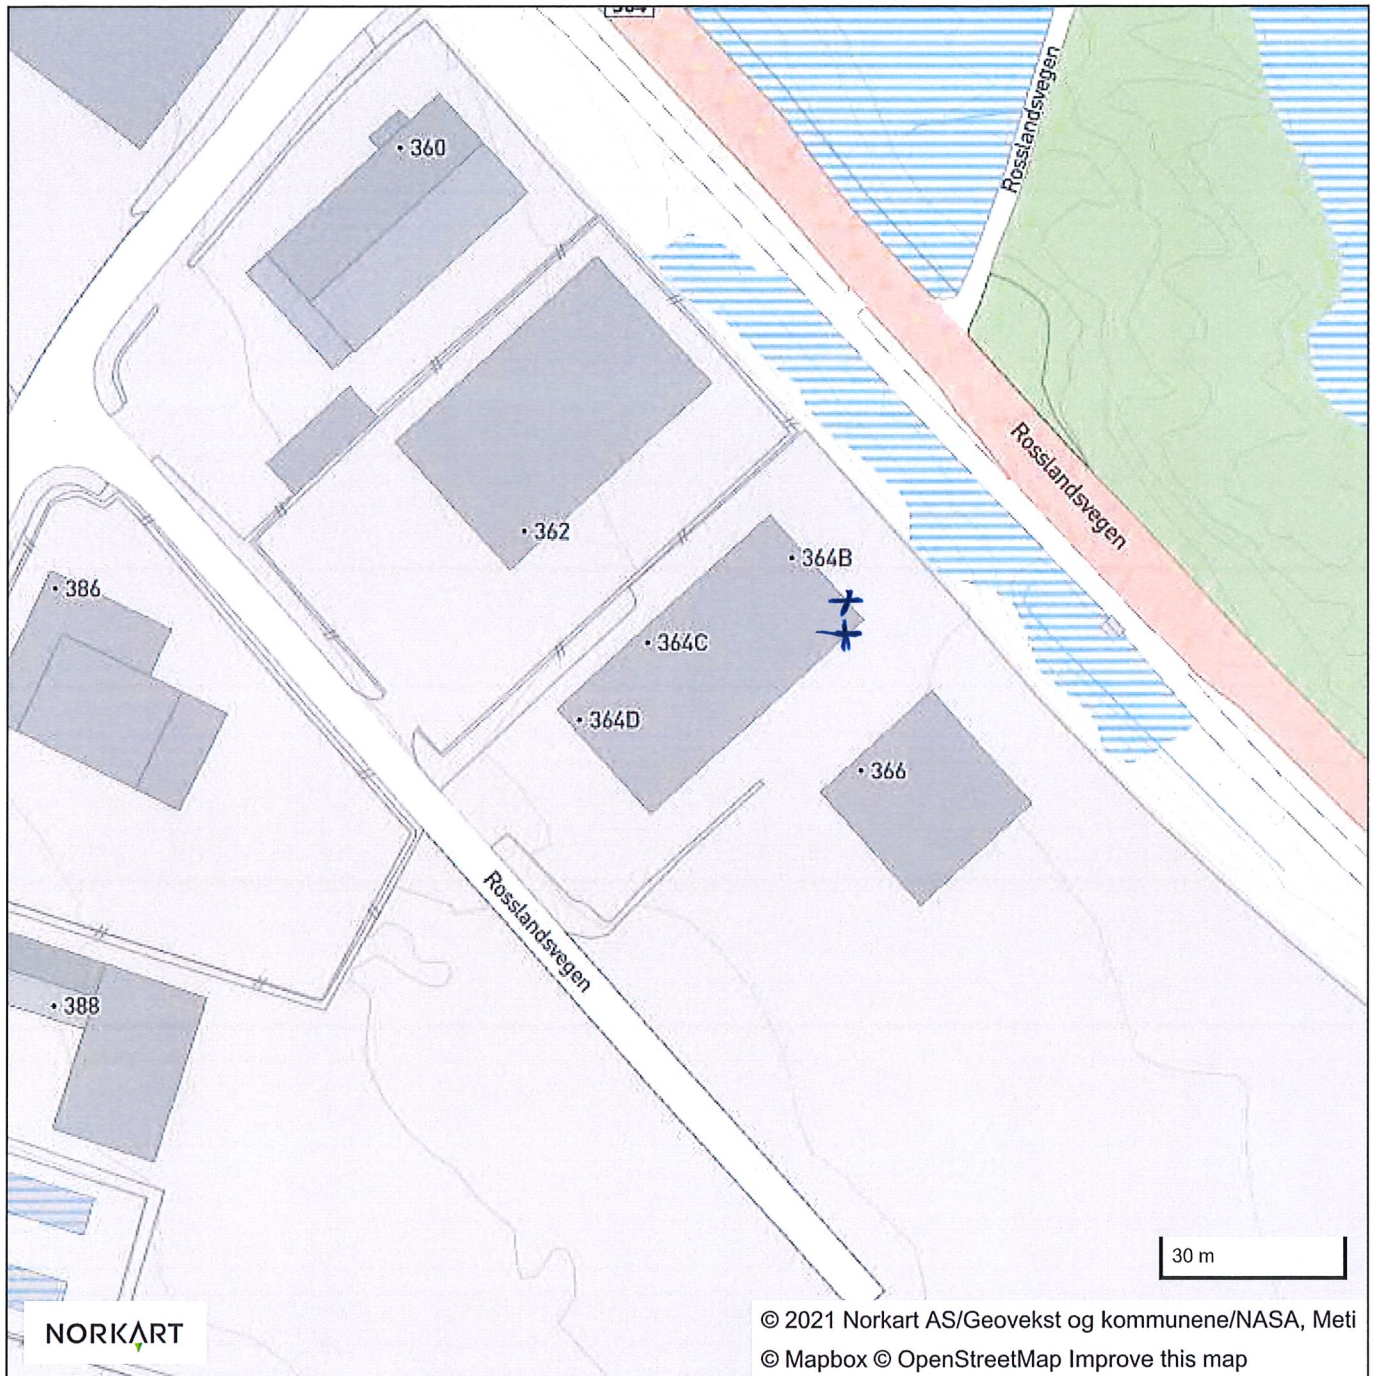

322/259

Rosslandsvegen 364, 5918 Frelkhaug

F2