

Y 293800

Y 293700


Y 293600

X 6717500

X 6717400



Kartvedlegg, veggrett  
25.06.2021  
Målestokk 1:1000

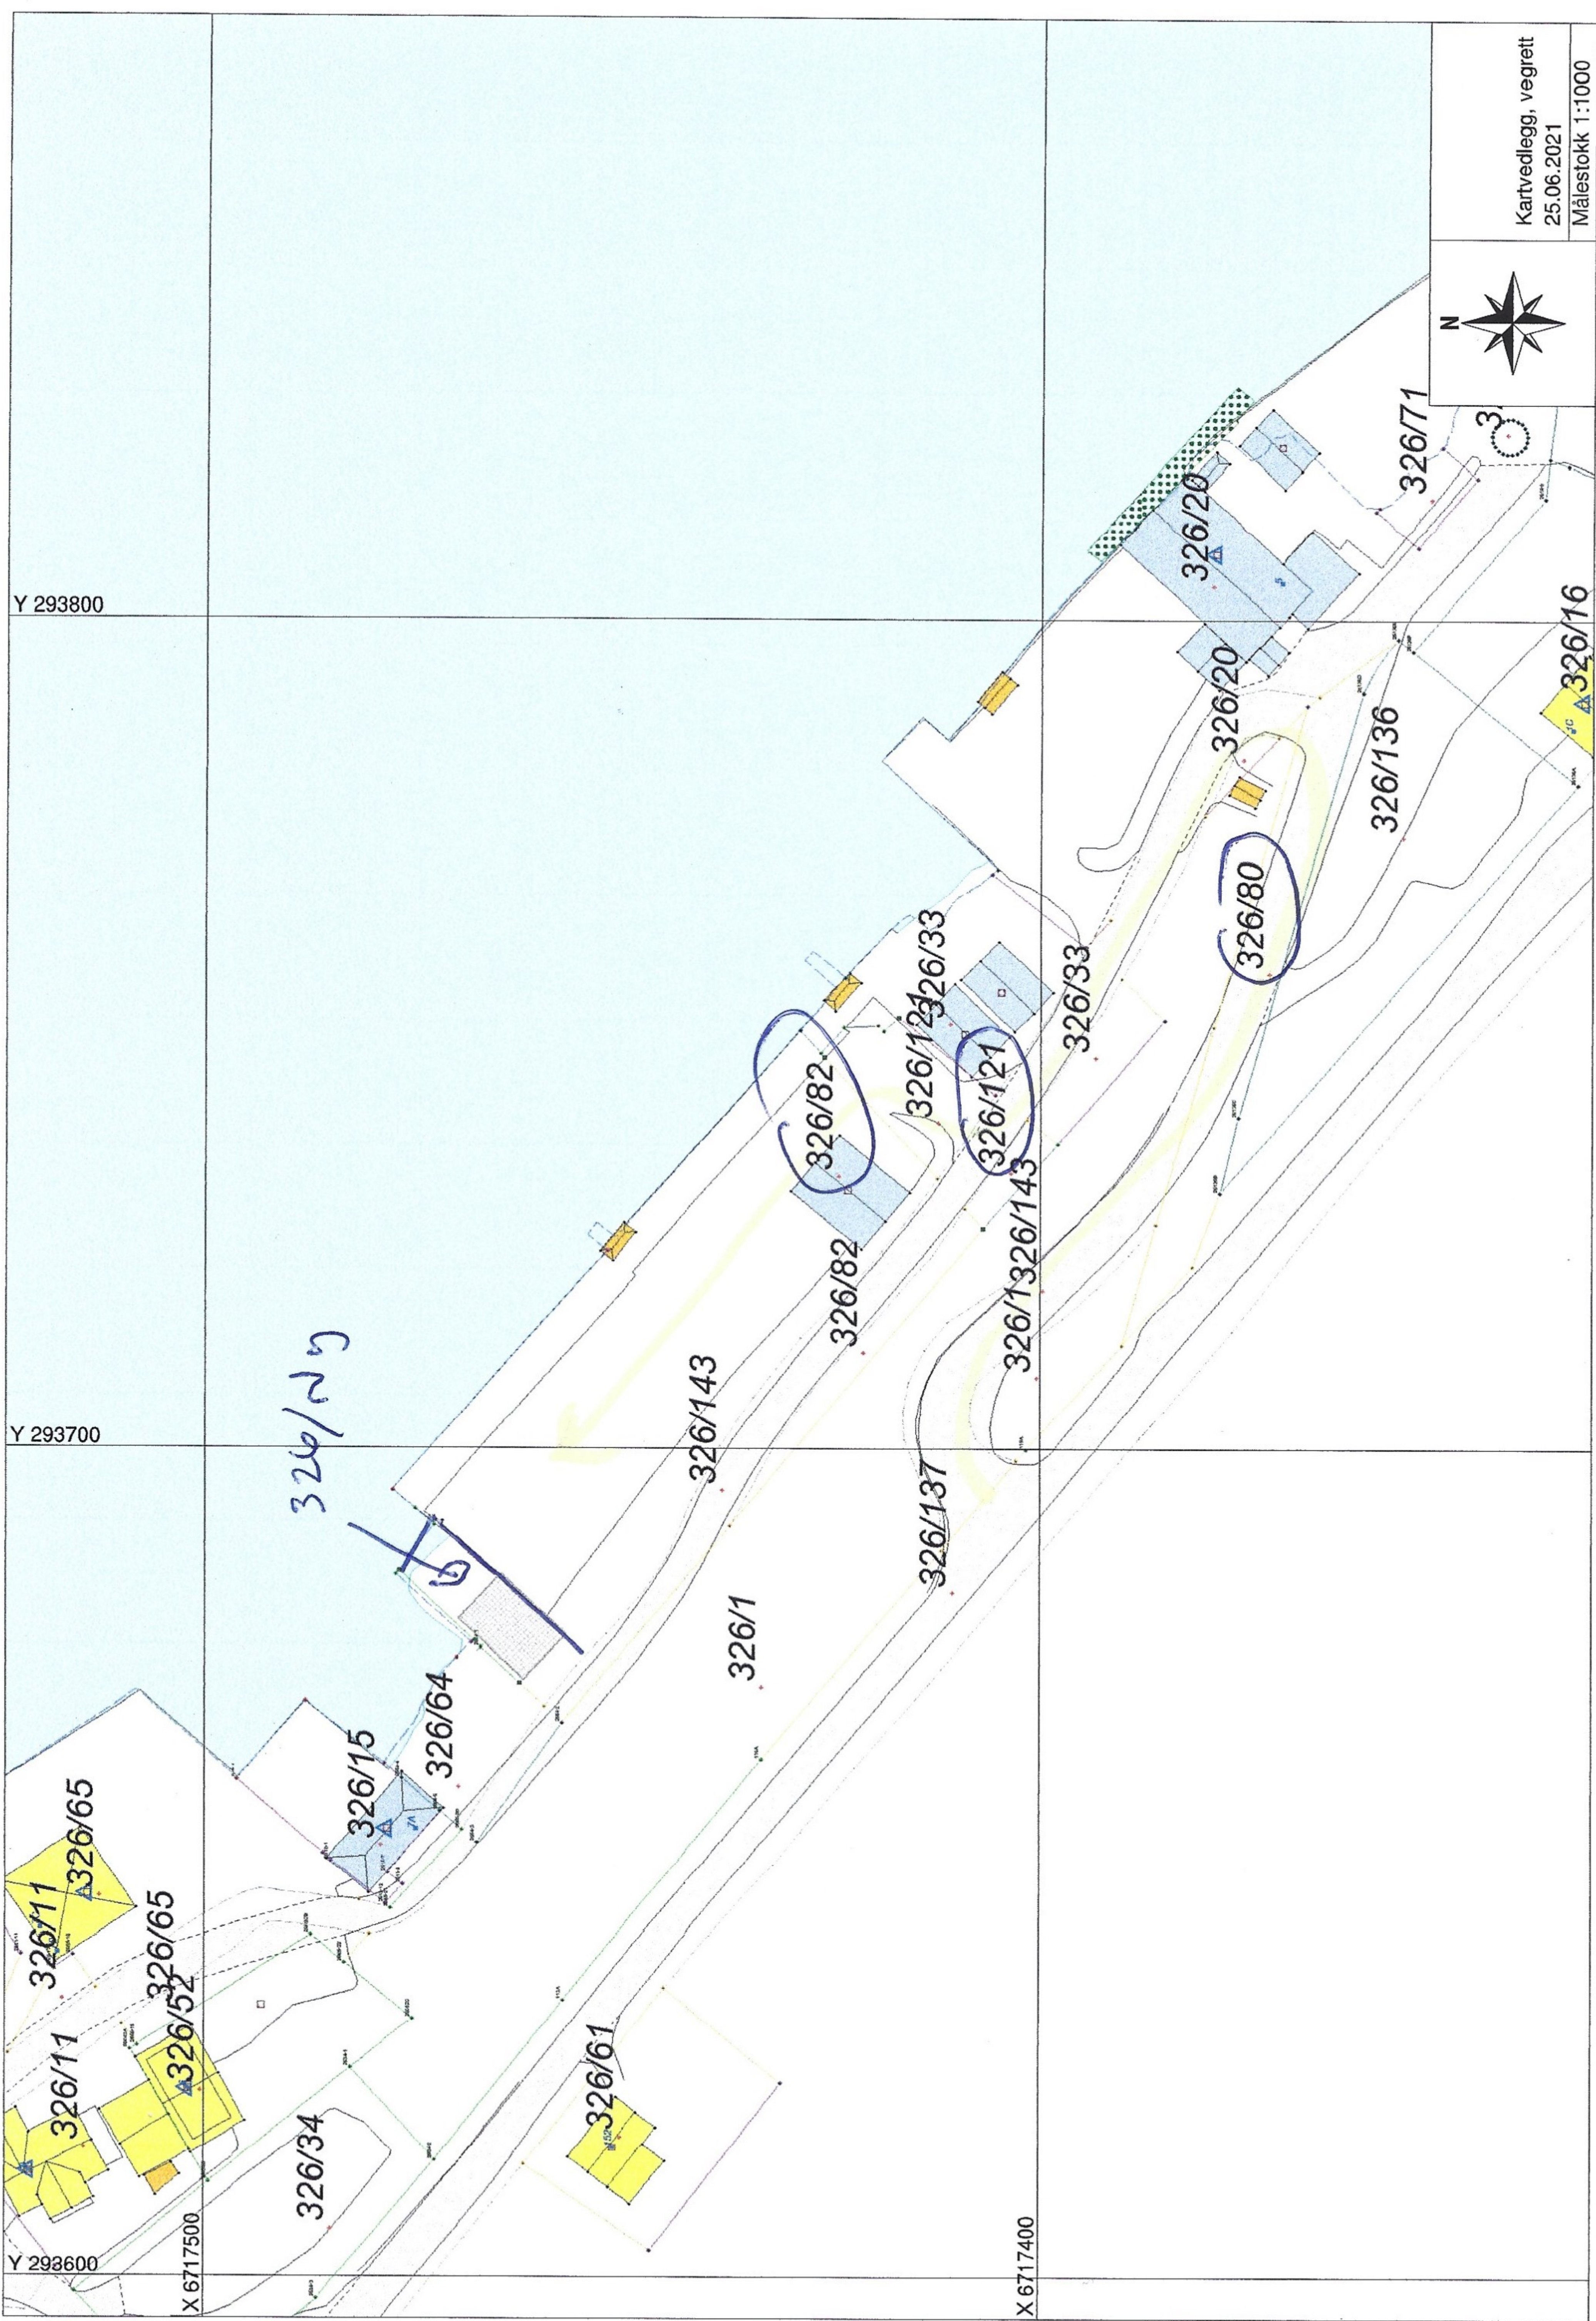

326/11  
326/65  
326/52  
326/65

326/34  
326/15  
326/64

326/61

326/143

326/1

326/82

326/137

326/121

326/1326/143

326/33

326/20

326/20

326/80

326/136

326/71

326/16