

INNMÅLINGSTJENESTER AS



Organisasjonsnr. 979 927 703
Bankgiro: 3624 07 79751

Vår ref:
Knut Henanger, Hellevik Hus

Deres ref:

Dato: 14.12.20.

Innmålingsdata for Lyngnesvegen 18, Gnr.351 Bnr.106, Alver Kommune.

<u>HYTTE</u>					
<u>PUNKT</u>	<u>TEMA</u>	<u>X</u>	<u>Y</u>	<u>topp</u>	<u>gr.mur</u>
05 1	5000	6724693.861	284784.498	7.913	
05 2	5000	6724686.134	284783.640	7.900	
05 3	5000	6724685.826	284786.489	7.885	
05 4	5000	6724684.023	284786.316	7.884	
05 5	5000	6724683.698	284789.263	7.903	
05 6	5000	6724685.478	284789.482	7.895	
05 7	5000	6724684.687	284796.539	7.885	
05 8	5000	6724692.438	284797.384	7.891	
05 9	5000	6724692.972	284792.731	7.887	
05 10	5000	6724695.819	284793.023	7.879	
05 11	5000	6724696.343	284788.270	7.896	
05 12	5000	6724693.494	284787.973	7.886	
<u>tomten</u>					
05 14	4011	6724676.590	284794.690		
05 15	4011	6724690.010	284773.630		
05 16	4011	6724718.270	284784.670		
05 17	4011	6724718.810	284784.880		
05 18	4011	6724724.520	284802.510		
05 19	4011	6724725.110	284821.150		
05 20	4011	6724725.080	284821.680		
05 21	4011	6724724.350	284821.280		
05 22	4011	6724676.590	284794.690		
09_99					

Med vennlig hilsen
Innmålingstjenester as

Kjersti K. Madsen

Kontoradresse:
Telefon
Kjersti K. Madsen
Johnny Sandvik

Helgeplasset 144
55 59 02 77 (76)
Mob.tlf.90 78 72 08
Mob.tlf.40 40 23 23

5148 Fyllingsdalen
E.Post: innmal@innmal.no



Y 284750


Y 284800

X 6724750

Skisse for Gnr.351 Bnr.106

Lyngnesvegen 18, Alver Kommune

X 6724700

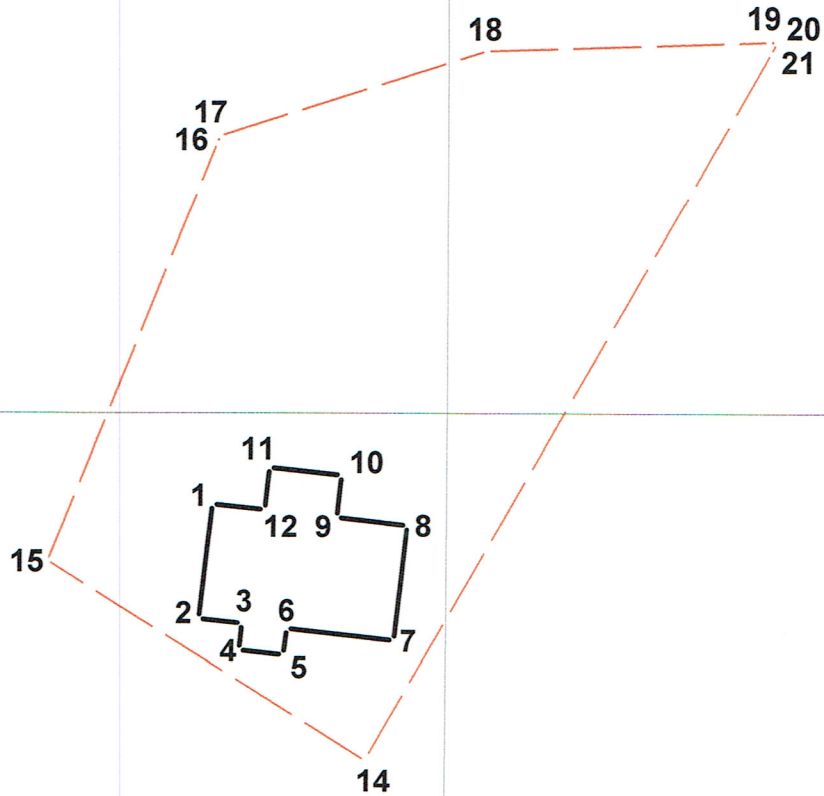

X 6724650



Skisse for Gnr.351 Bnr.106
Lyngnesvegen 18, Alver Kommune
Hellevik Hus as, Frekhaug
Dato: 14/12/20

Målestokk 1:500

Innmålingstjenester as

Gerh. K. Maden

351-106

-00 FF
 -01 000000000000 DDDDDDDDDDD VVVVVVVVVVVV KKKKKKKKKKKK 000000000000
 -02 SSSSSSSSSS KKKKKKKK NNNNNNNN TTTTTTTT TTTTTTTT II.III Bk MMMMMMM
 -03 TTTTTTTTTT KKKKKKKK HHH.HHHH VVV.VVVV AAAA.AAA SS.SSS Bk MMMMMMM
 -04 TTTTTTTTTT KKKKKKKK HHH.HHHH DDDD.DDD AAAA.AAA SS.SSS Bk MMMMMMM
 -05 PPPPPPPPPP KKKKKKKK XXXXXXXX.XXX YYYYYYY.YYY ZZZZ.ZZZ Bk MMMMMMM
 -06 PPPPPPPPPP KKKKKKKK PPPPPPPP.PPP AAAAAAA.AAA ZZZZ.ZZZ Bk MMMMMMM
 -07 PPPPPPPPPP KKKKKKKK dXXXXXXX.XXX dYYYYYY.YYY dZZZ.ZZZ Bk MMMMMMM

-08 Epi E1 E2 E3 E4
 -09_Pi Sammenheng FF MMMMMMM

-00 Leica Geosystems AG

-00 Instrument: GX1230 GG Måledato: 14.12.2020
 -00 Målejobb: 351-106 Operatør:Kjersti K.Madsen

-00 Jobbeskrivelse:innmåling topp gr mur.Lyngnesvegen 18,Alver Komm

-00 Målt i euref89 NN2000

09_91

05 1	9990	6724693.861	284784.498	7.913	0.014
05 2	9990	6724686.134	284783.640	7.900	0.017
05 3	9990	6724685.826	284786.489	7.885	0.013
05 4	9990	6724684.023	284786.316	7.884	0.012
05 5	9990	6724683.698	284789.263	7.903	0.015
05 6	9990	6724685.478	284789.482	7.895	0.014
05 7	9990	6724684.687	284796.539	7.885	0.017
05 8	9990	6724692.438	284797.384	7.891	0.012
05 9	9990	6724692.972	284792.731	7.887	0.015
05 10	9990	6724695.819	284793.023	7.879	0.012
05 11	9990	6724696.343	284788.270	7.896	0.013
05 12	9990	6724693.494	284787.973	7.886	0.012

09_99