


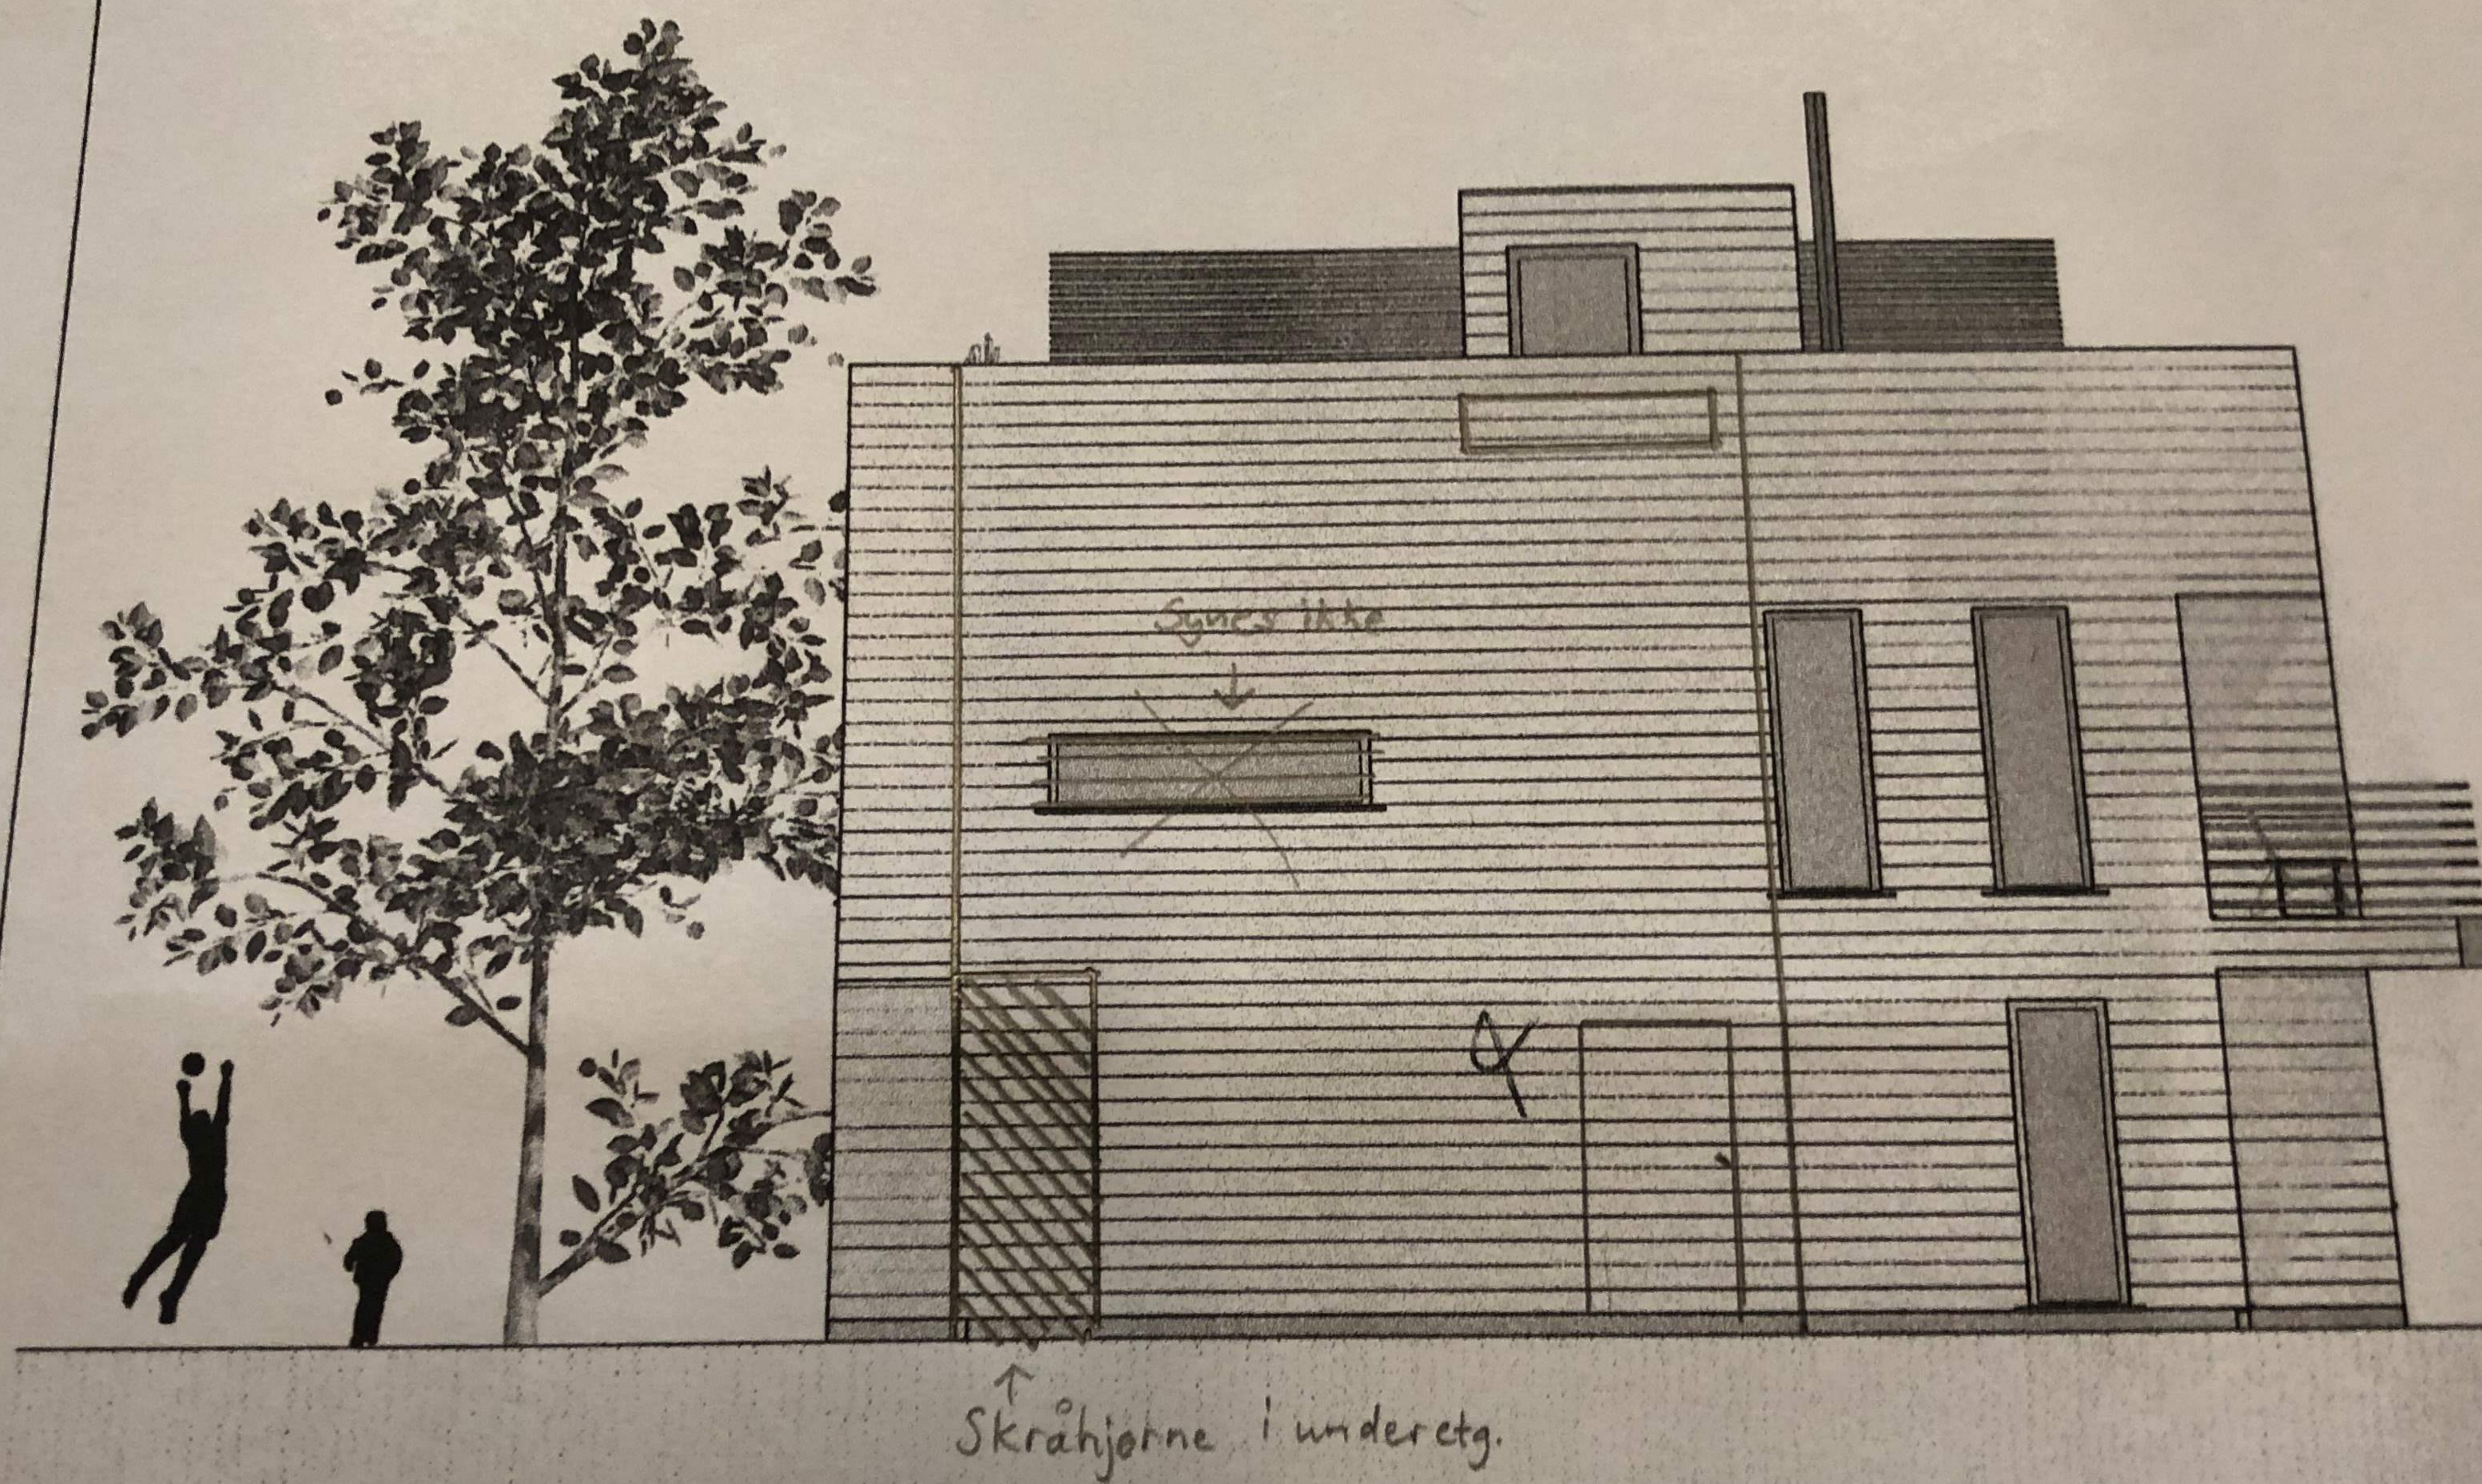

1:100 Fasade ~~Vest~~ Nord