



783-22.5.73
 Ark.no. 214-46
 005 E

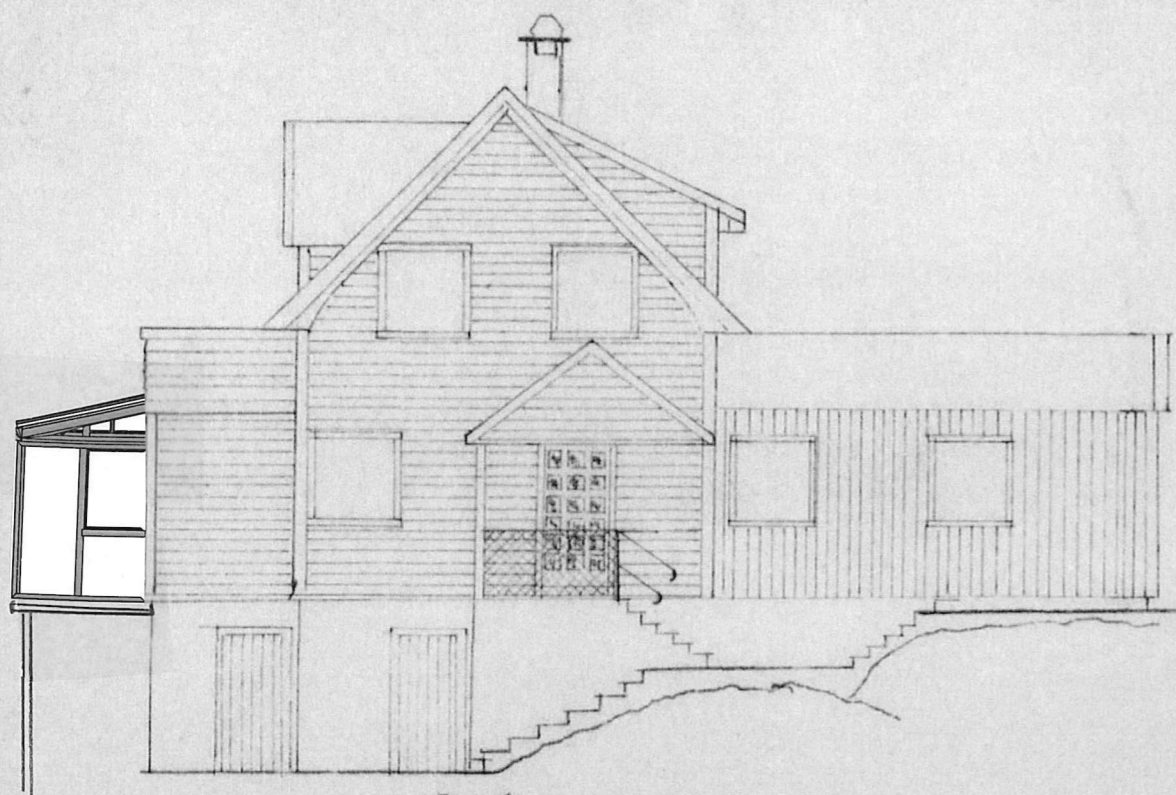


NØ

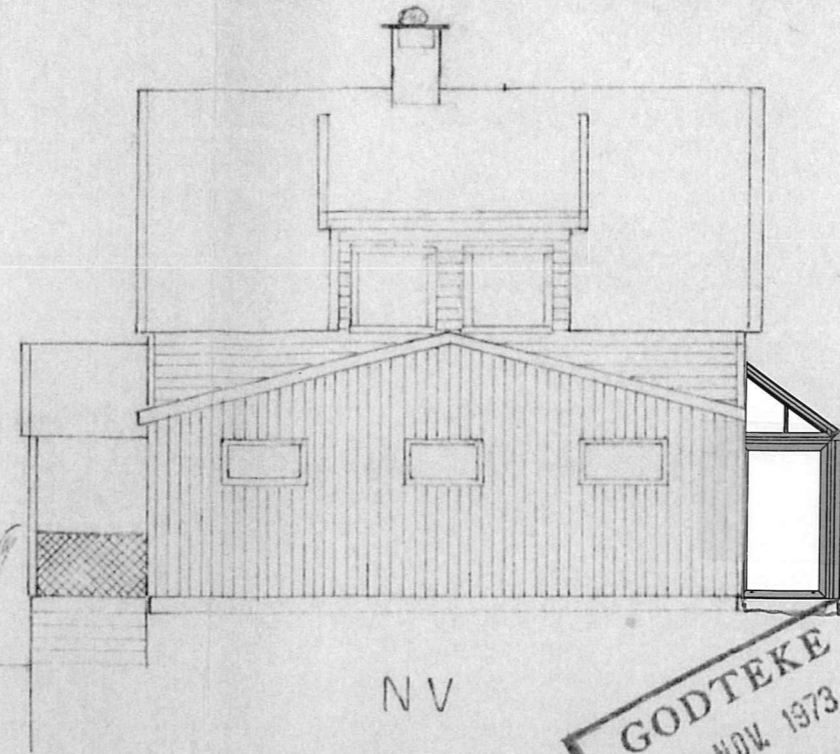


NV



GODTEKE
 - 2 NOV. 1973
 Lindås Bygningsråd

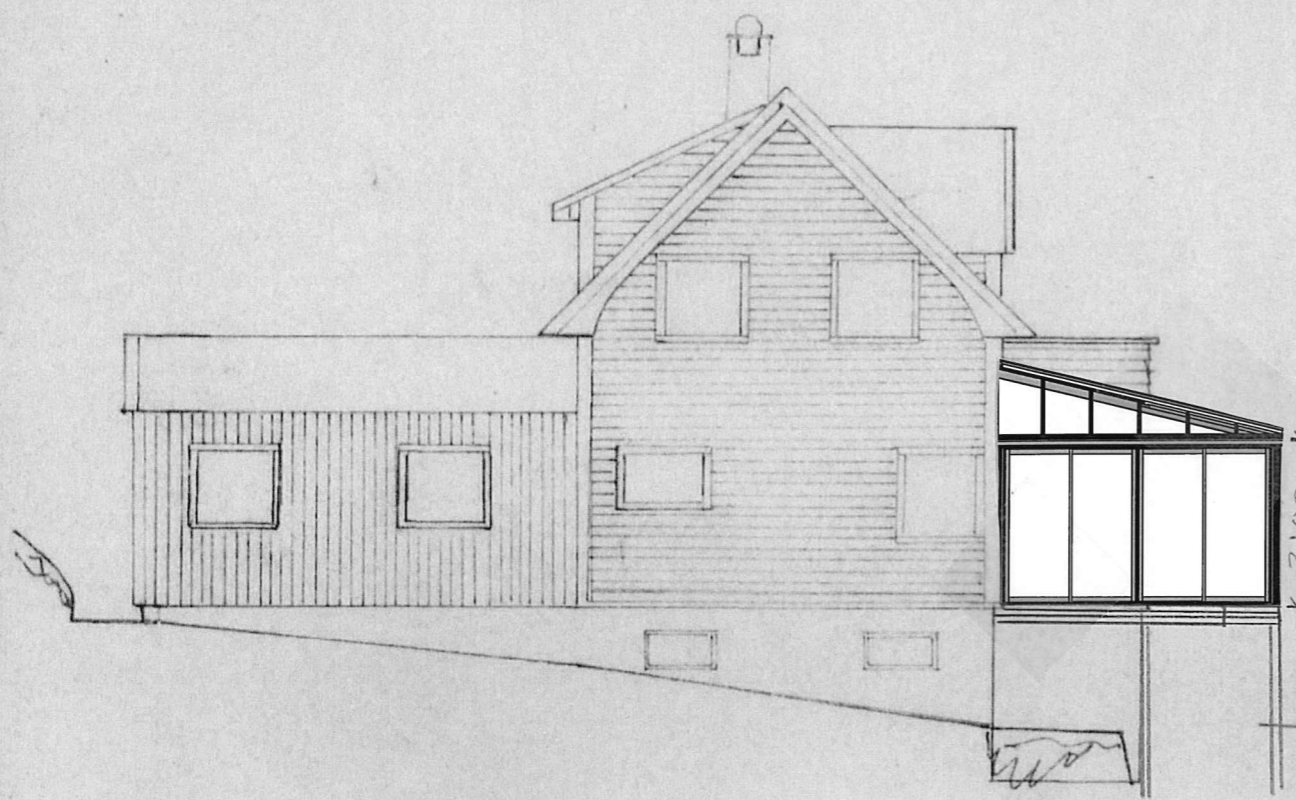

SV

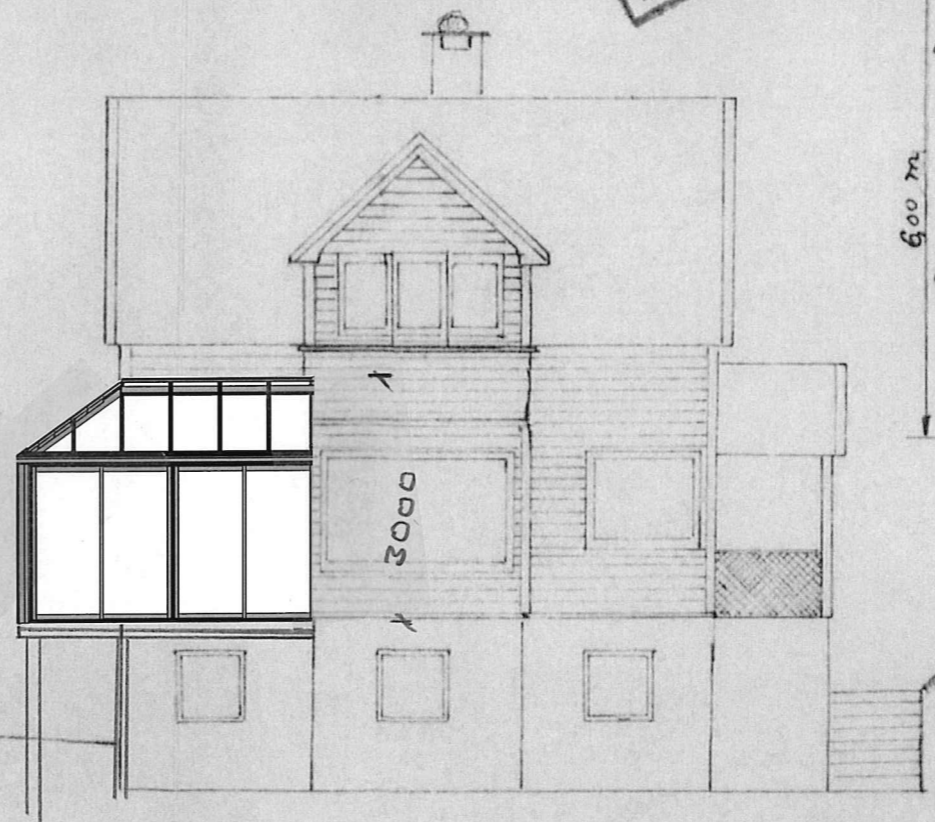

SØ

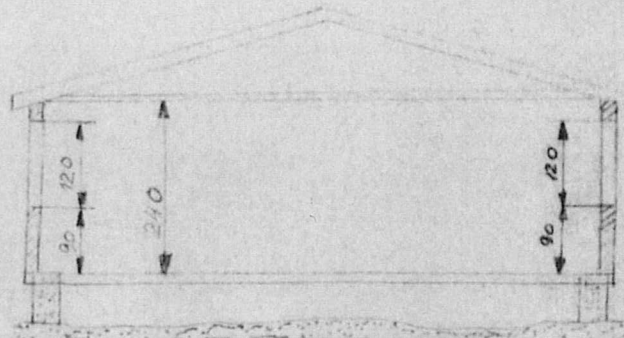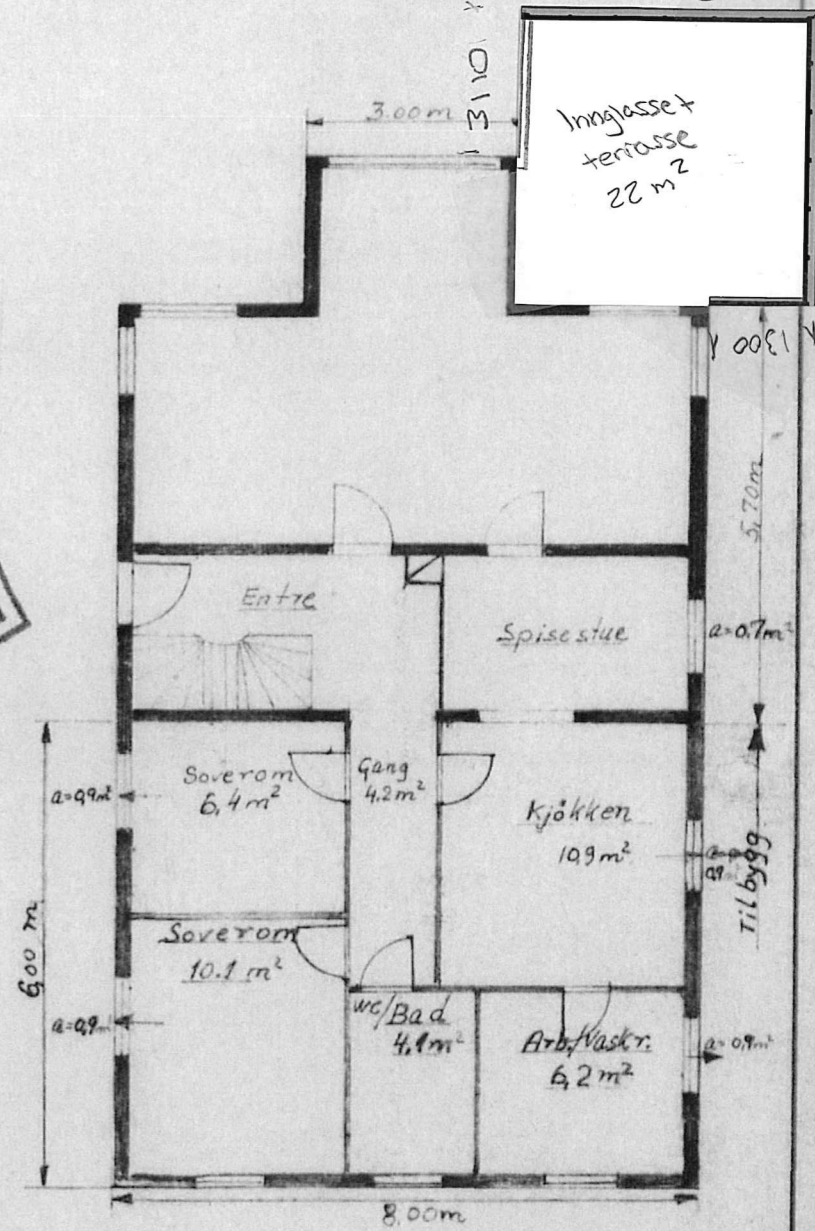

TILBYGG "LUNDEVOLL" GNR 214 BNR 57	Målestokk	Tegn.
	1:100	Trac. Kfr.
ARVID LØNDAL EIKANGERVÅG	Erstatning for:	
	Korr. 22/11-1973	
Erstattet av:		