



783-22.5.73  
 Ark.no. 214-46  
 005 E

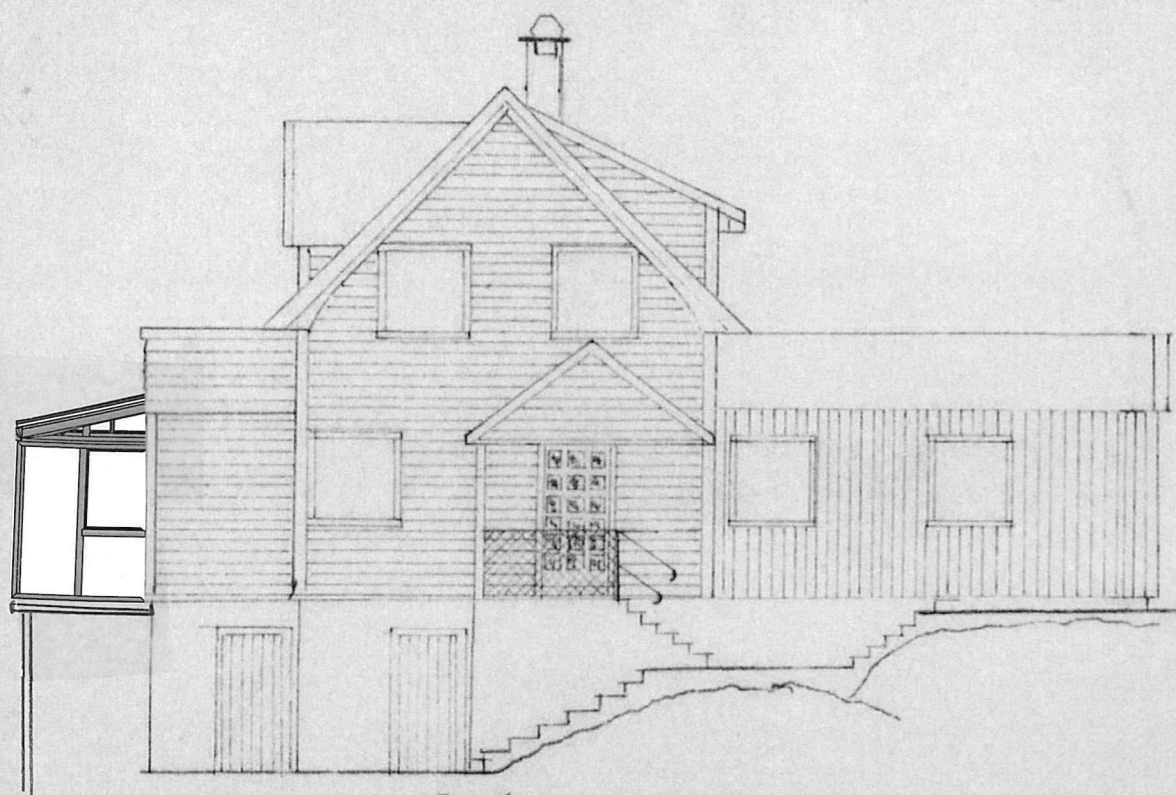


NØ

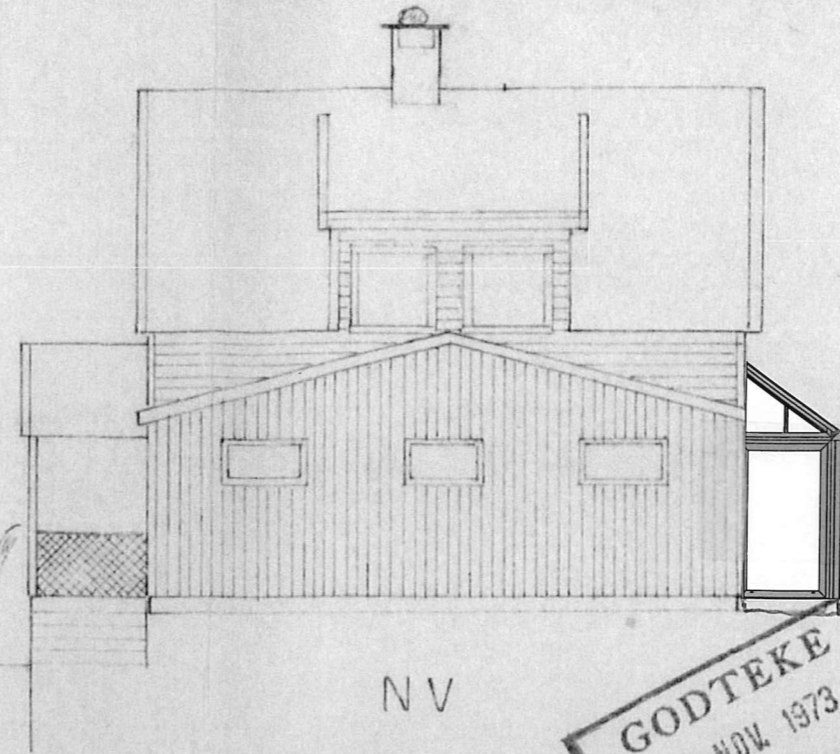


NV


GODTEKE  
 - 2 NOV. 1973  
 Lindås Bygningsråd

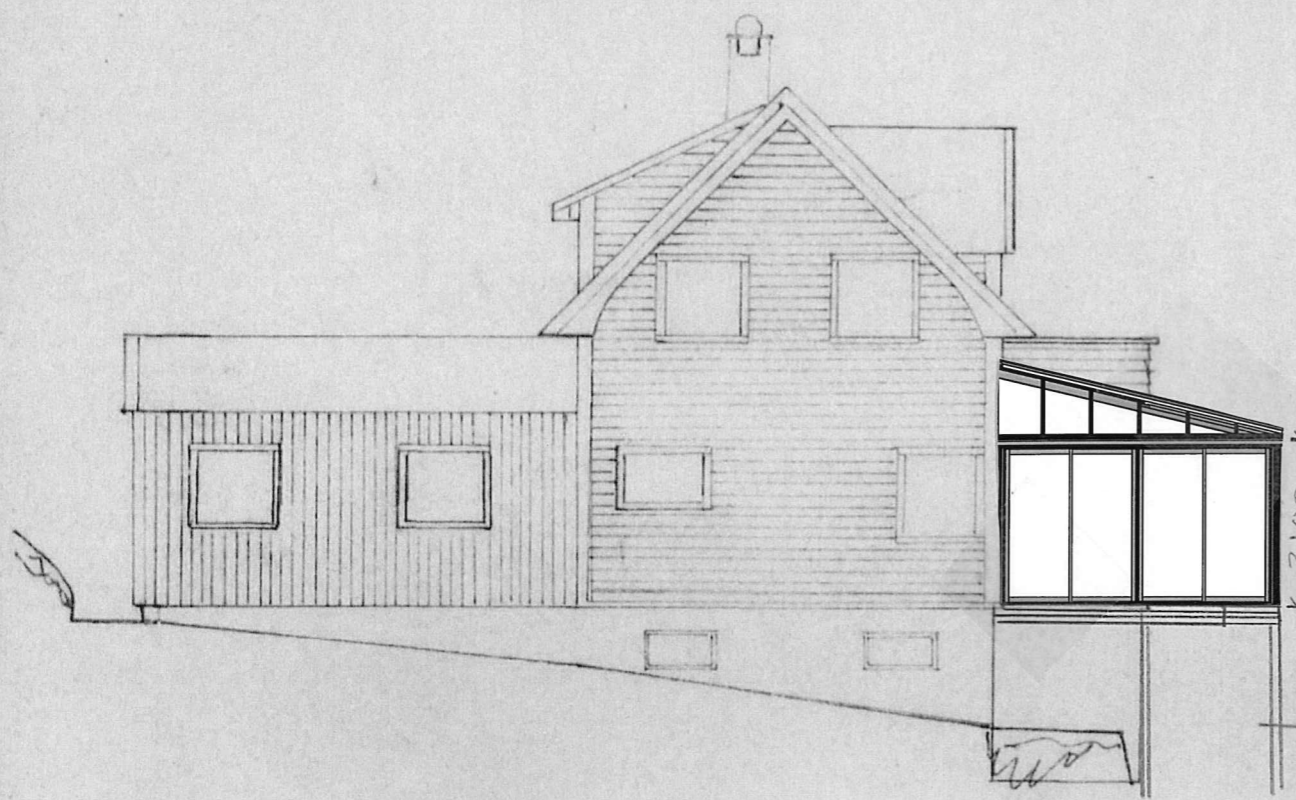

SV

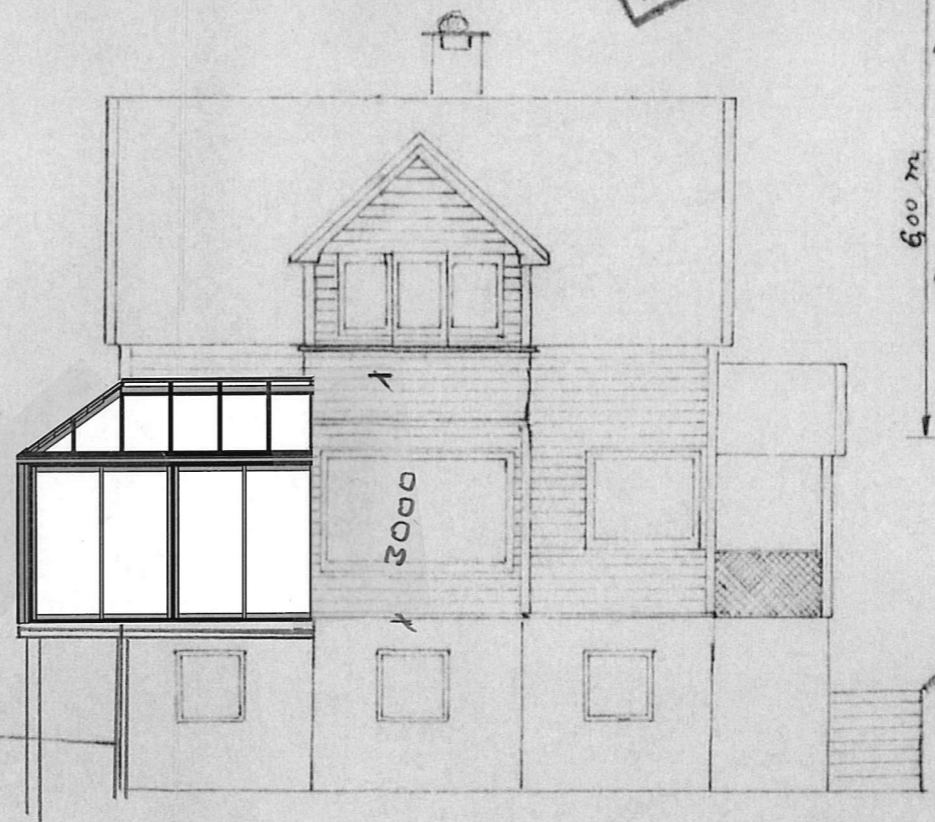

SØ

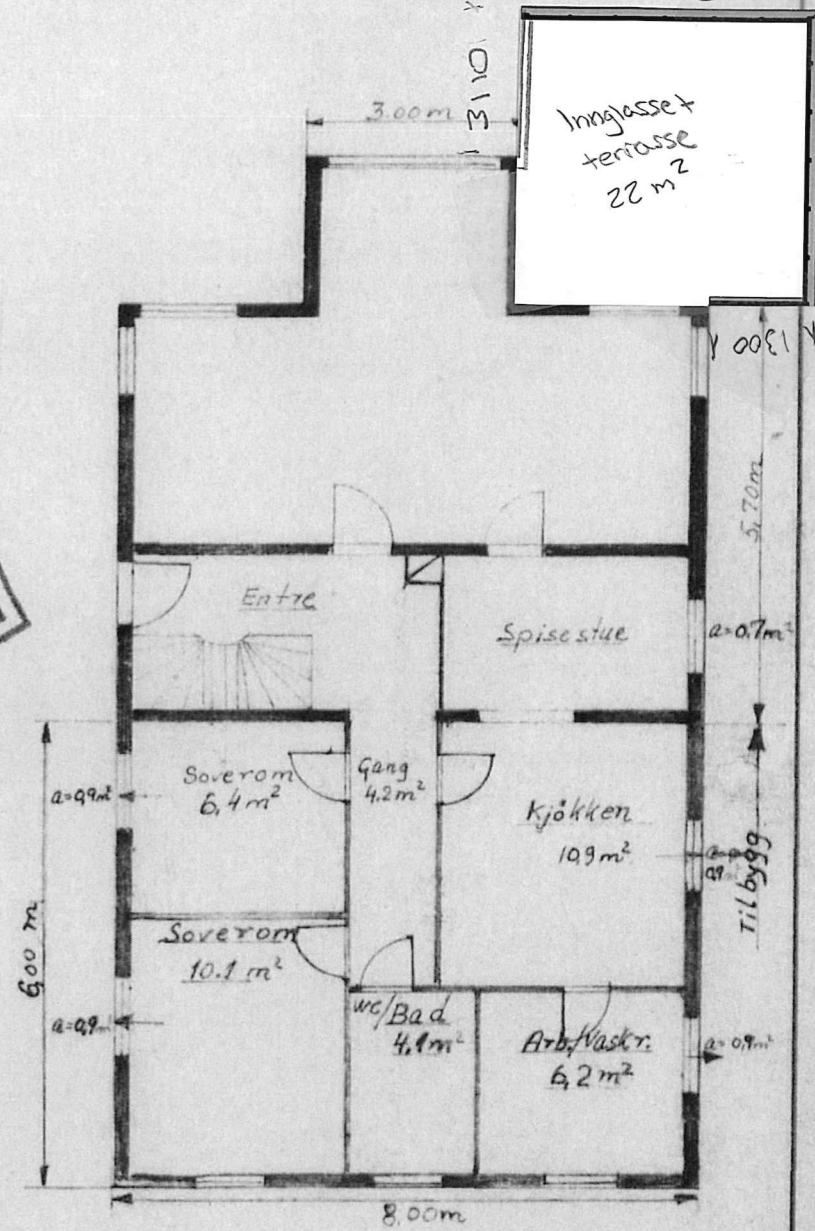

TILBYGG  
 "LUNDEVOLL"  
 GNR 214 BNR 57  
 ARVID LØNDAL  
 EIKANGERVÅG

Målestokk	Tegn.
1:100	Trac.
	Kfr.
Erstatning for:	
Korr. 22/11-1973	
Erstattet av:	