NHdigi.no

VEST VVS AS

03/09-2021
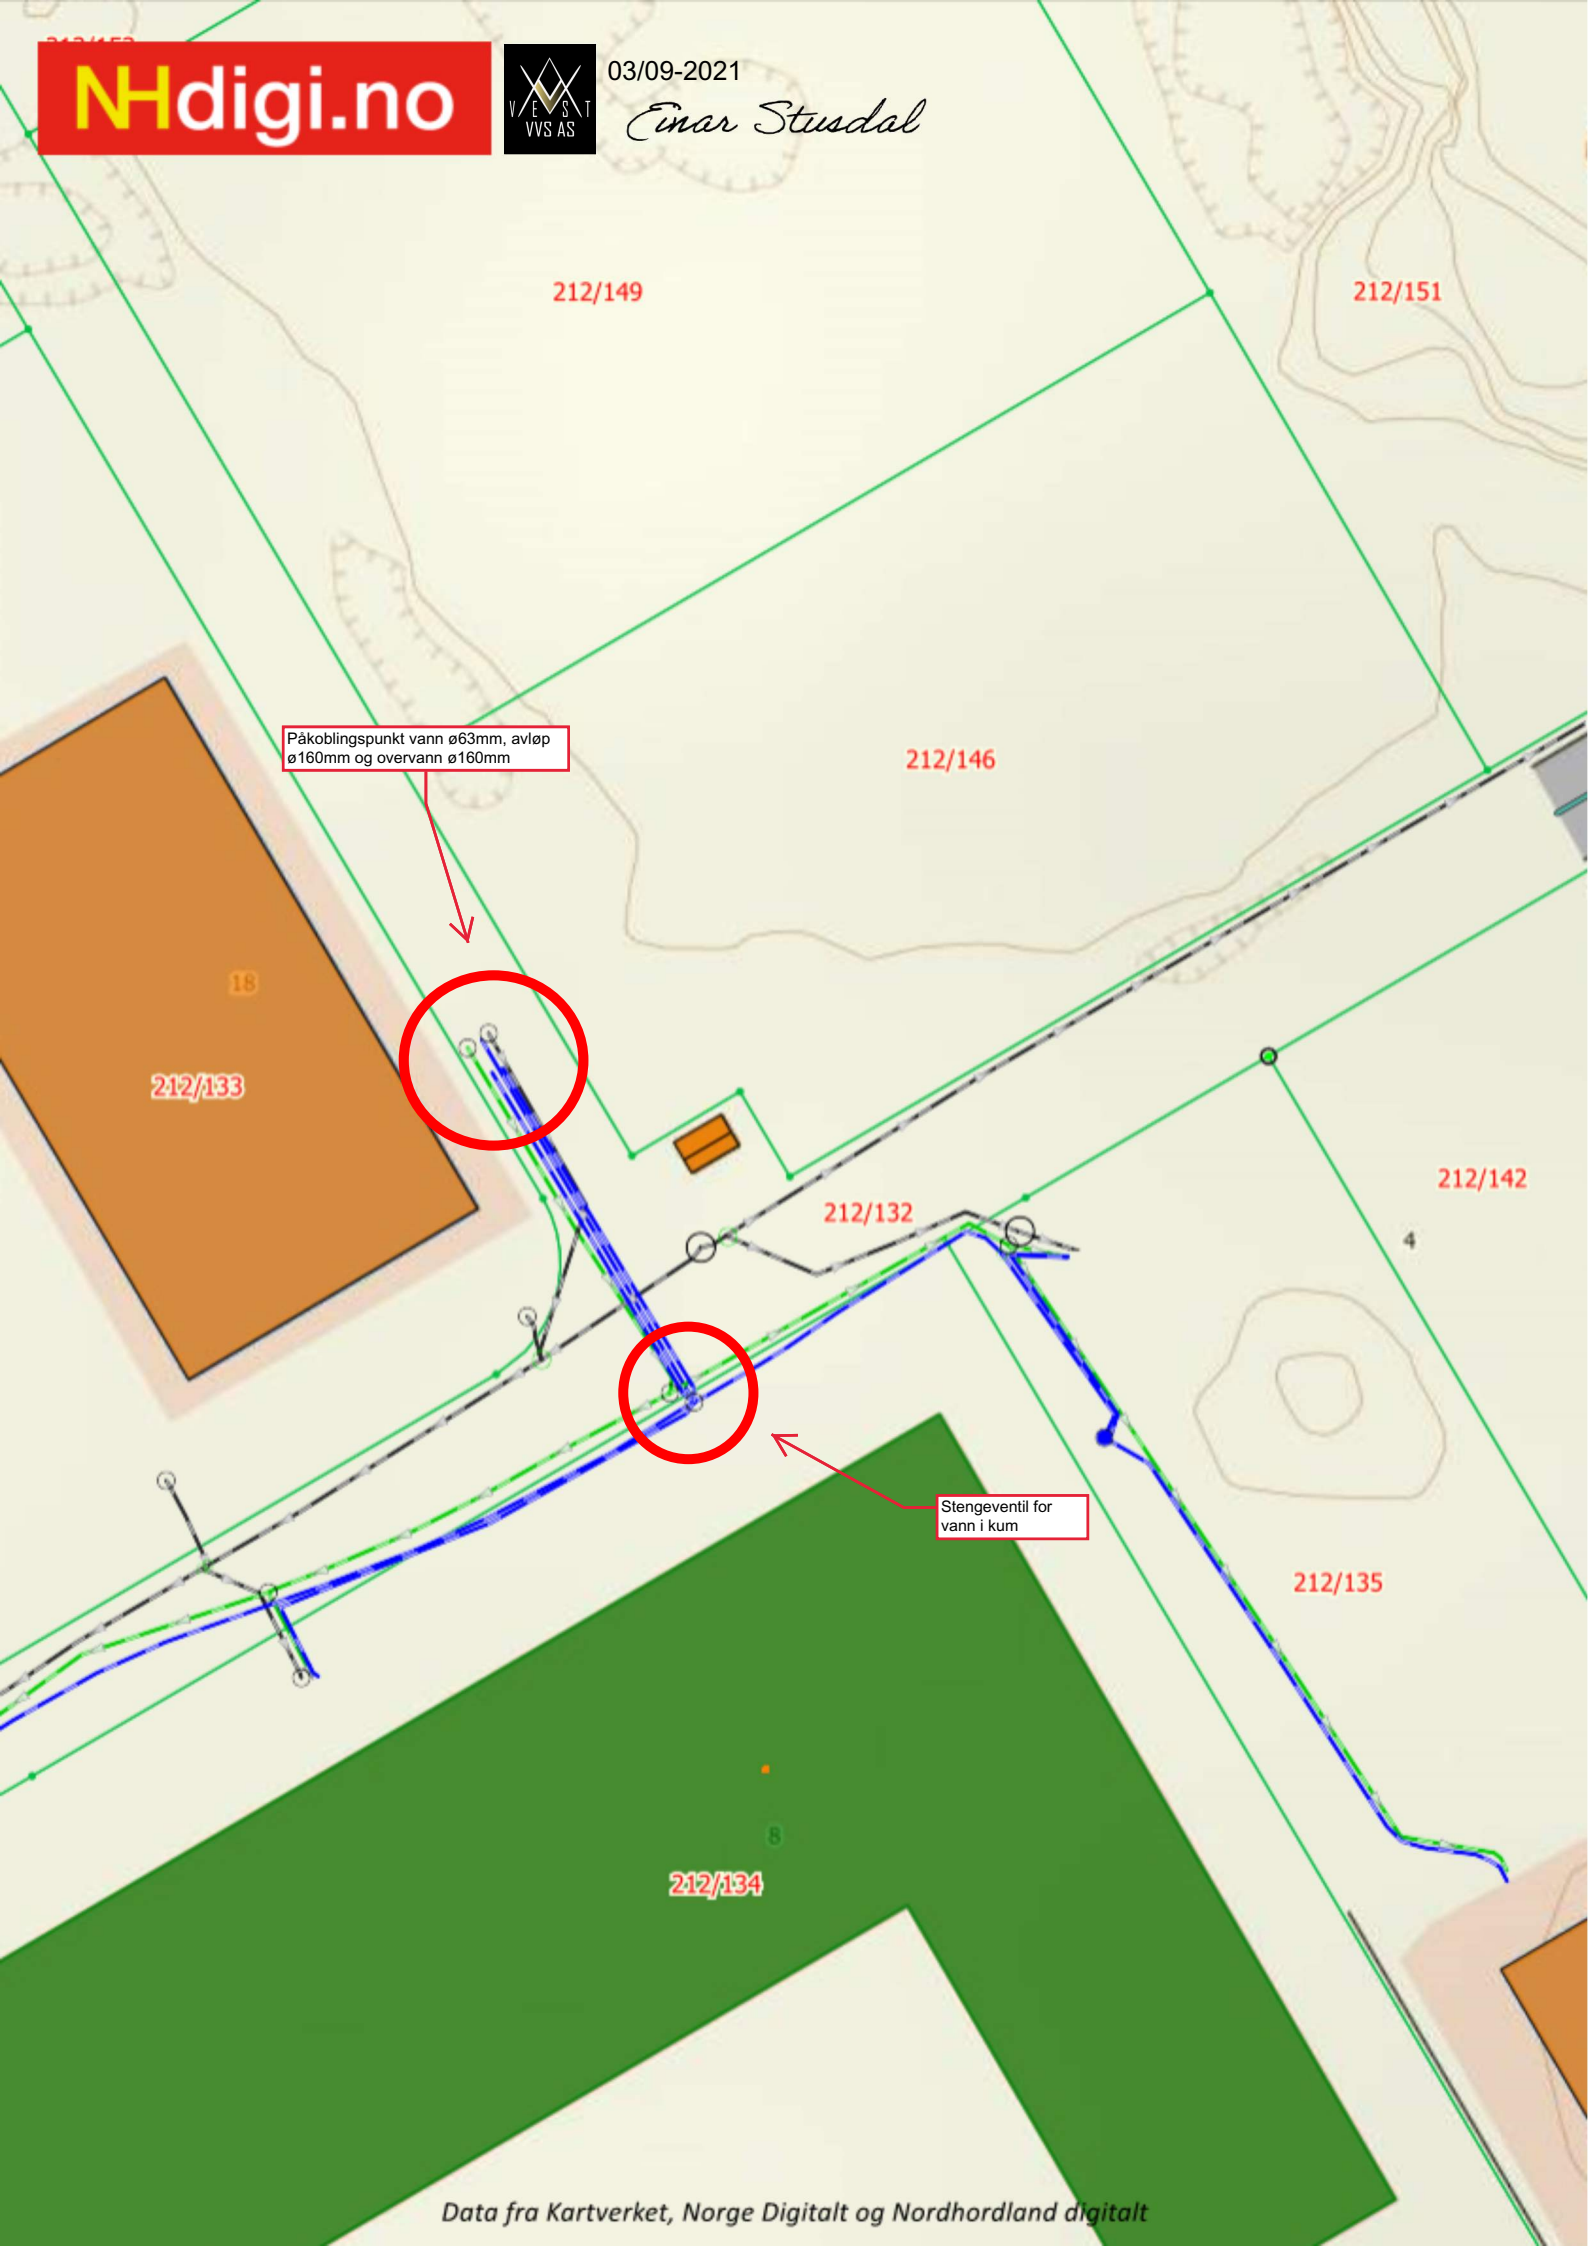
Einar Stusdal