


Senterposisjon: -36703.02, 6752386.98  
 Koordinatsystem: EPSG:25833  
 Utskriftsdato: 20.08.2021



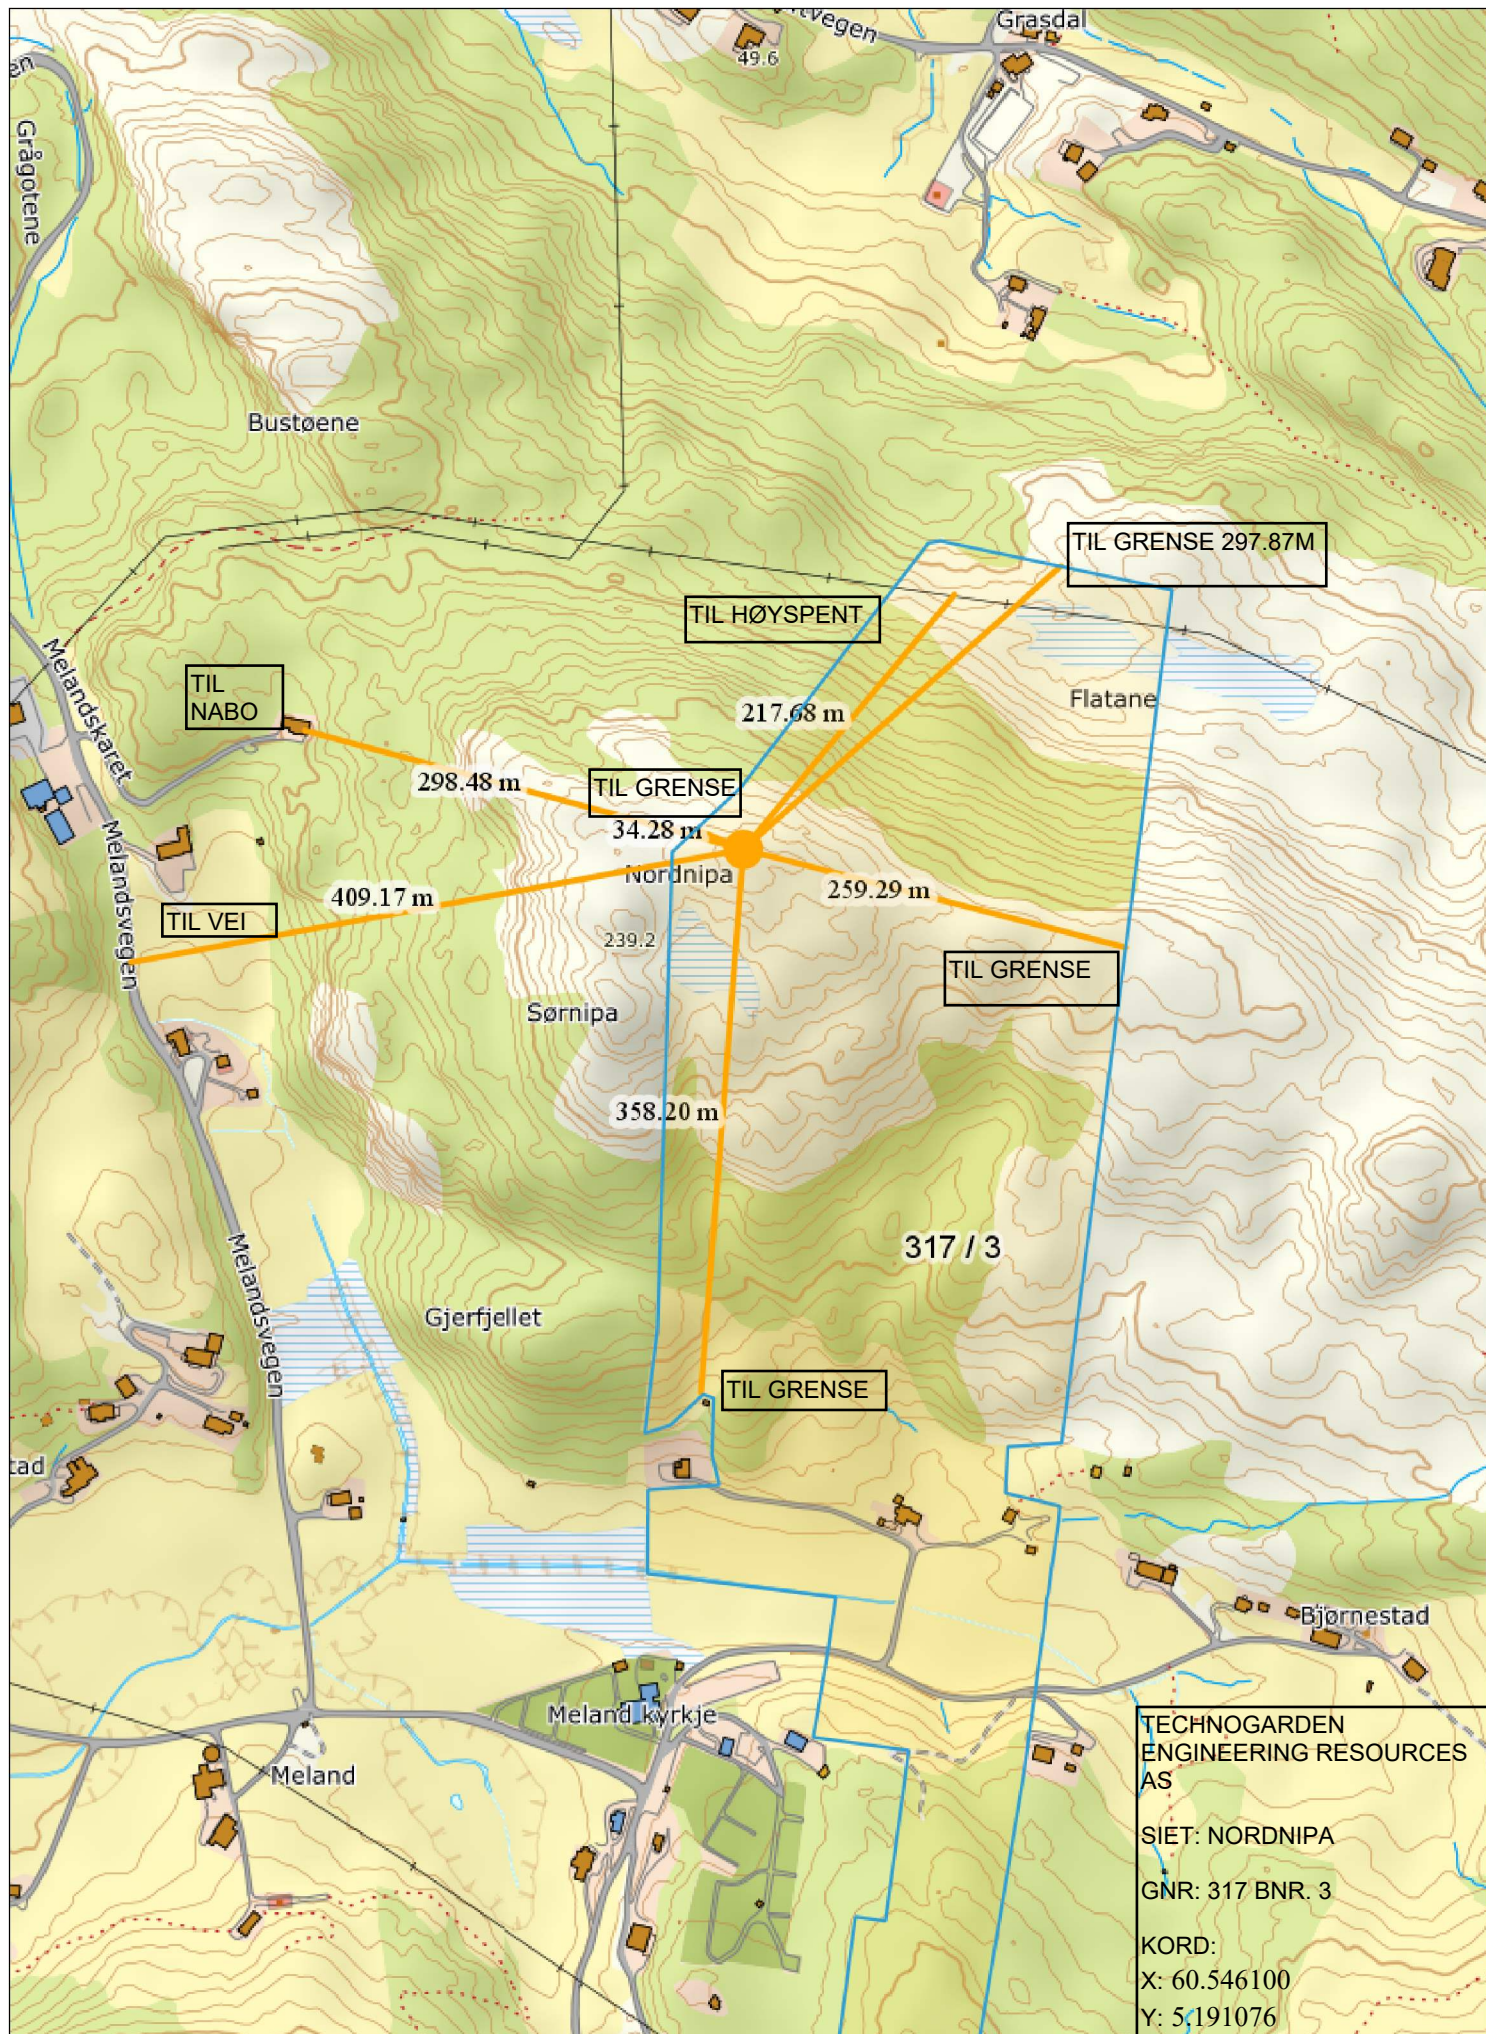

TECHNOGARDEN  
 ENGINEERING RESOURCES  
 AS  
 SIET: NORDNIPA  
 GNR: 317 BNR. 3  
 KORD:  
 X: 60.546100  
 Y: 5.191076

Senterposisjon: -36706.99, 6752266.66  
 Koordinatsystem: EPSG:25833  
 Utskriftsdato: 20.08.2021

0 50 100 150 200m