


*Vedlegg til skvad sine deling.*

*12/1-05 Ar.*




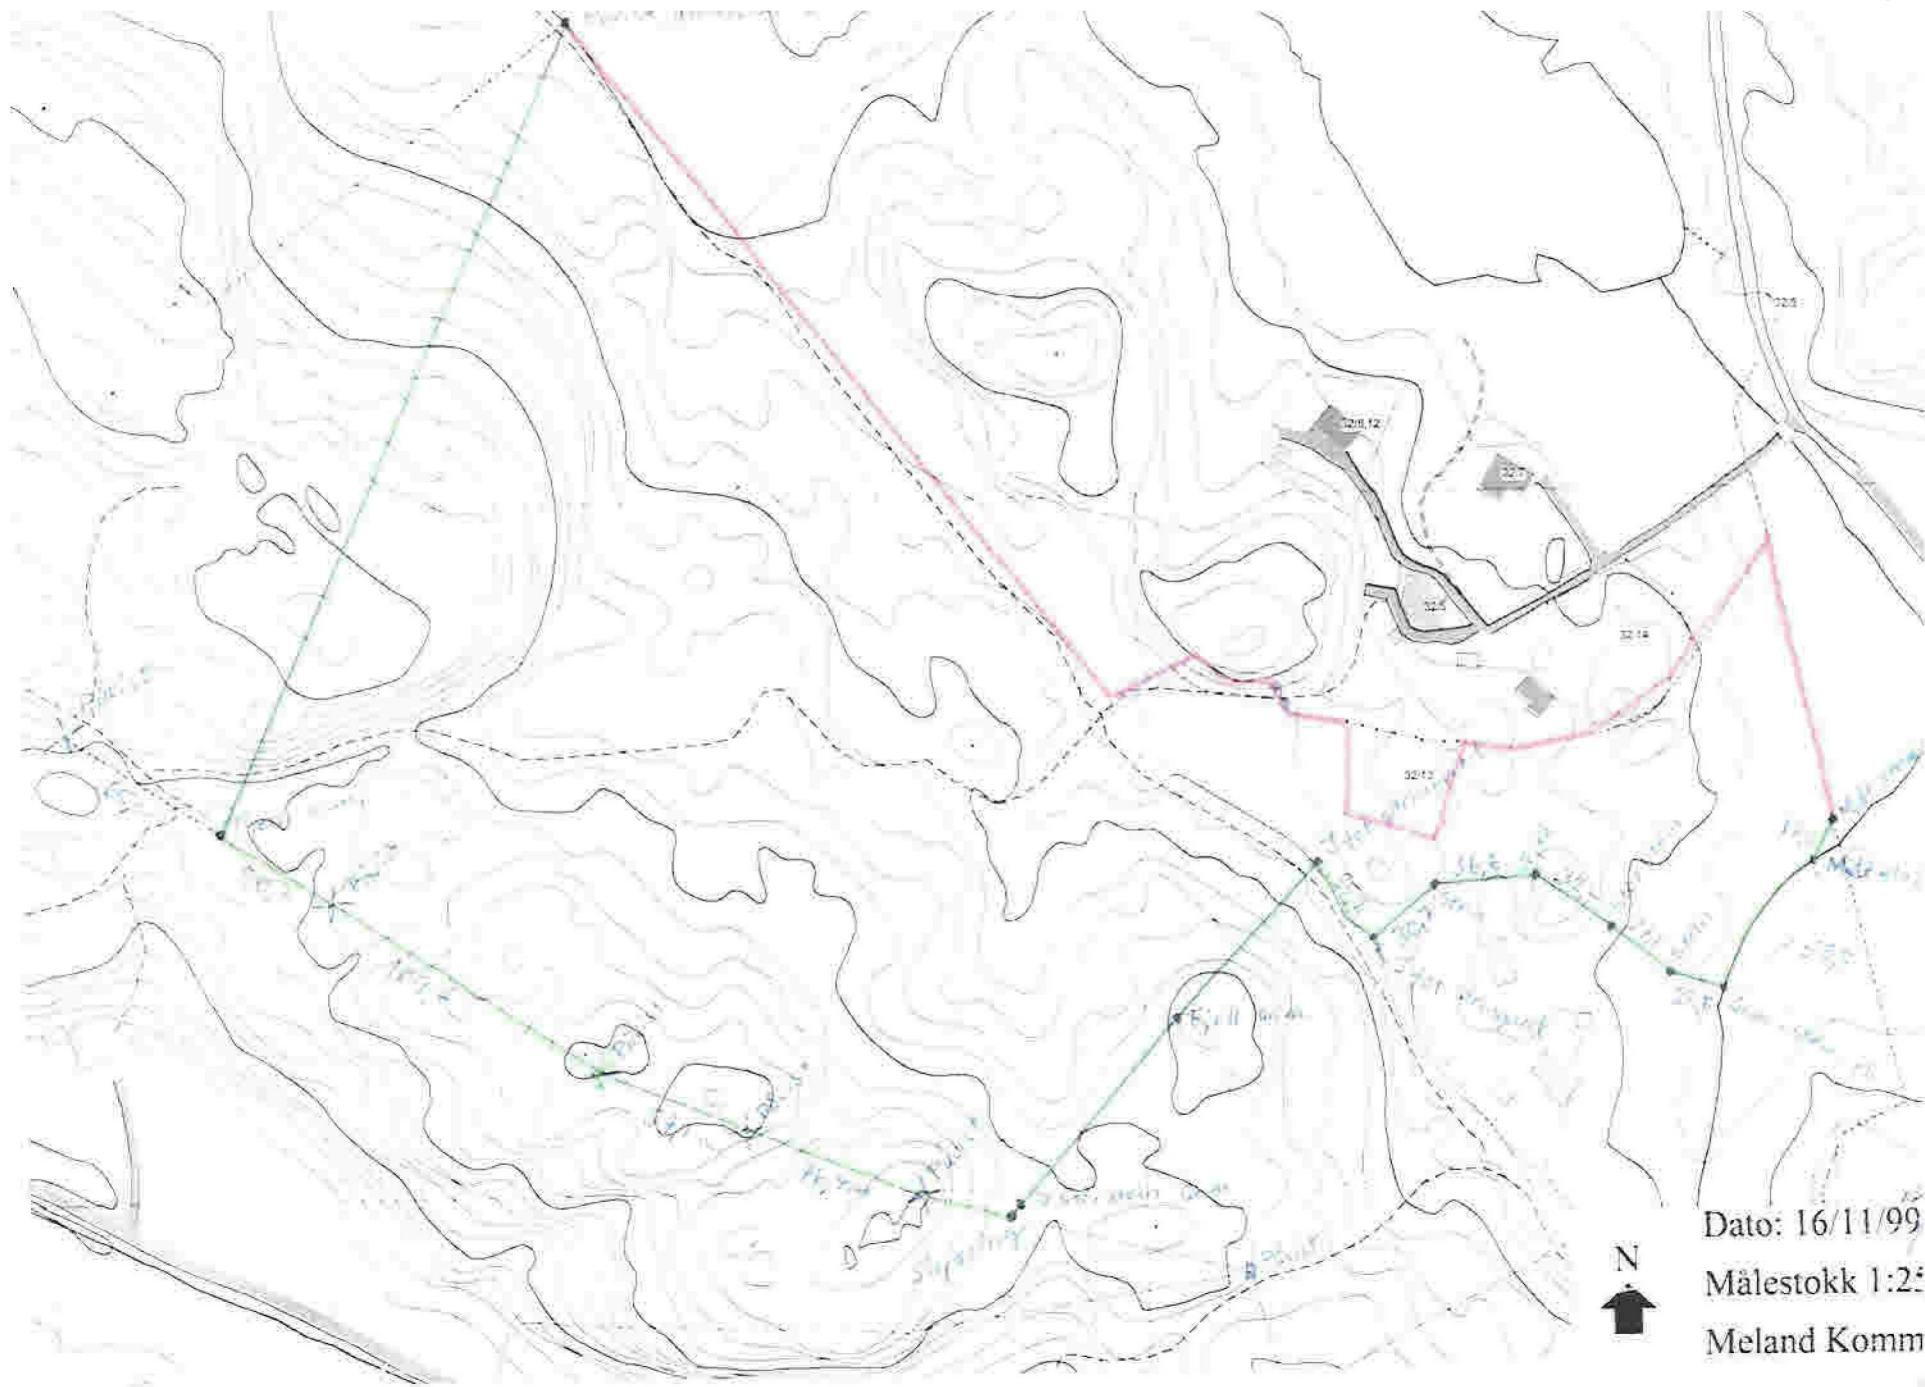

Dato: 16/11/99  
Målestokk 1:25  
Meland Komm



N  
15.04.2021  
Mittastokk 1:500

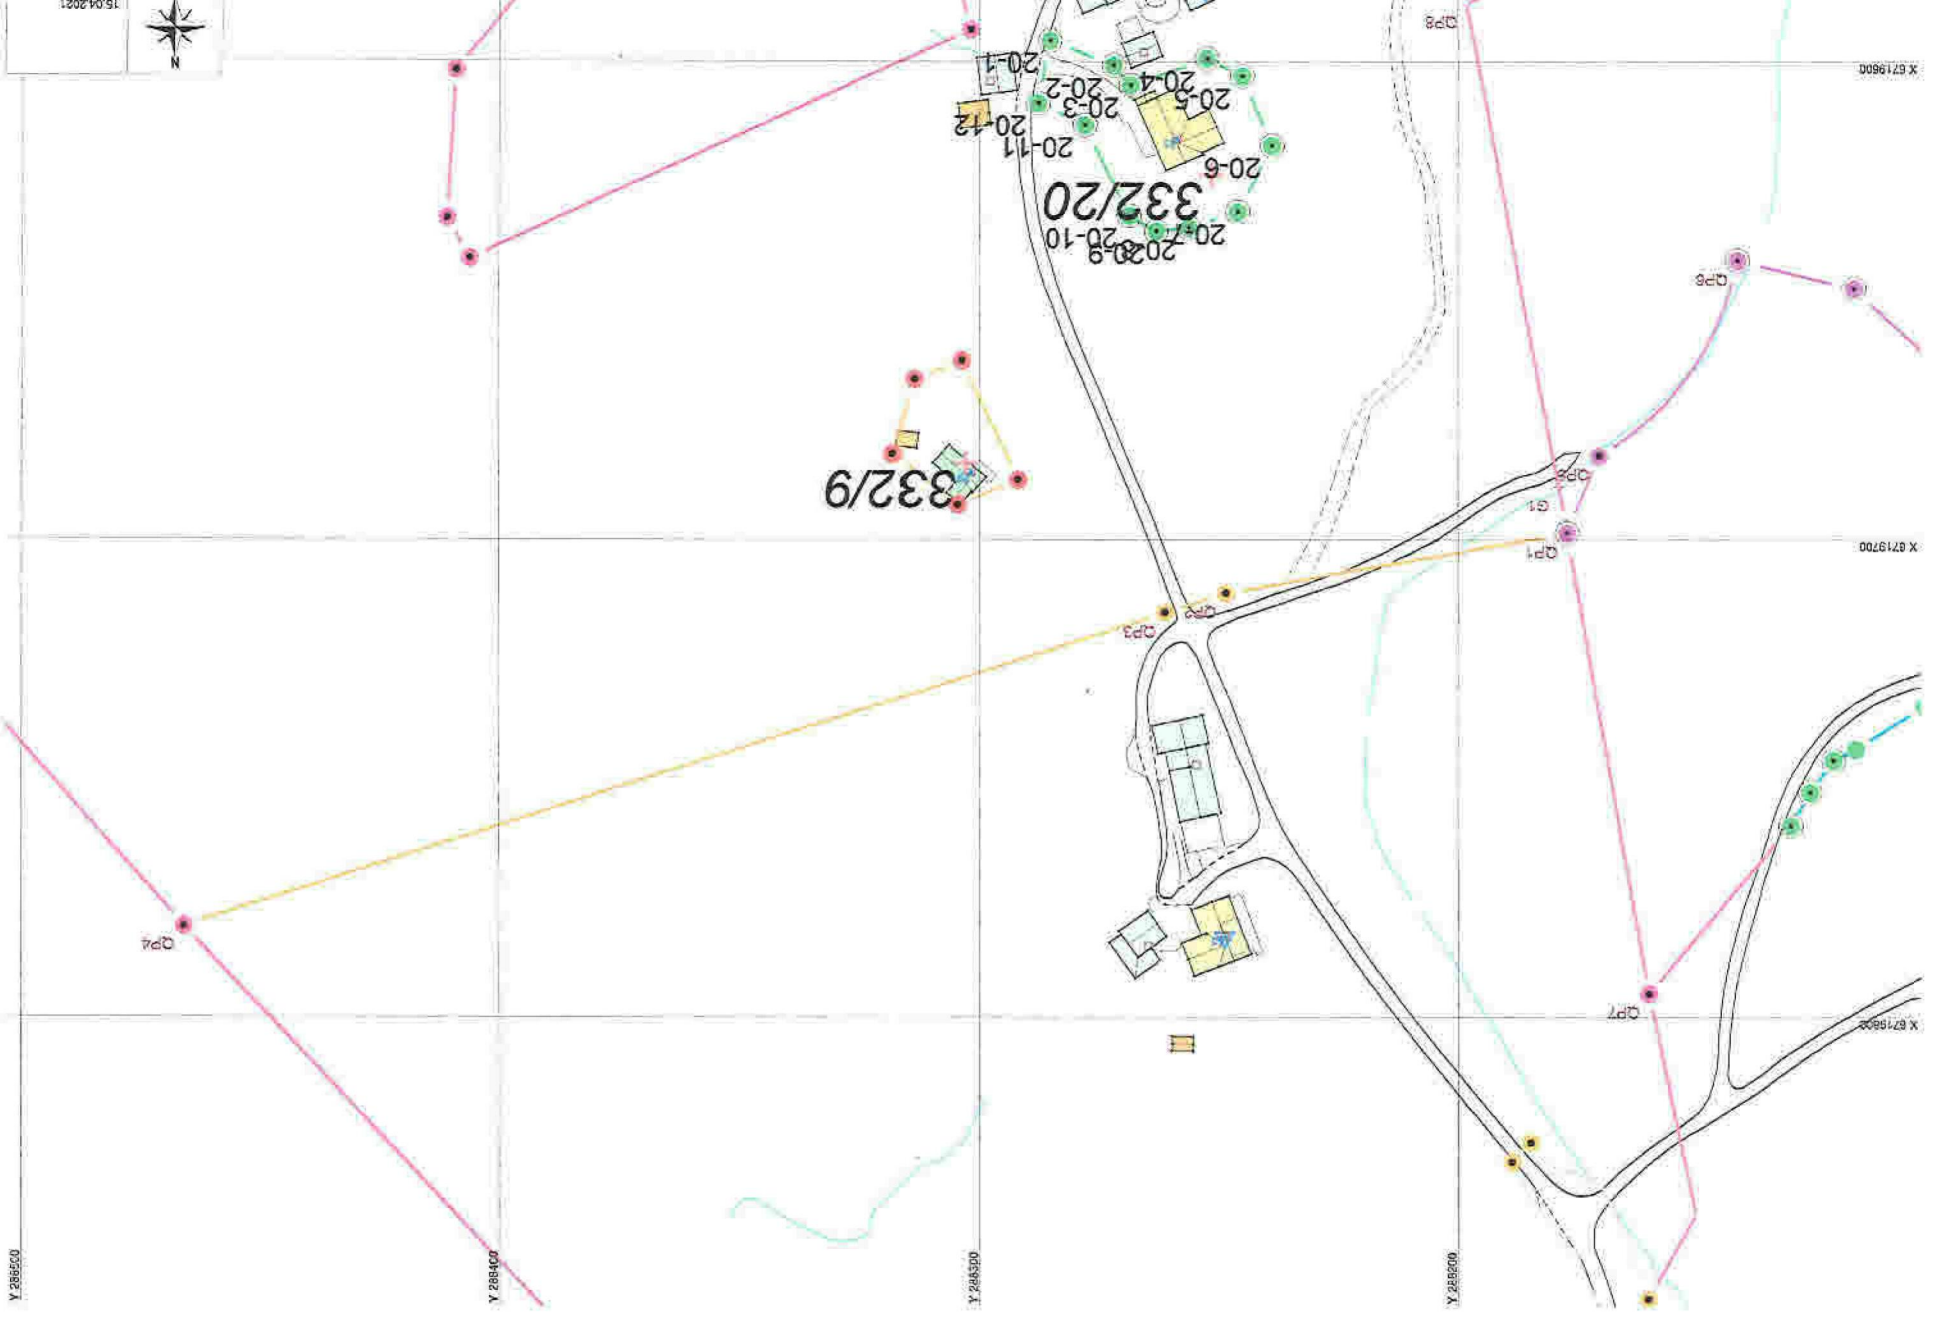

X 8719600

X 8719700

X 8719800

Y 288500

Y 288400

Y 288300

Y 288200



15/04/2021

332/20


20-1  
20-2  
20-3  
20-4  
20-5  
20-6  
20-7  
20-8  
20-9  
20-10  
20-11  
20-12

QP4

QP2

QP3

QP1

QP5

G1

QP6

QP7

QP8

QP9