


Fasadeliv			
PunktID	N-koord.	Ø-koord.	Høyde
H5	6730084,92	279513,77	
H6	6730079,06	279520,85	
H7	6730068,53	279512,10	
H8	6730074,41	279505,02	
MØNE1	6730076,37	279506,30	6,93
MØNE2	6730079,83	279509,21	6,91
MØNE3	6730083,30	279512,06	6,91

Fasadeliv			
PunktID	N-koord.	Ø-koord.	Høyde
H9	6730086,07	279516,00	
H10	6730093,91	279522,52	
H11	6730088,67	279528,82	
H12	6730080,84	279522,32	
MØNE4	6730088,30	279517,38	6,94
MØNE5	6730092,19	279520,60	6,93

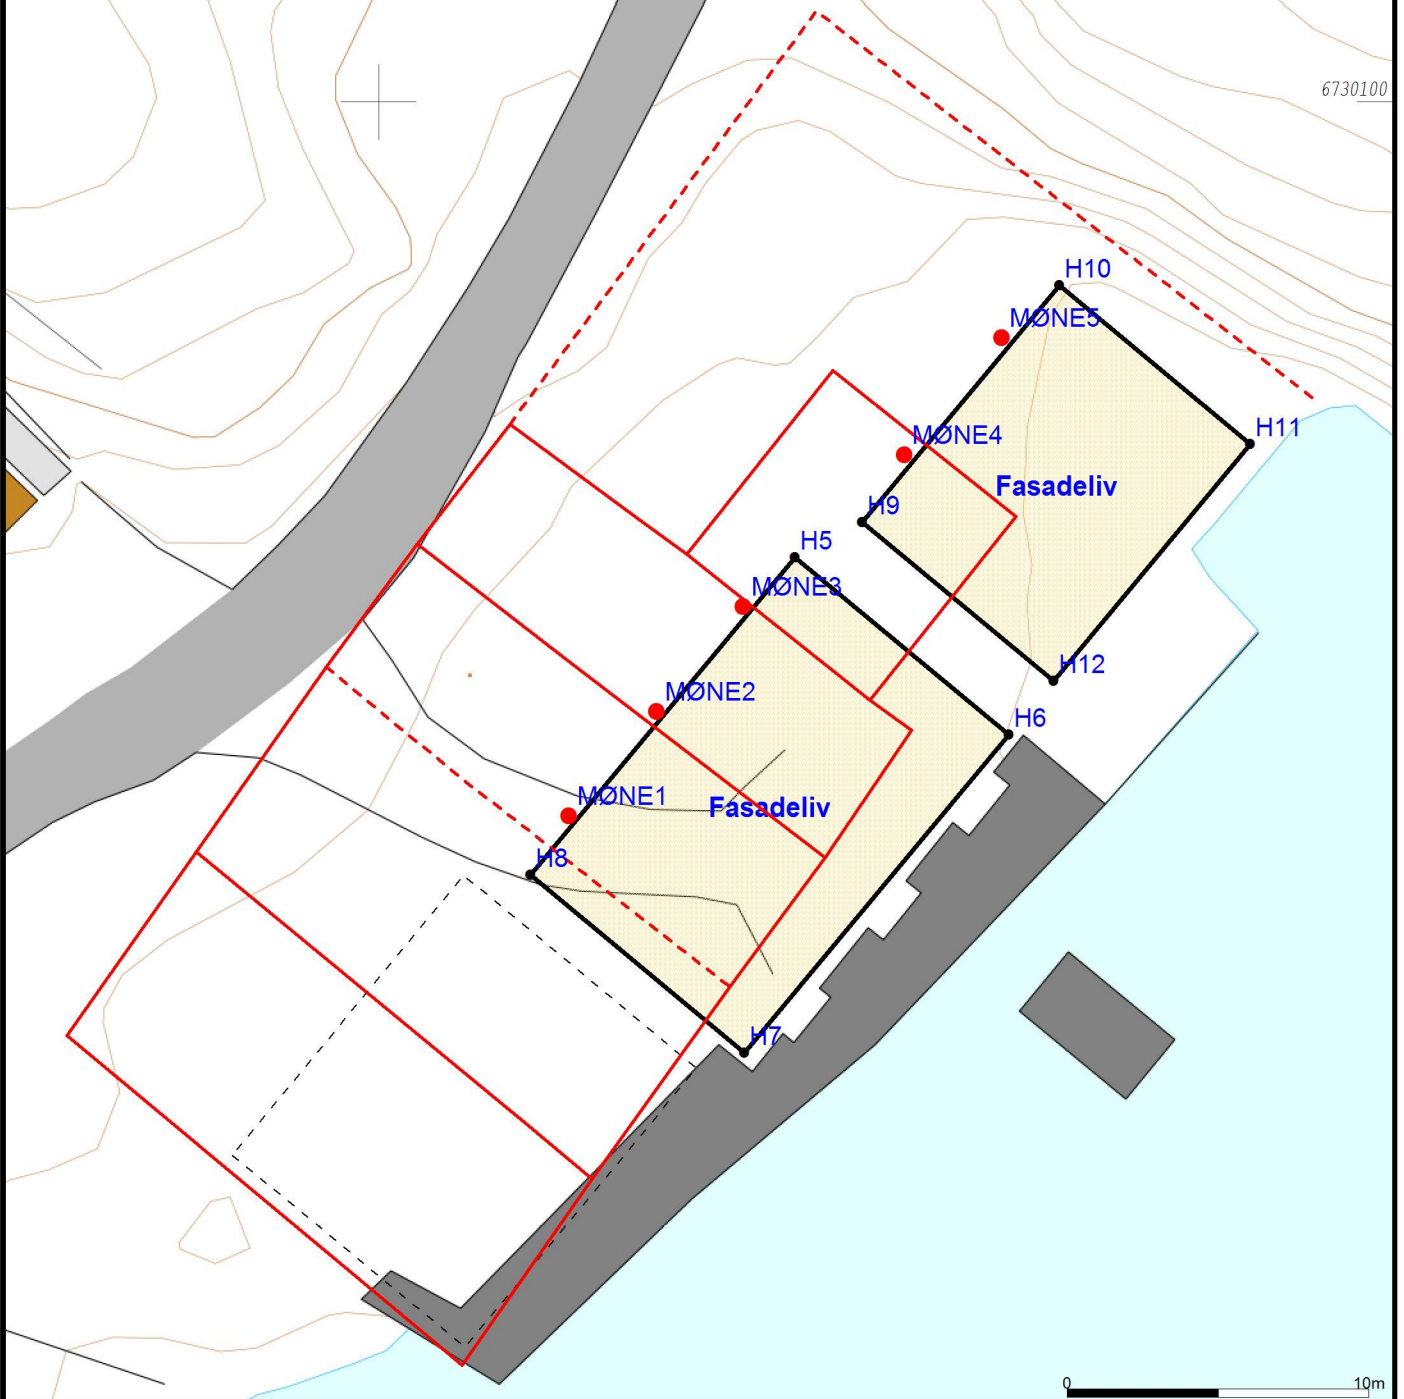

Telefon 905 12 583Mail: helge@vestoppmaaling.no



Vest Oppmåling AS
5281 Valestrandsfossen
helge@vestoppmaaling.no



Dato: 2019.02.21
Sign: Even

Radøy 43/4 m/fl

Målestokk
1:250