


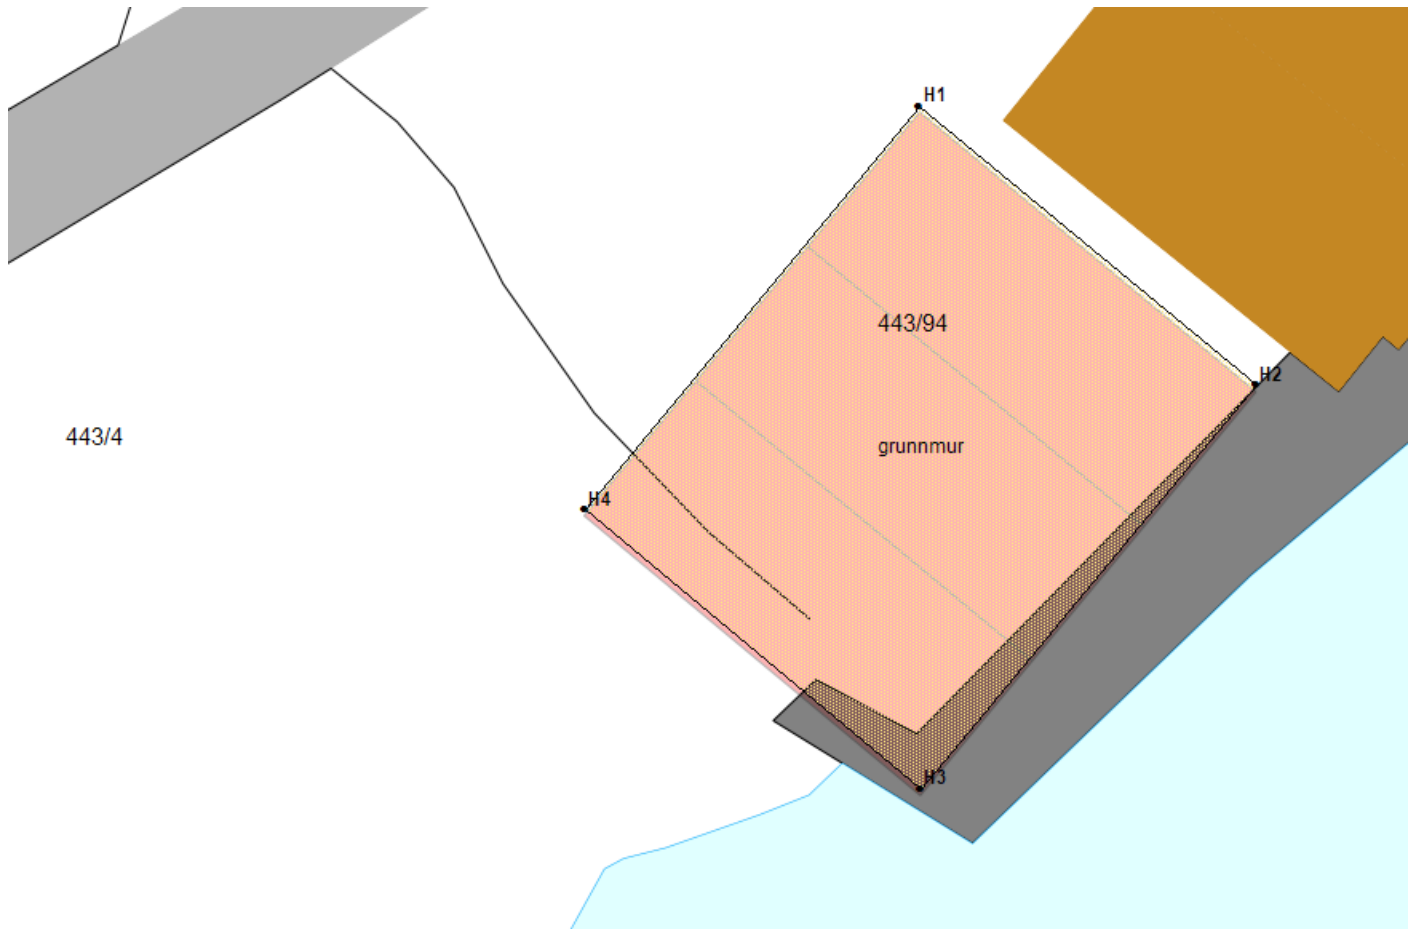

Alver, gnr 443 bnr 94
Innmålt grunnmur

23.02.2020



PunktID	N-koord.	Ø-koord.	Høyde
H1	6730074,40	279502,81	2,01
H2	6730068,03	279510,50	2,04
H3	6730058,79	279502,82	2,02
H4	6730065,17	279495,14	2,01