


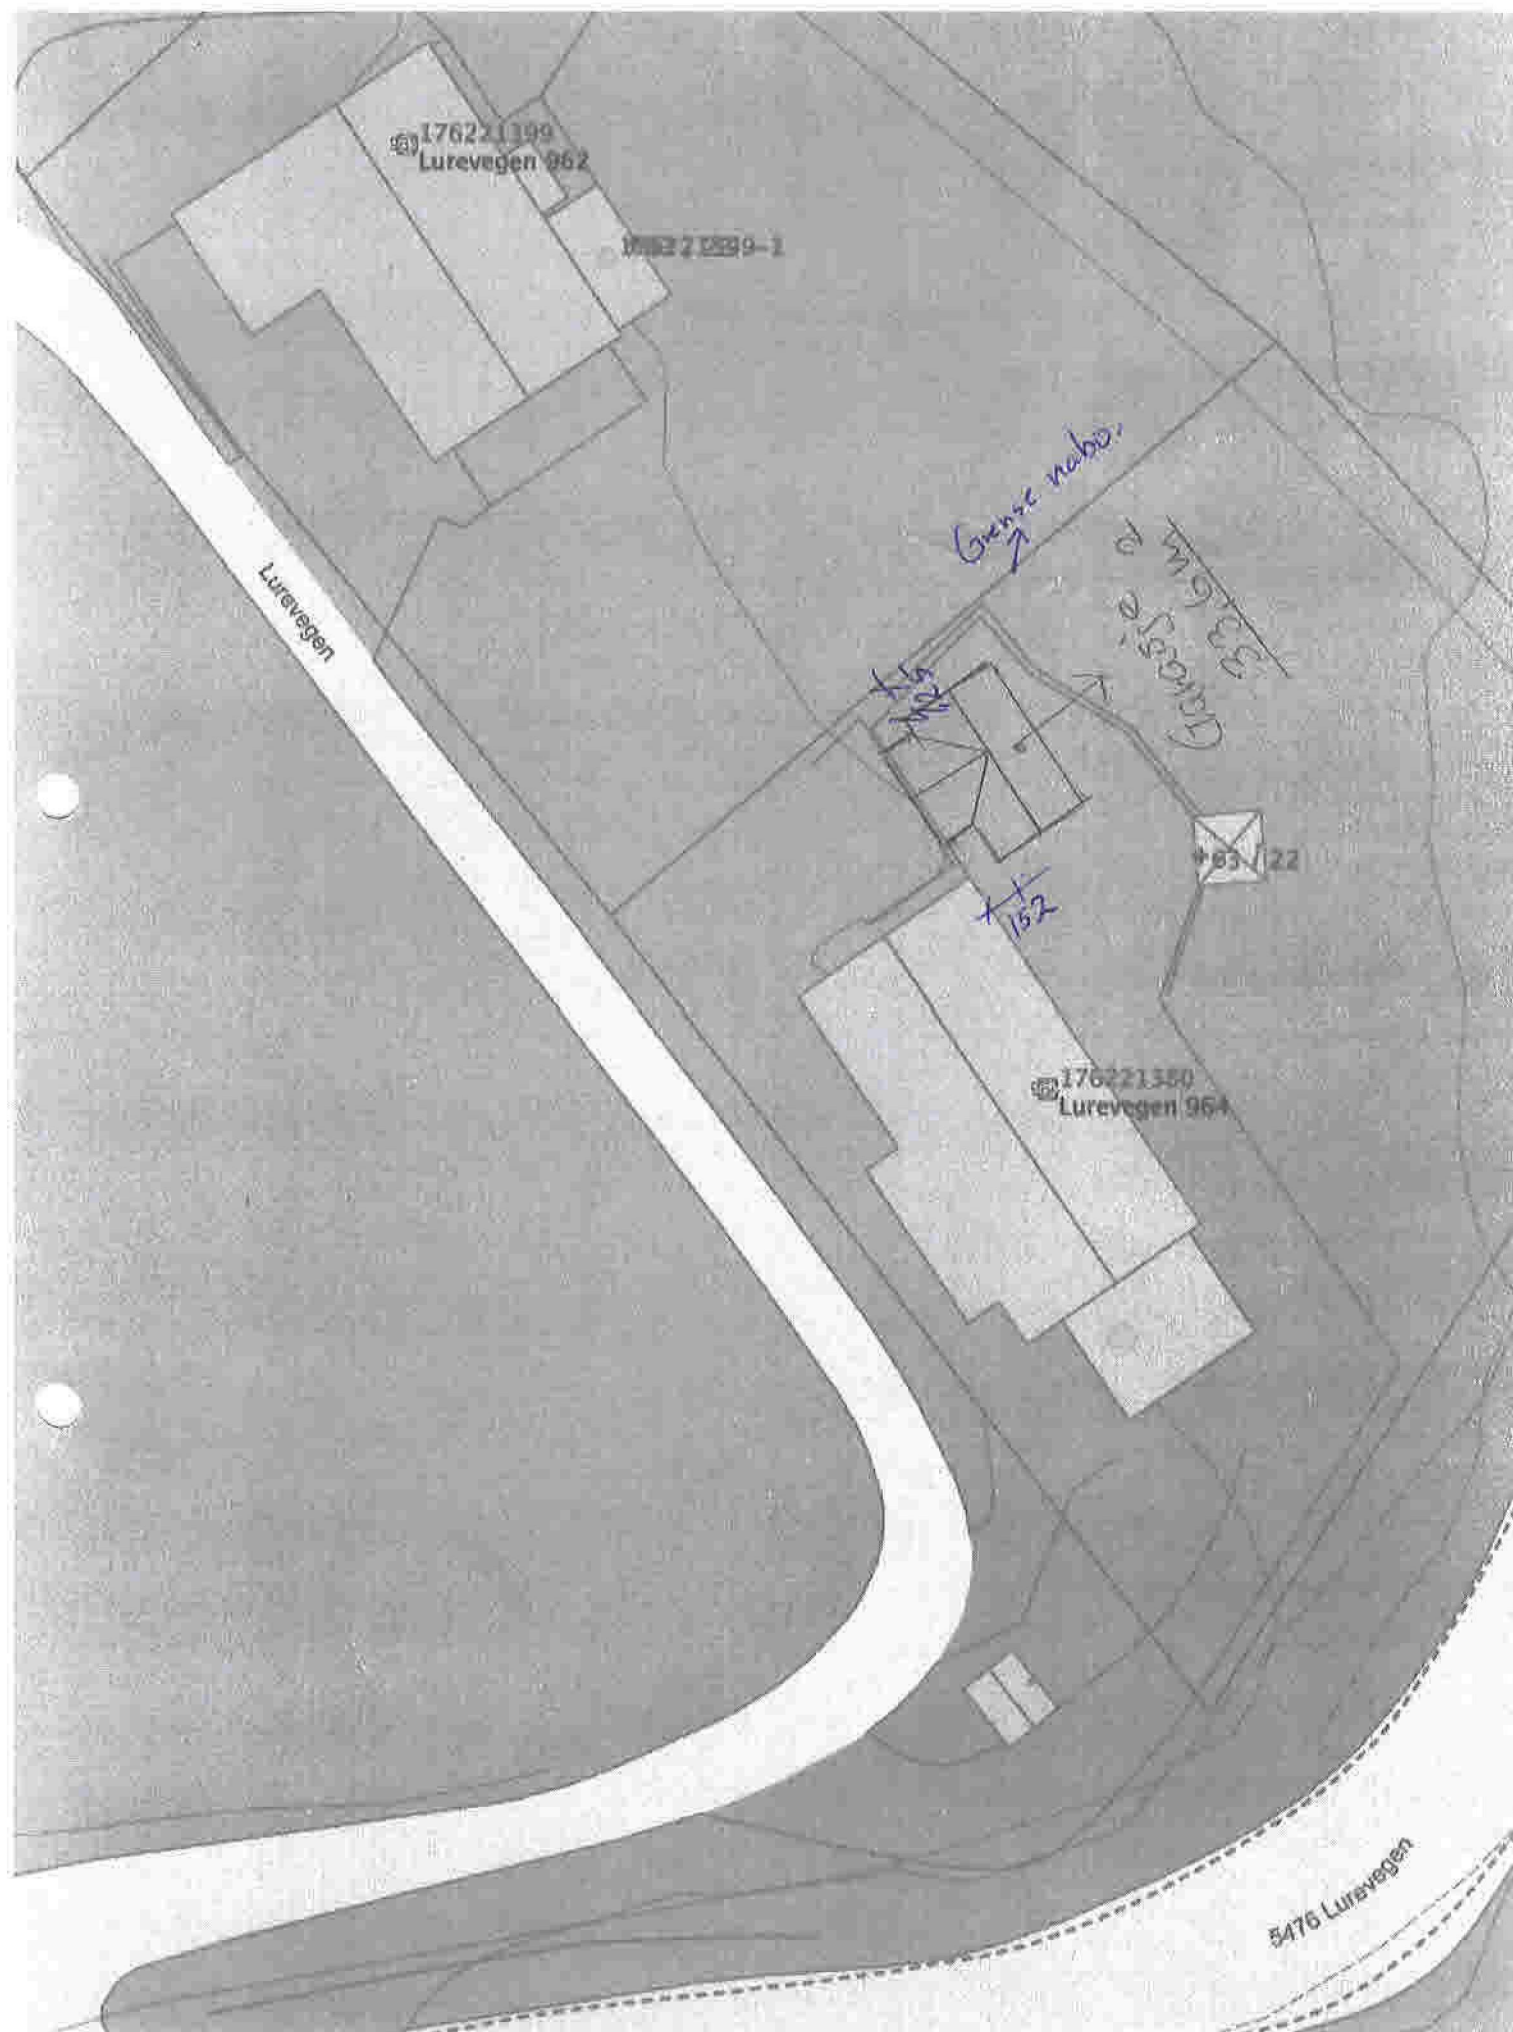

Kare Nese Lurevegen 964 mob. 96633983