


Y 279450


Y 279400

Y 279350

X 6725000

X 6724950

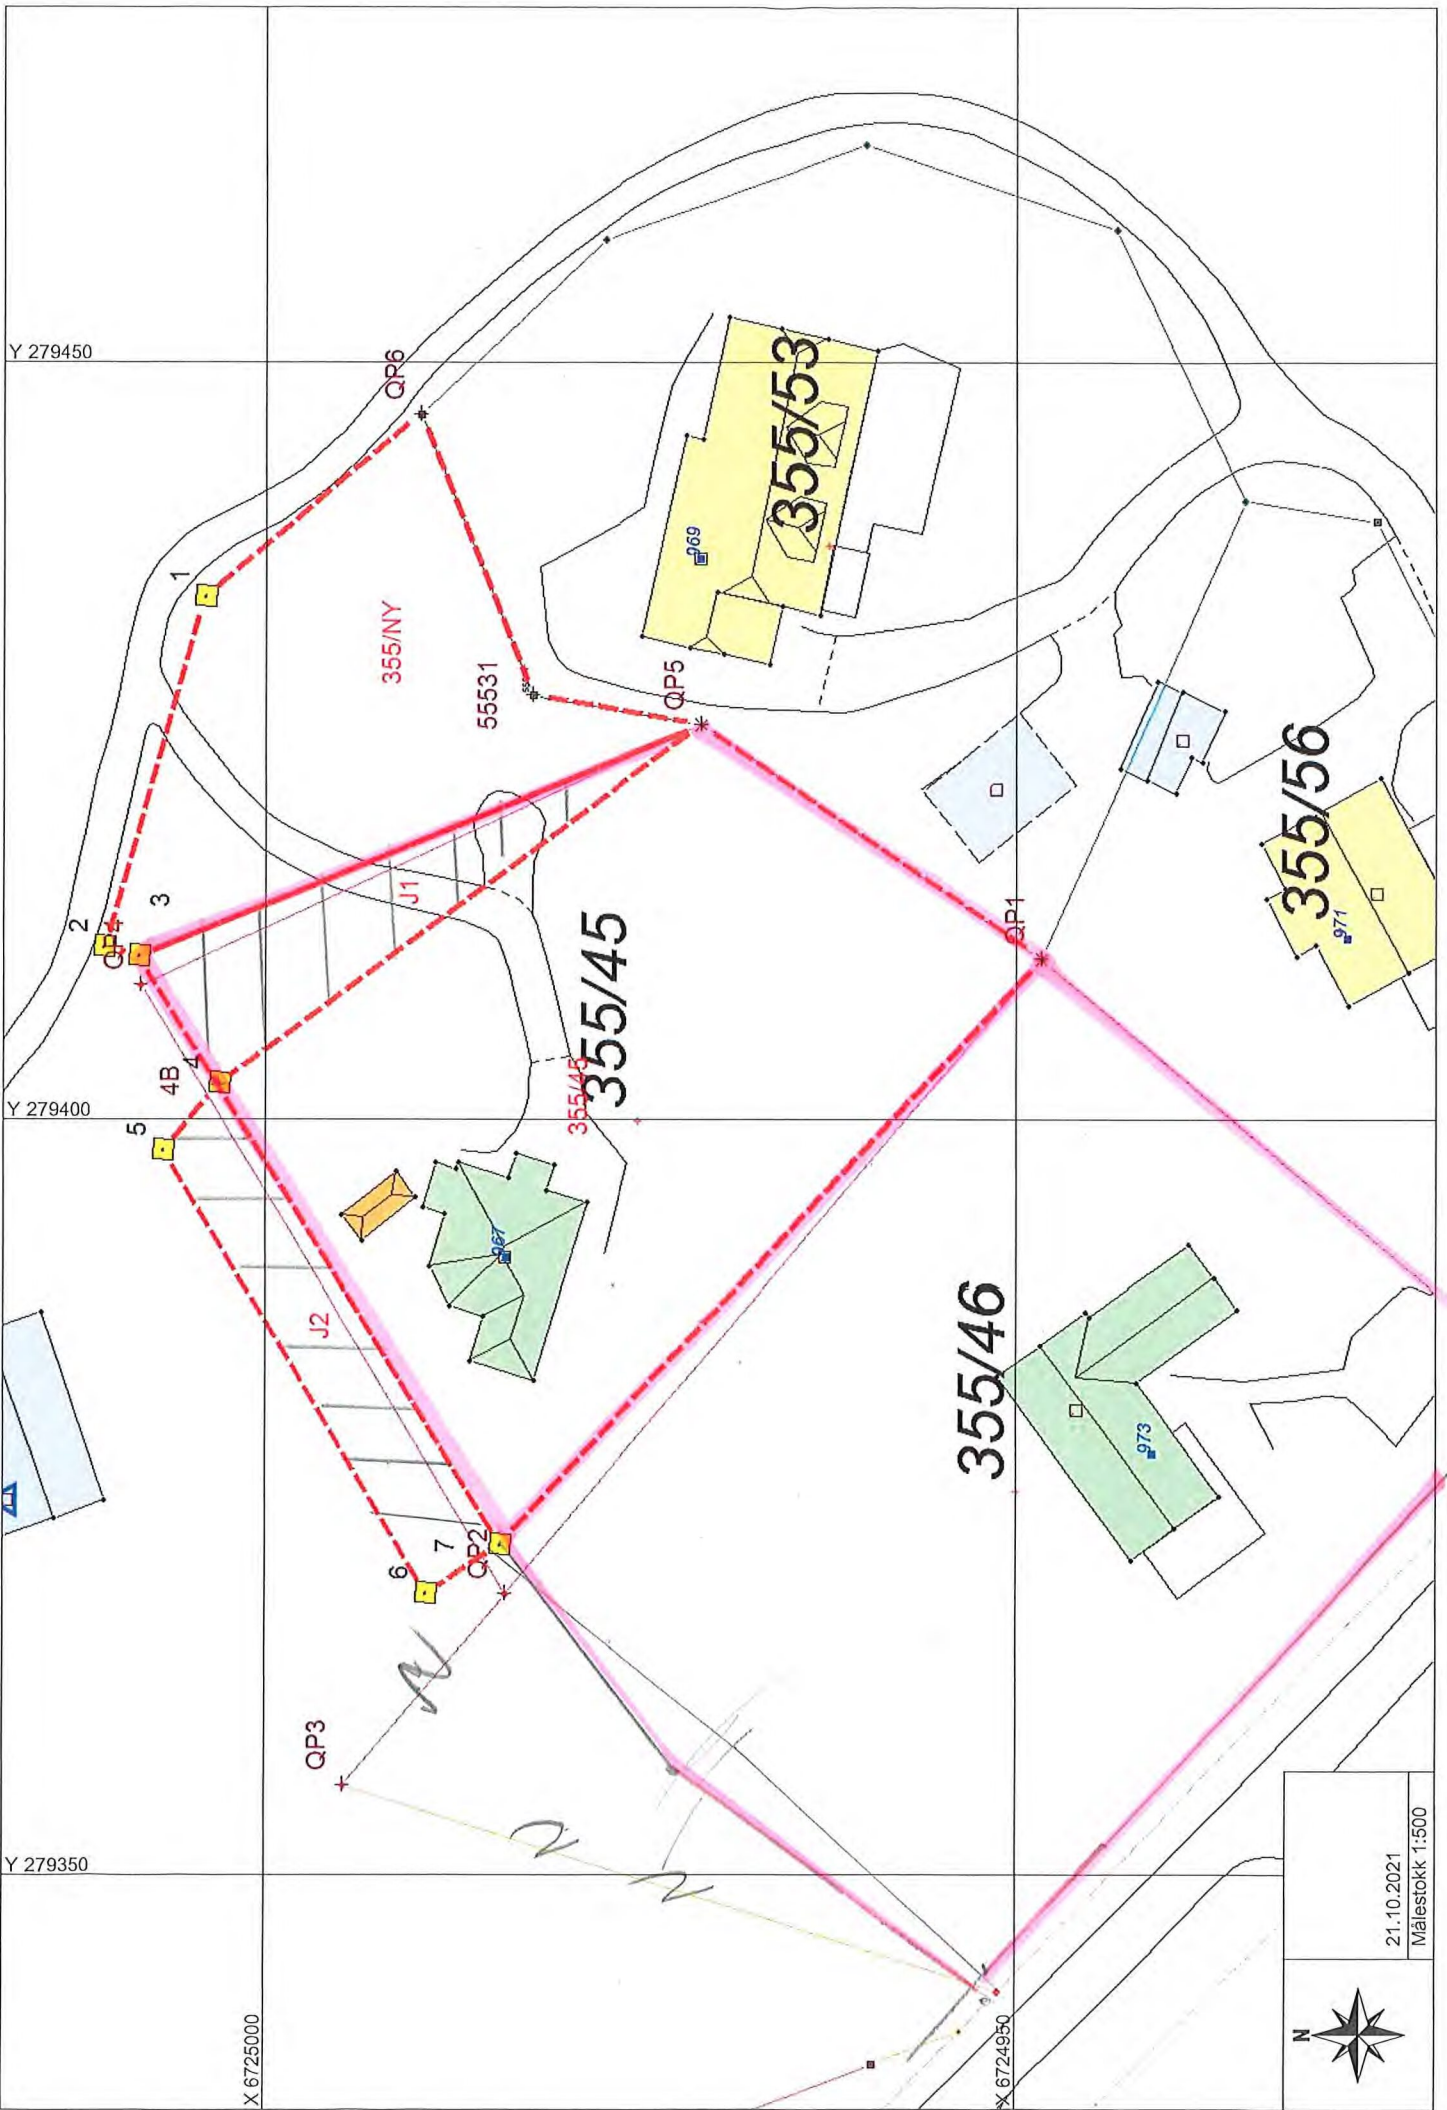

	21.10.2021 Målestokk 1:500
---	-------------------------------