


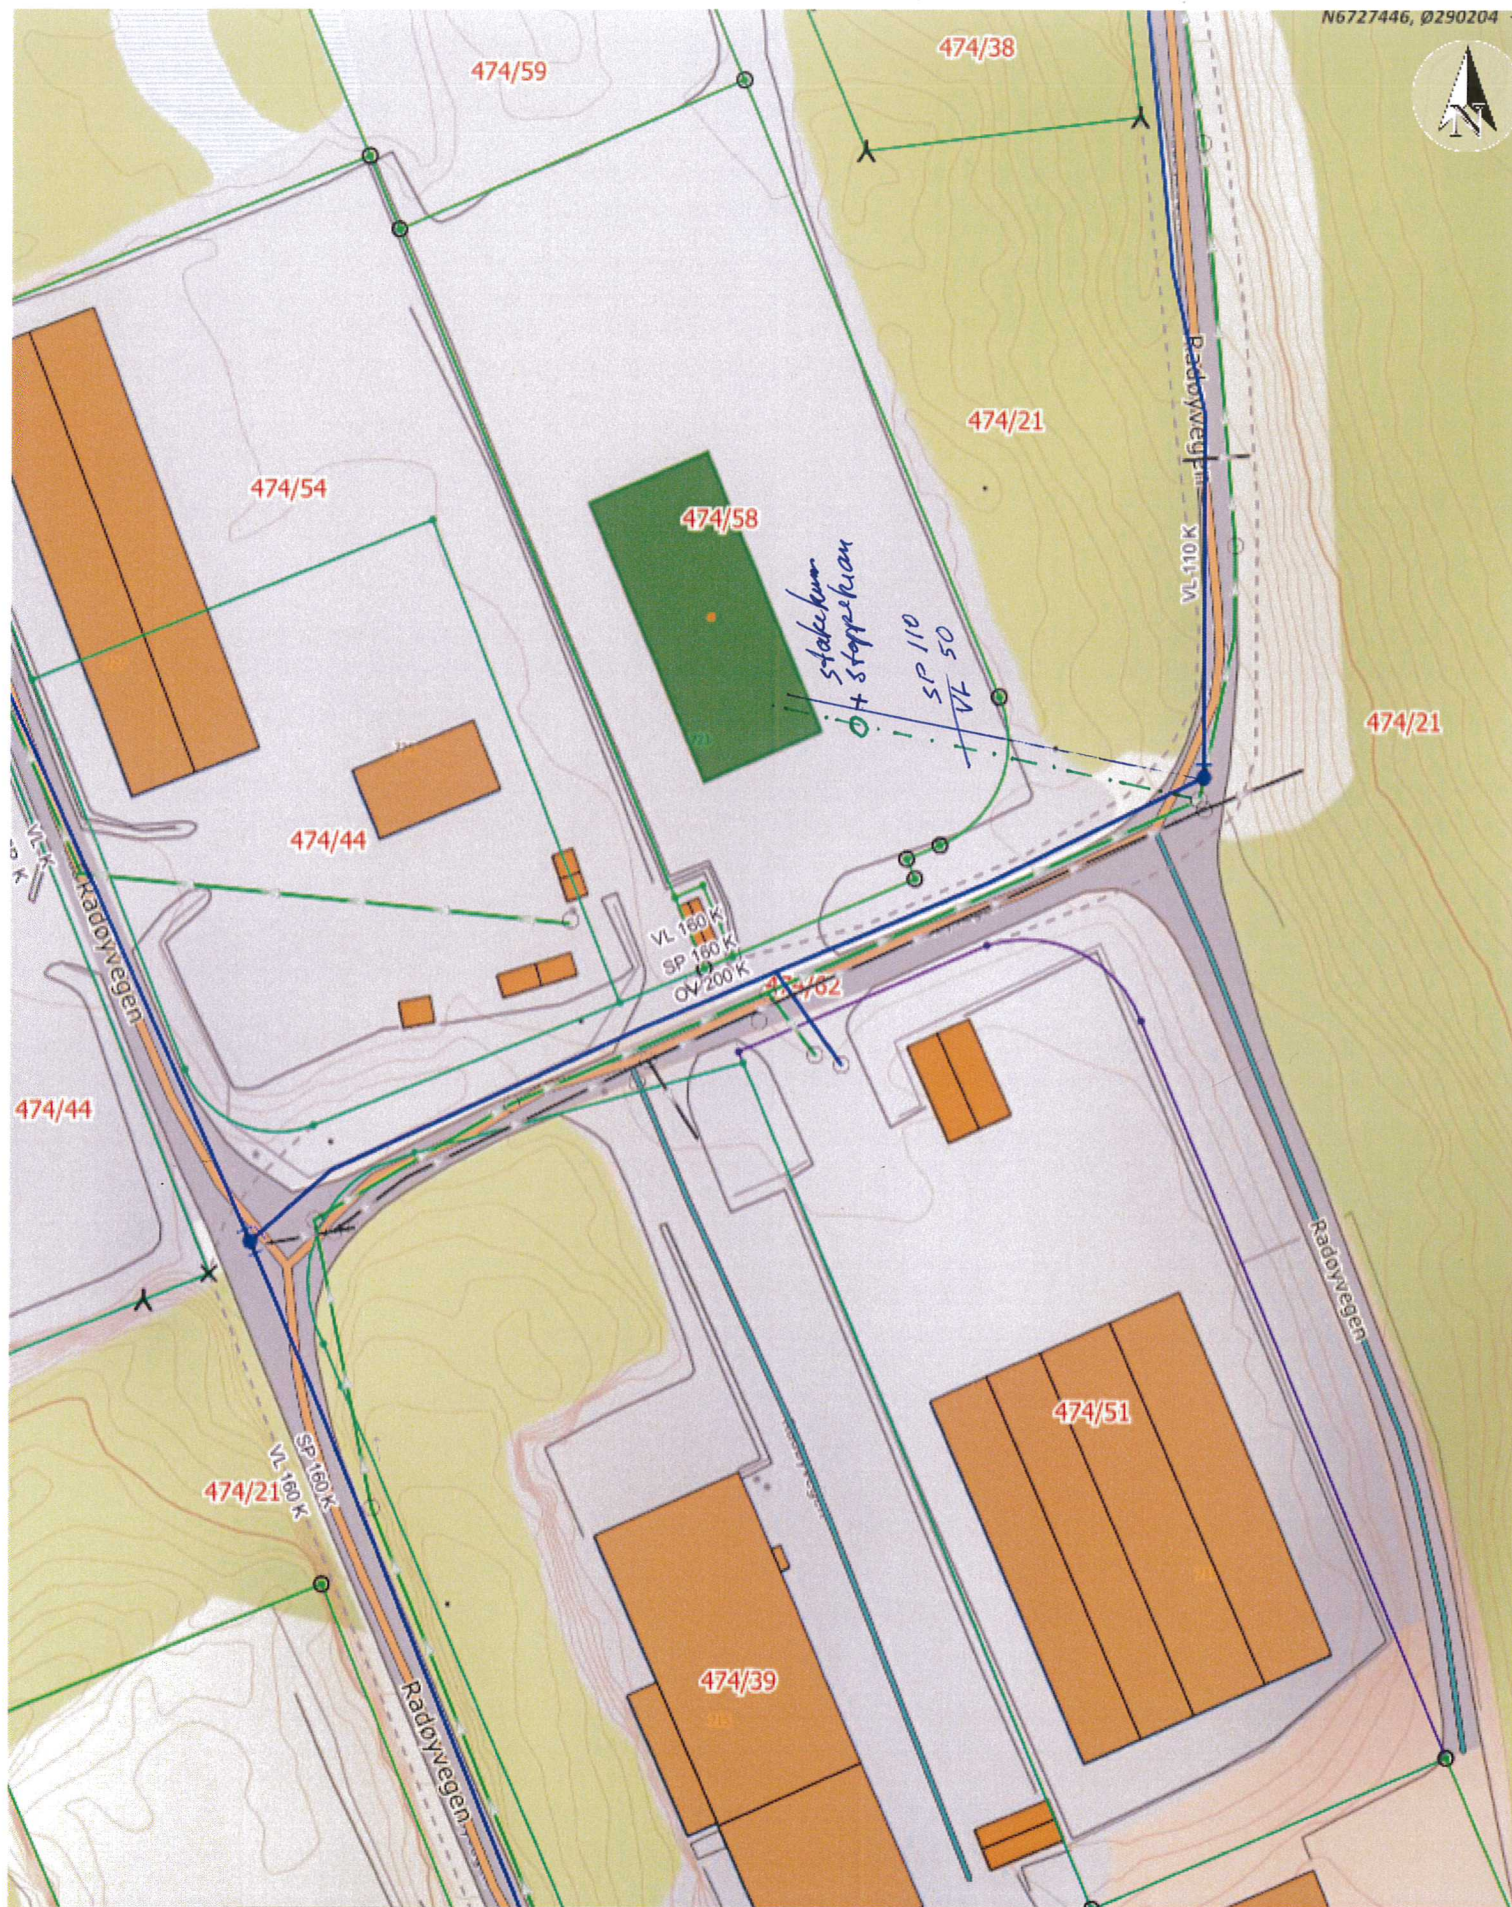

Situasjonskart 474/56
474/58
Plastinvent

NHdigi.no

Dato: 21-10-2021

474/57
Målestokk: 1:875

30m