


Search for content in selected sources

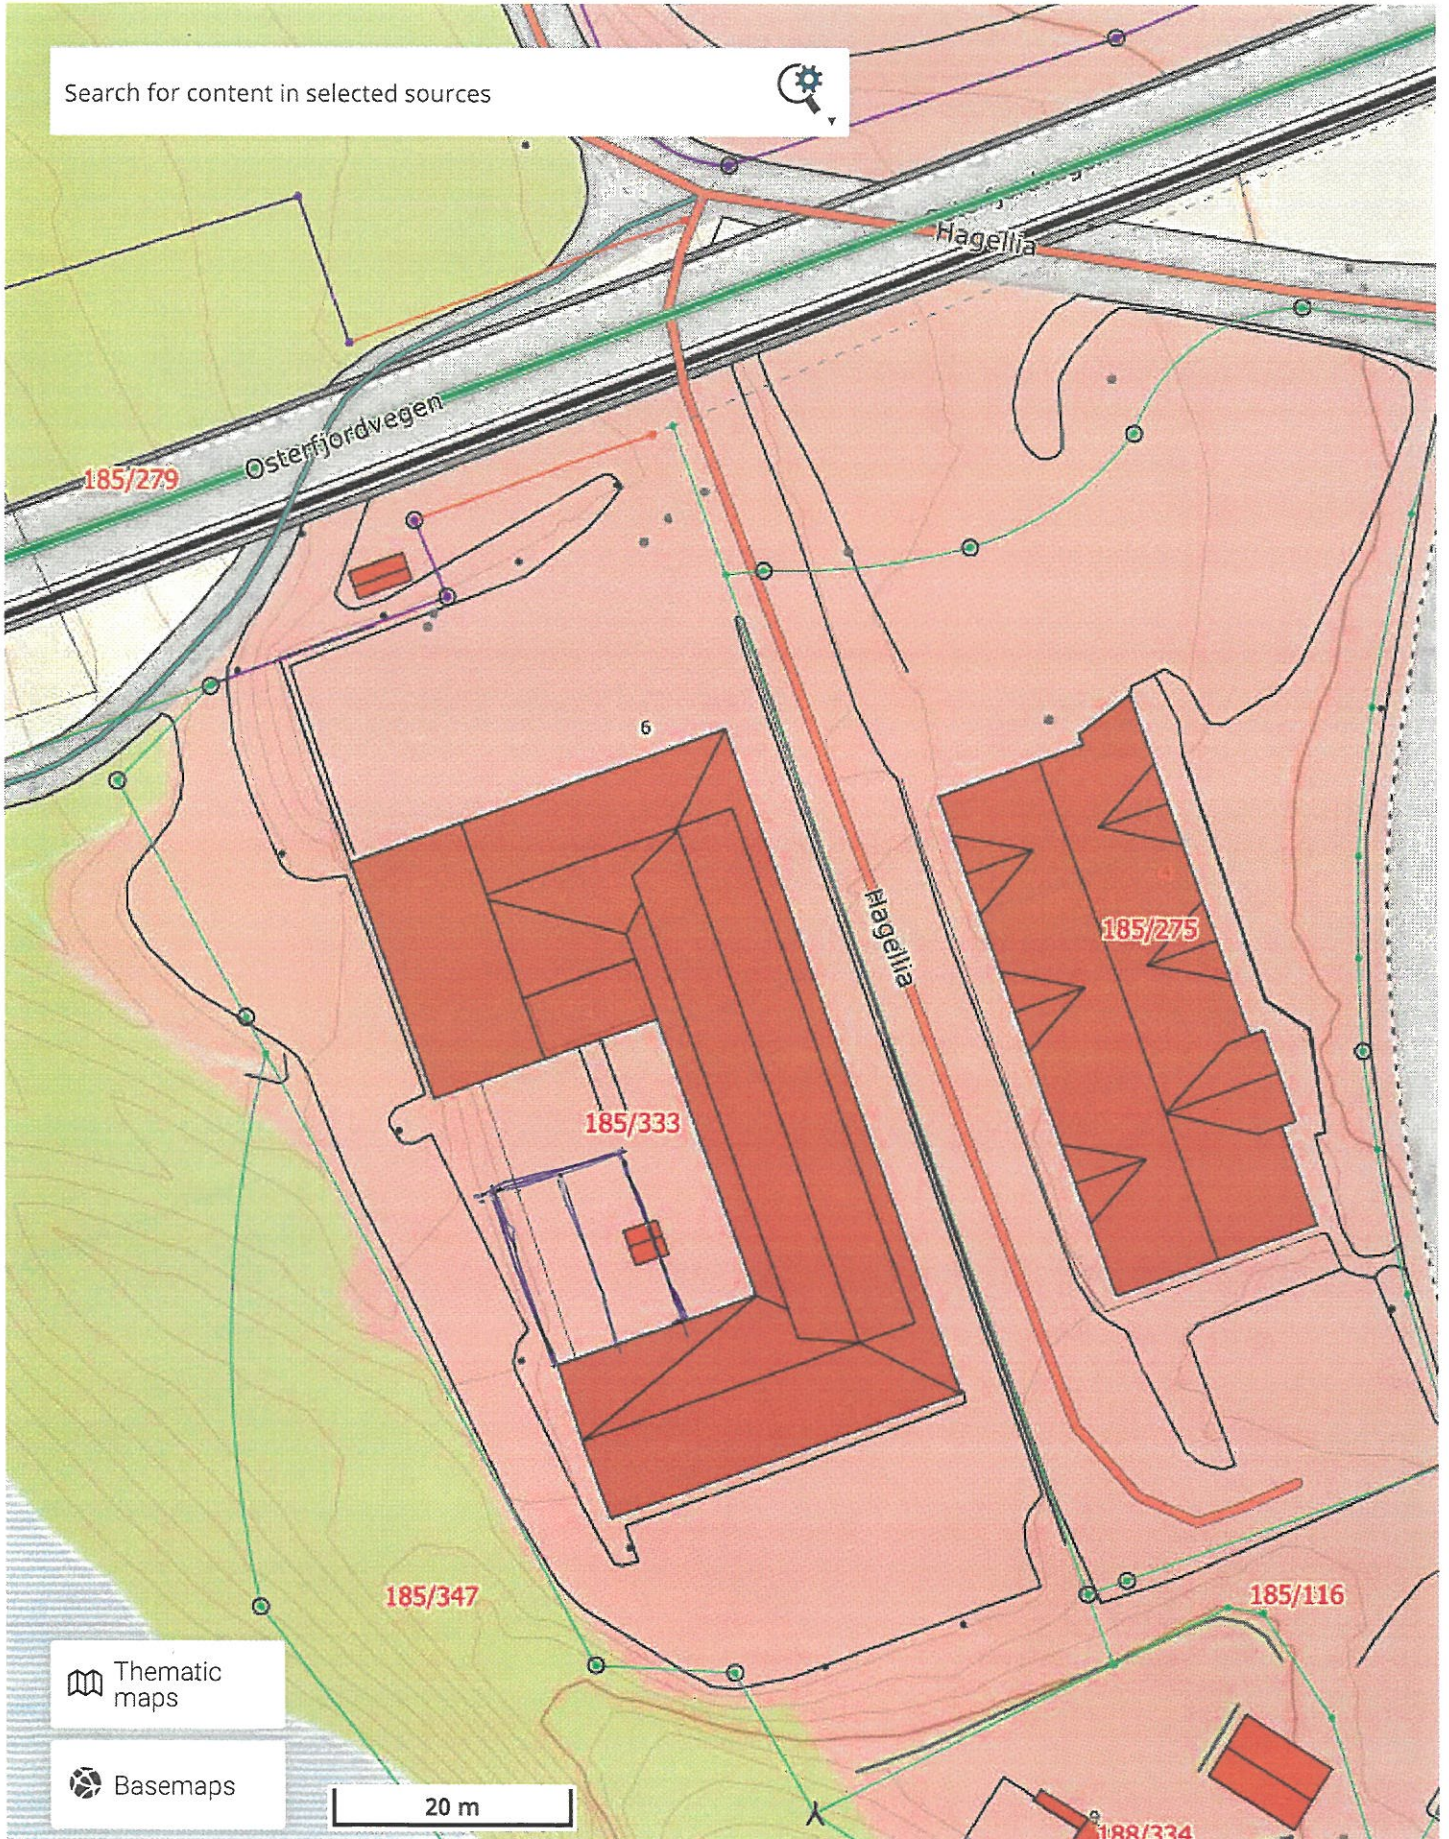

Thematic maps

Basemaps

20 m

EPSG:32632 N: 6717744 E: 295924

Scale 1 : 625